

11-00-015-A

11-00-015-00


11-00-015-00

LOT 26  
LOT 15

Frank VGS  
Menci  
Vol. 745 Pg. 727

APR 29 1977

APR 12 1977

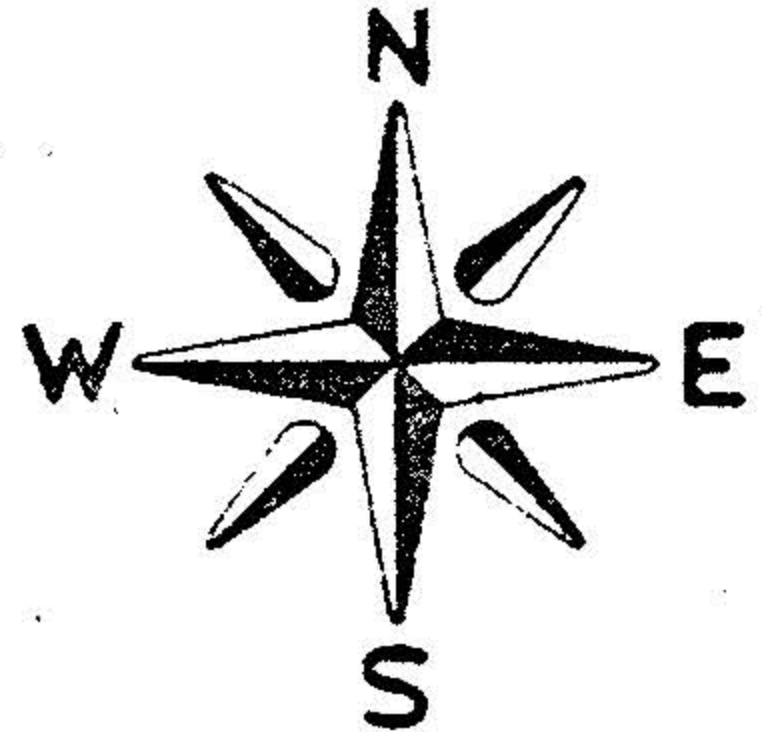

LEGEND  
○ I.P. Set  
● I.P. Found

S 84° 16' 19" E  
260.44' 200.03'

4.146 Ac.

Total Ac.  
4.927

3.695 Ac.

Frank & Ann  
Keller  
Vol. 404 Pg. 115

Robert E. &  
Ethel Kennenberg  
Vol. 366 Pg. 393

N 5° 02' 51" E  
307.38'

0.781 Ac.

N 4° 14' E  
805.57'

804.07'  
S 4° 14' W

South Line of  
Lot 26

N 84° 42' W  
47.87'

South Line of  
Lot 15

55'

55'

55'

224.00' 200.00'

N 84° 42' W

S.R. 82 ELYRIA TWINSBURG RD.

REED RD.



LOT NO: 26, 15	Tr. or Sec:
TOWNSHIP: EATON	
COUNTY: LORAIN	STATE: OHIO
OWNER: F. J. ULLRICH	
DATE: MARCH, 1977	SCALE: 1" = 200'
JOHN A. BAMBECK & ASSOCIATES, INC. 991 MEDINA ROAD, MEDINA, OHIO, 44256 Telephone: 216-239-1001	
PROJECT NO. 77-179	