

11-00-016-A

#17652

11-00-016-000-



LAUNDON · SIMON · CAHL & ASSOC. INC.  
CONSULTING ENGINEERS & SURVEYORS  
219 COURT ST. ELYRIA, OHIO 44035

SURVEY FOR:

FRANKS

1987

APPROVED  
FOR N.C.O.  
MADEP.

DATE 9-4-87

STATE 11-00-016  
PAGE 11-00-016  
BY C. Francis  
VOID AFTER 17652

Orig. Lot 16

City of

Date of Survey 4/78

DATE 9-4-87

Orig. Sec

Village of

Dwn. by R.G.S.

CHkd. by C.V.

Tract

County of LORAIN

Job No. 86-1537

F.B.


Township of EATON

State of OHIO

Printed AUG 12 1987



REVISED FOR BURKE  
AUG. 13, 1987 - PCL. N° 3

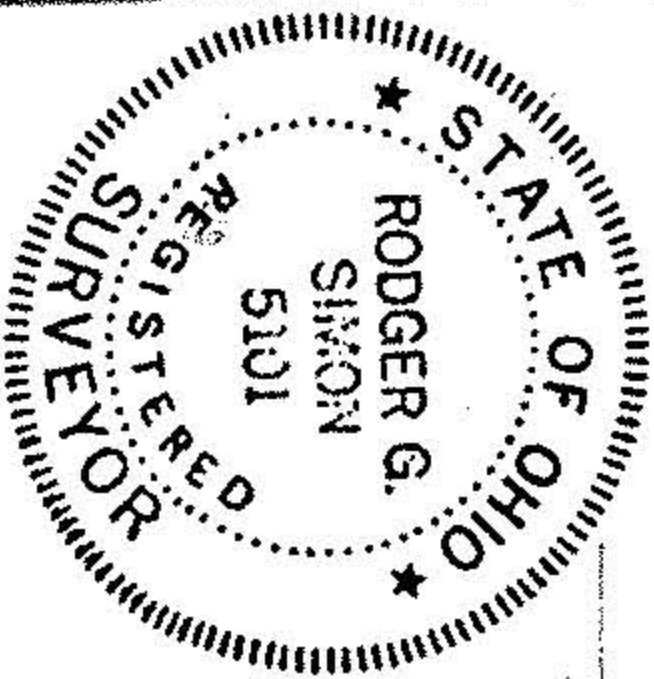

BENJAMIN L &  
RUTH A.  
MICHAEL  
V. 1146 P. 517

JAMES S. & LILY T. SAJ  
V. 1210 P. 717

CHARLENE E. KANUCH  
V. 1179 P. 62

JESSE & WILLA D. CONRAD  
V. 859 P. 300

N. 89° 14' E. 1493.87 R. & M. E

RMDR. of PCL. N° 1  
13.1199 AC.

N. 89° 14' E. 700.00'

PCL. N° 3  
4.0169 AC.

5.0° 10' W.  
250.0'

PCL. N° 2  
7.8650 AC.

5.89° 14' W. 1491.75 R. & M. E

1492.41' E

792.41'

5.0° 20' W. 729.68 R. & M.

229.66'

500.02'

O.L. 16  
O.L. 17

REED

RD. 50'

N. 0° 10' E. 729.64' R. & M.

1 P. 51  
250.0'

250.0'

1 P. 51  
250.0'

1 P. 51  
229.64'

1 P. 51

1 P. 51

