



LAUNDON, SIMON, CAHL & ASSOC. INC.
CONSULTING ENGINEERS & SURVEYORS
219 COURT ST. ELYRIA, OHIO 44035


SURVEY FOR:

FRANK WESTON

Orig. Lot 76	City of	Date OCT. 1986	Scale 1"=200'
Orig. Sec	Village of	Dwn. by R.G.S.	Chkd. by C.J.
Tract	County of LORAIN	Job No. 86-1537	F.B.
Township of EATON	State of OHIO	Printed	



REVISED FOR BURKE
AUG. 13, 1987 - PCL. N° 3
REVISED - 4.3.91

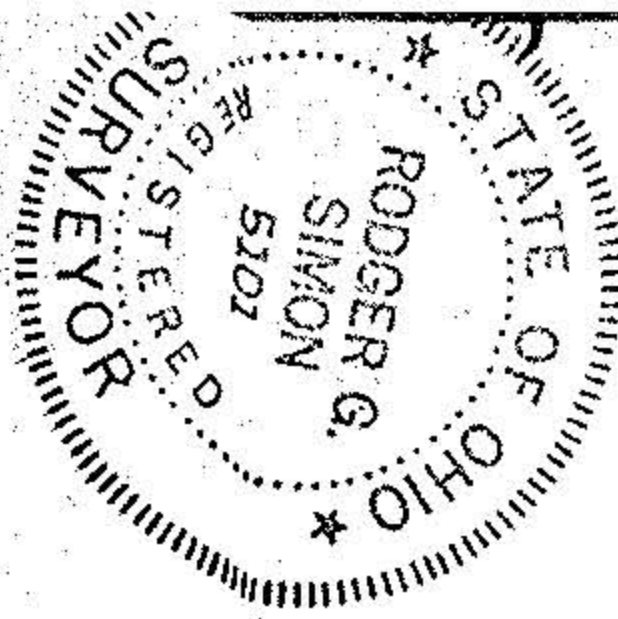

-010

JESSE & WILLA D. CONRAD
V. 859 P. 300

435.60

700.00

PCL. N° 4
4.0169 Ac.

N. 89° 14' E. 700.00'

PCL. N° 3
4.0169 Ac.

700.00

JAMES M. & SUSAN M. SMITH
V. 1411 P. 724

O.L. 16

O.L. 17

-026

~~CHARLENE E. KANUGH~~ RANDAL T & IRENE
~~V. 1199 P. 68~~ CUTLIP ORV. 91 P. 790

709.328

N. 89° 14' E. 1493.87 R.&M. E
793.87

RMDR. OF PCL. N° 1
9.1026 Ac.

250.00

1 P. 54

500.00

5.0° 10' W.

250.00

1 P. 54

PCL. N° 2
7.8650 Ac.

5.89° 14' W. 1491.75 R.&M. E

-072

1492.41' E

792.41

BENJAMIN L &
RUTH A.
MICHAEL
V. 1146 P. 517

1 P. 54

500.02

JAMES S & LILY T S A I
V. 1210 P. 717

5.0° 20' W. 729.68 R.&M.

1 P. 54

229.66'

19345

APPROVED
LORAIN CO.
MAP DEPT.

DATE 4-26-91

PAGE 11-00-016A B
CAROLYN
BY FRANCIS

VOID AFTER # 19345

REED

RD. 50'

N. 0° 10' E. 729.64 R.&M.

1 P. 54

250.00

1 P. 54

250.00

1 P. 54

229.64

1 P. 54