




LAUNDON . SIMON . CAHL & ASSOC. INC.
 CONSULTING ENGINEERS & SURVEYORS
 219 COURT ST. ELYRIA, OHIO 44035

SURVEY FOR:

ROBERT C. & DEBRA K. CRIGGER

Orig. Lot 24	City of	Date: JUNE 2 '87 Scale 1"=200'
Orig. Sec	Village of	Dwn. by R.G.S. Chkd. by C.J.
Tract	County of LORAIN	Job No. 87-1606 F.B.
Township of EATON	State of OHIO	Printed

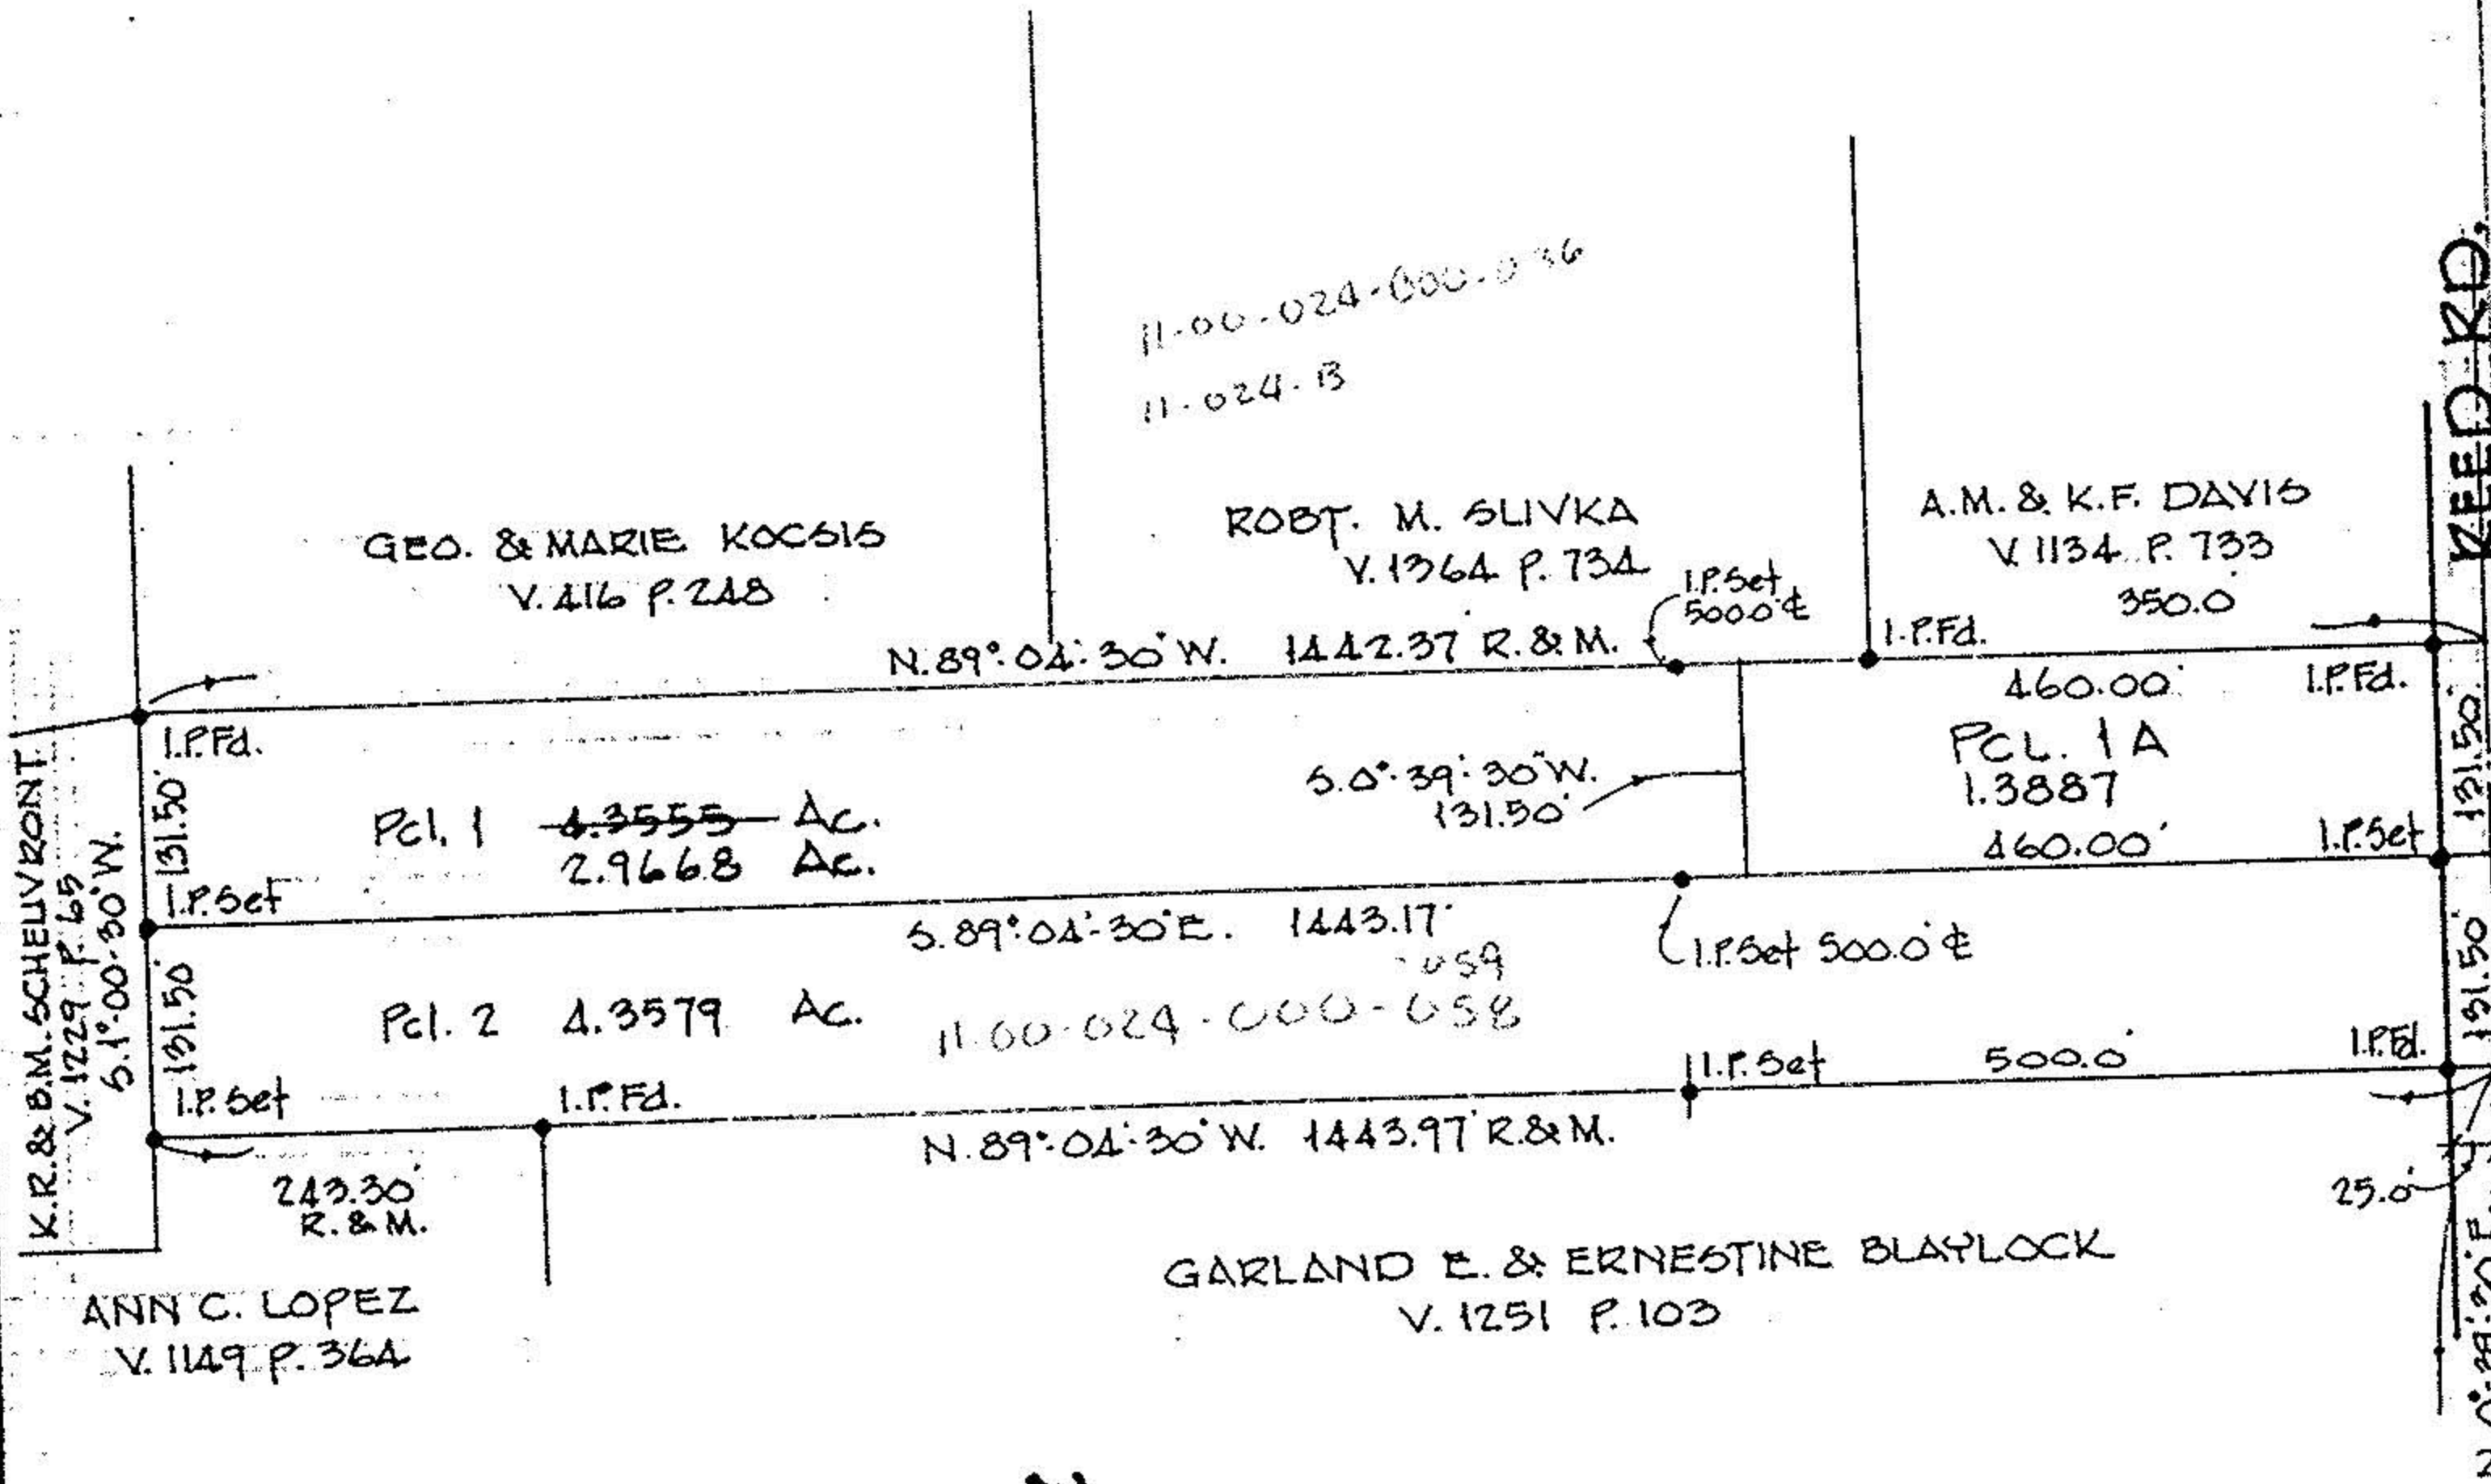

REV. 6-30-87
 REV. 6-10-87 - Pcl. 1A