




Scale: 1"=100'
 August 2001
 Job No. 1101-05

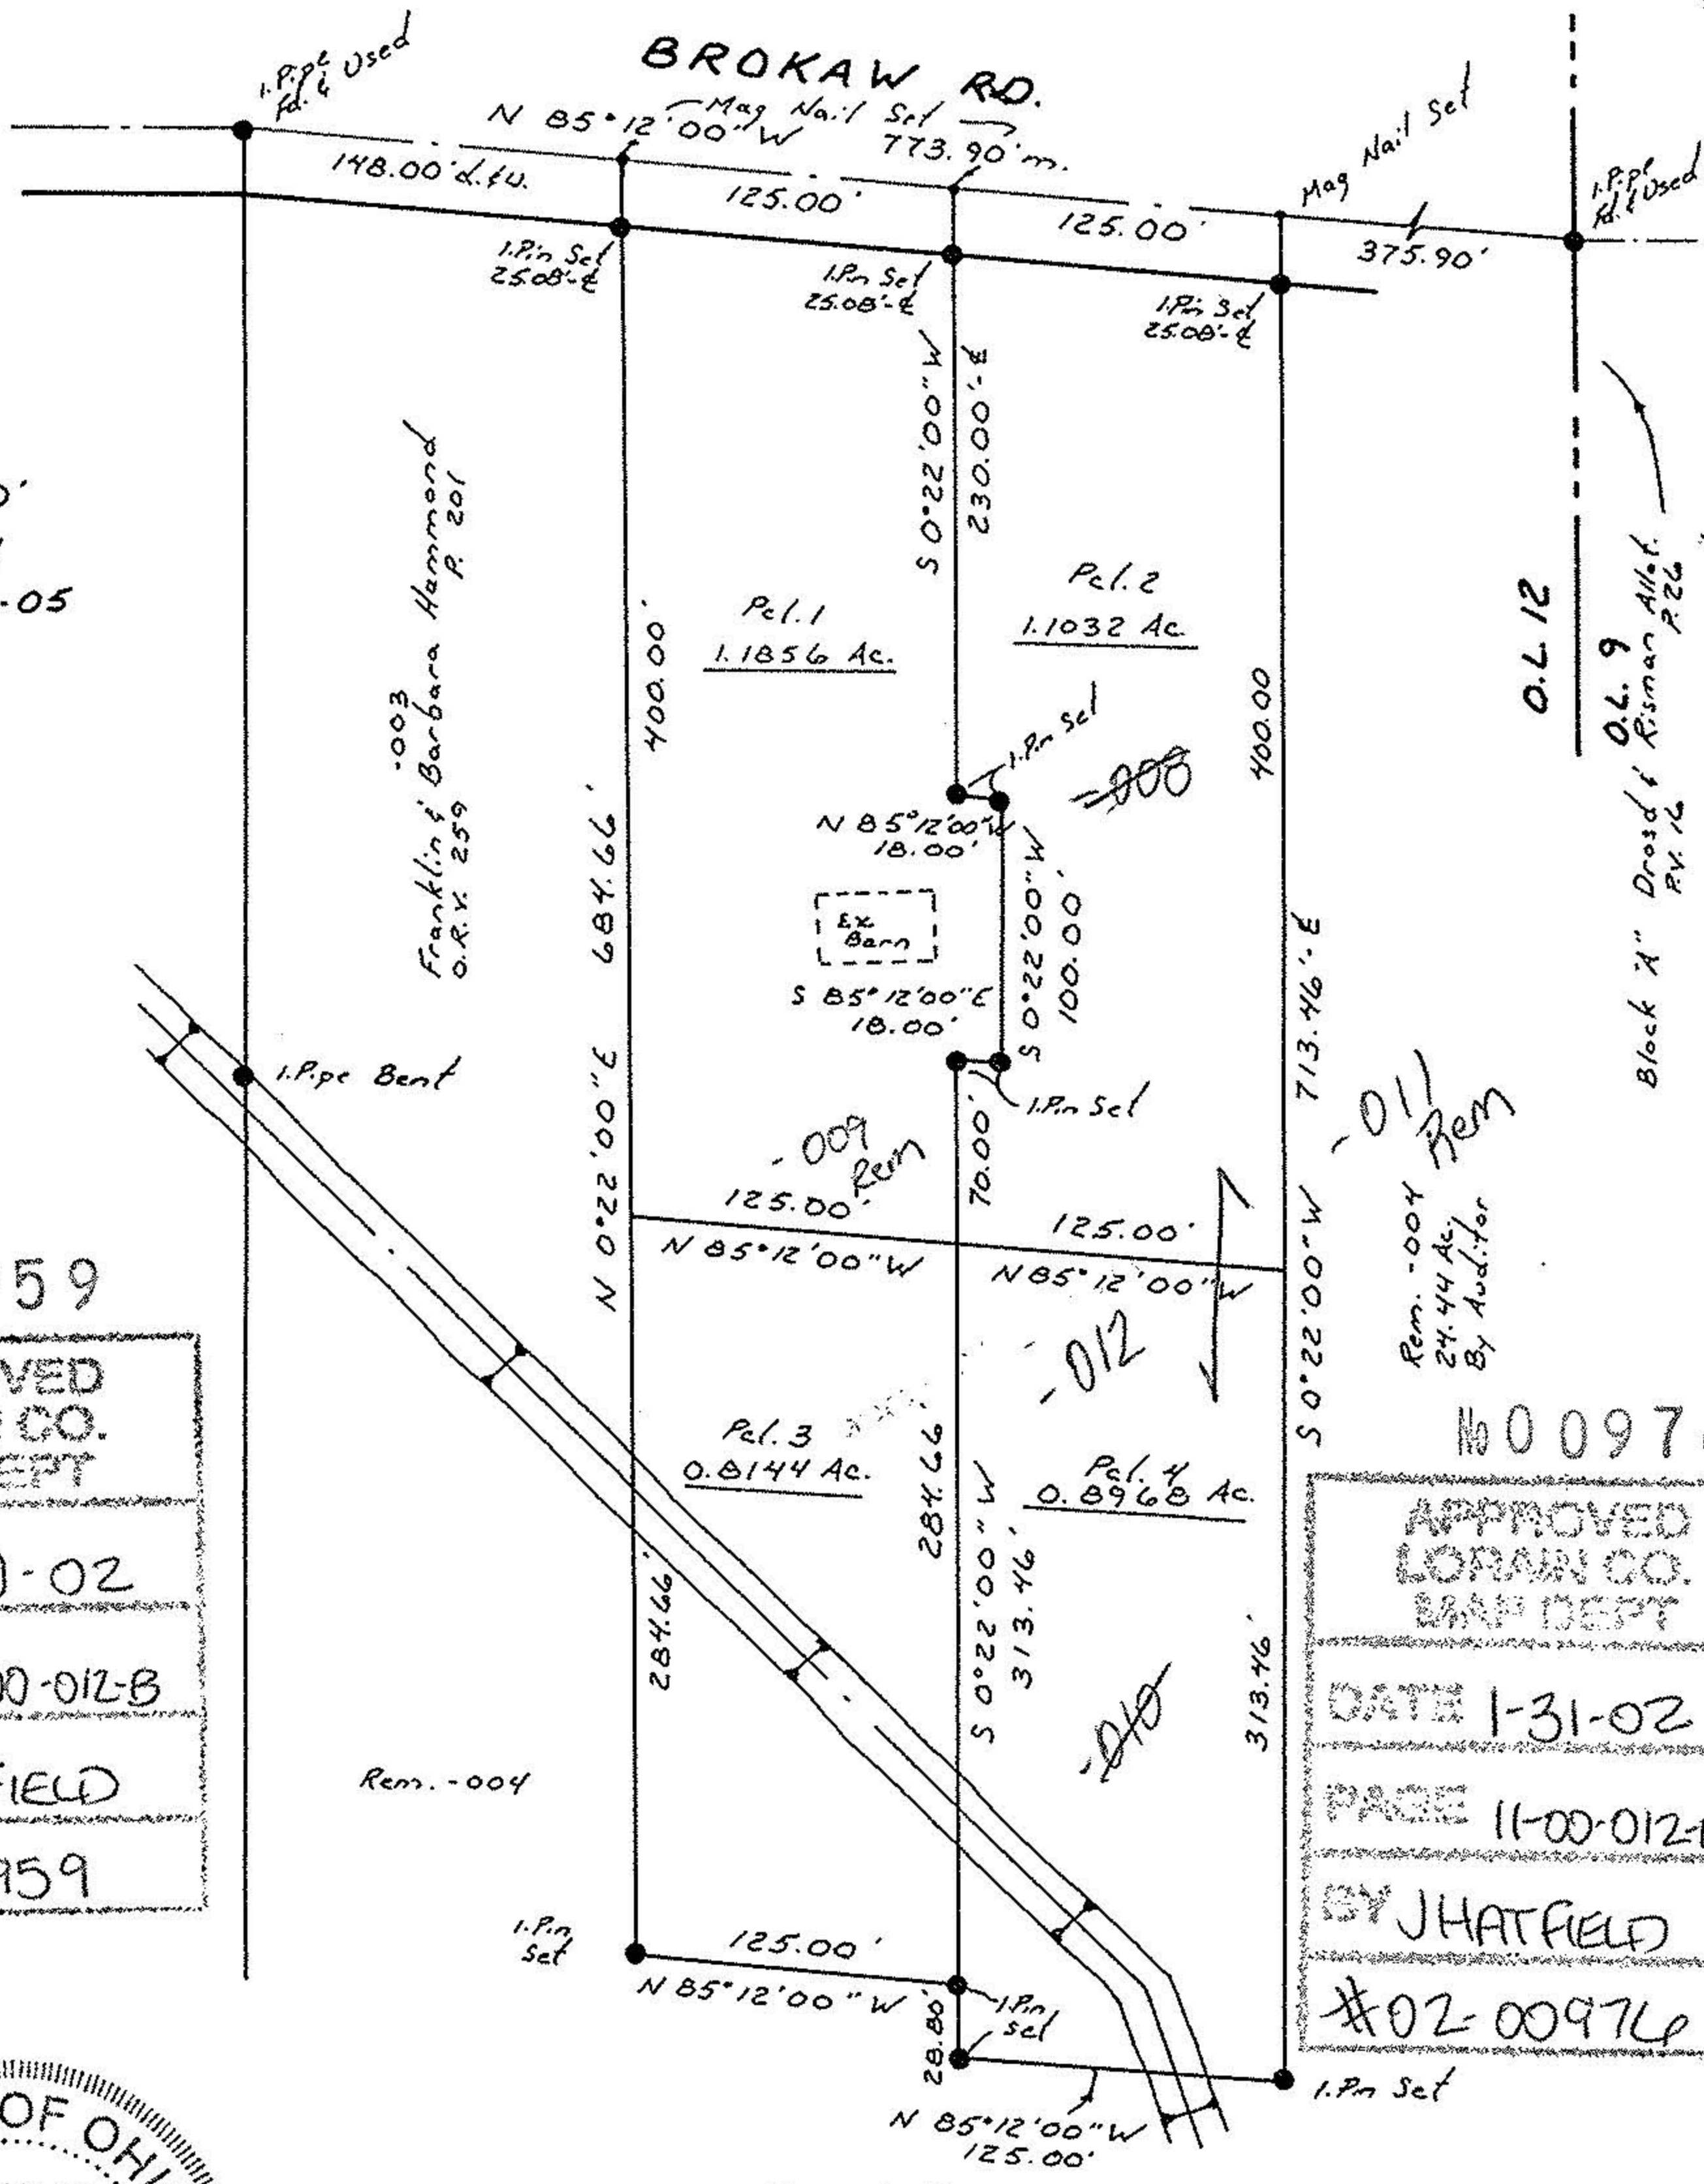

No 00959

APPROVED
 LORAIN CO.
 MAP DEPT
 DATE 1-10-02
 PAGE 11-00-012-B
 BY JHATFIELD
 #02-00959

No 00976

APPROVED
 LORAIN CO.
 MAP DEPT
 DATE 1-31-02
 PAGE 11-00-012-B
 BY JHATFIELD
 #02-00976



Survey For
MIKE SAUTER
 Eaton Twp. O.L. 12
 Lorain Co. Ohio
 CARLSON SURVEYS 440-926-0200