




LAUNDON • SIMON • CAHL & ASSOC., INC.
 CONSULTING ENGINEERS & SURVEYORS
 110 MIDDLE AVE., ELYRIA, O. 44035

SURVEY FOR:

GILBERT & SARAH J. MARTINSON

Orig. Lot 40	City of	Date JUNE '94 Scale 1"=200'
Orig. Sec	Village of	Dwn. by R.G.S. Chkd. by R.C.
Tract	County of LORAIN	Job No. 94-2604 F.B.
Township of EATON	State of OHIO	Printed

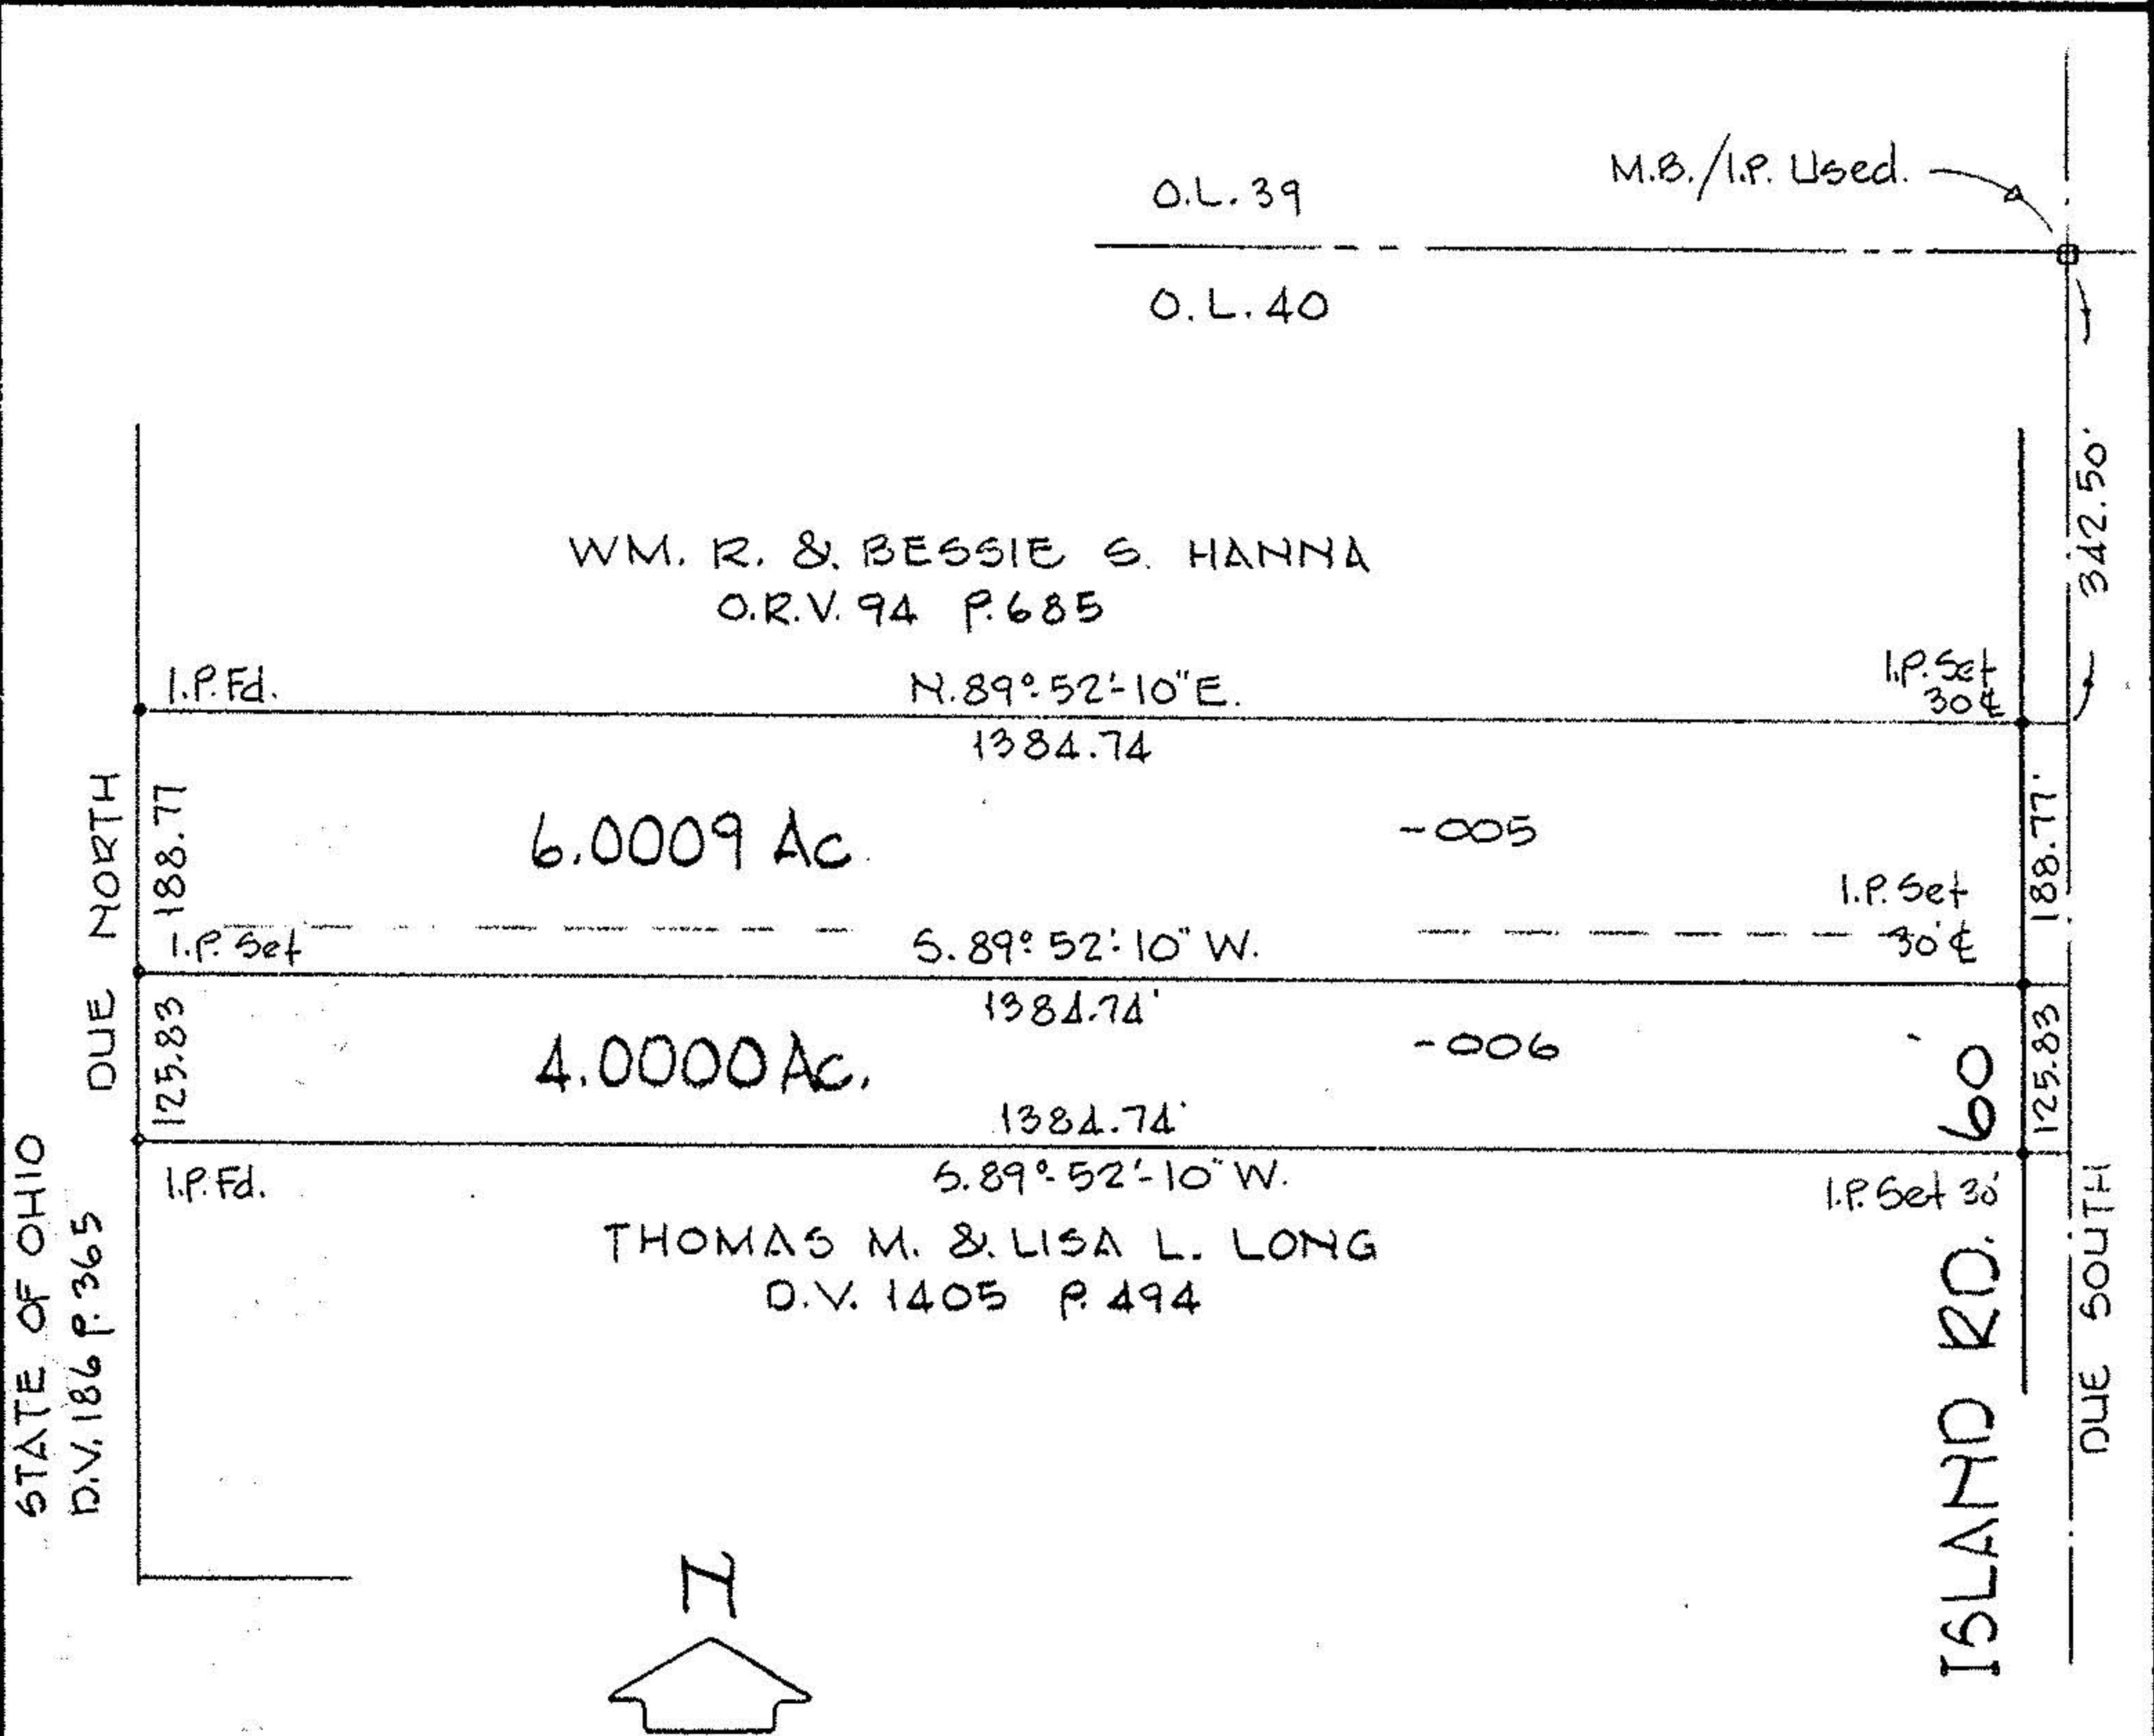

STATE OF OHIO
 D.V. 186 P. 365

