


COOLEY RD

N

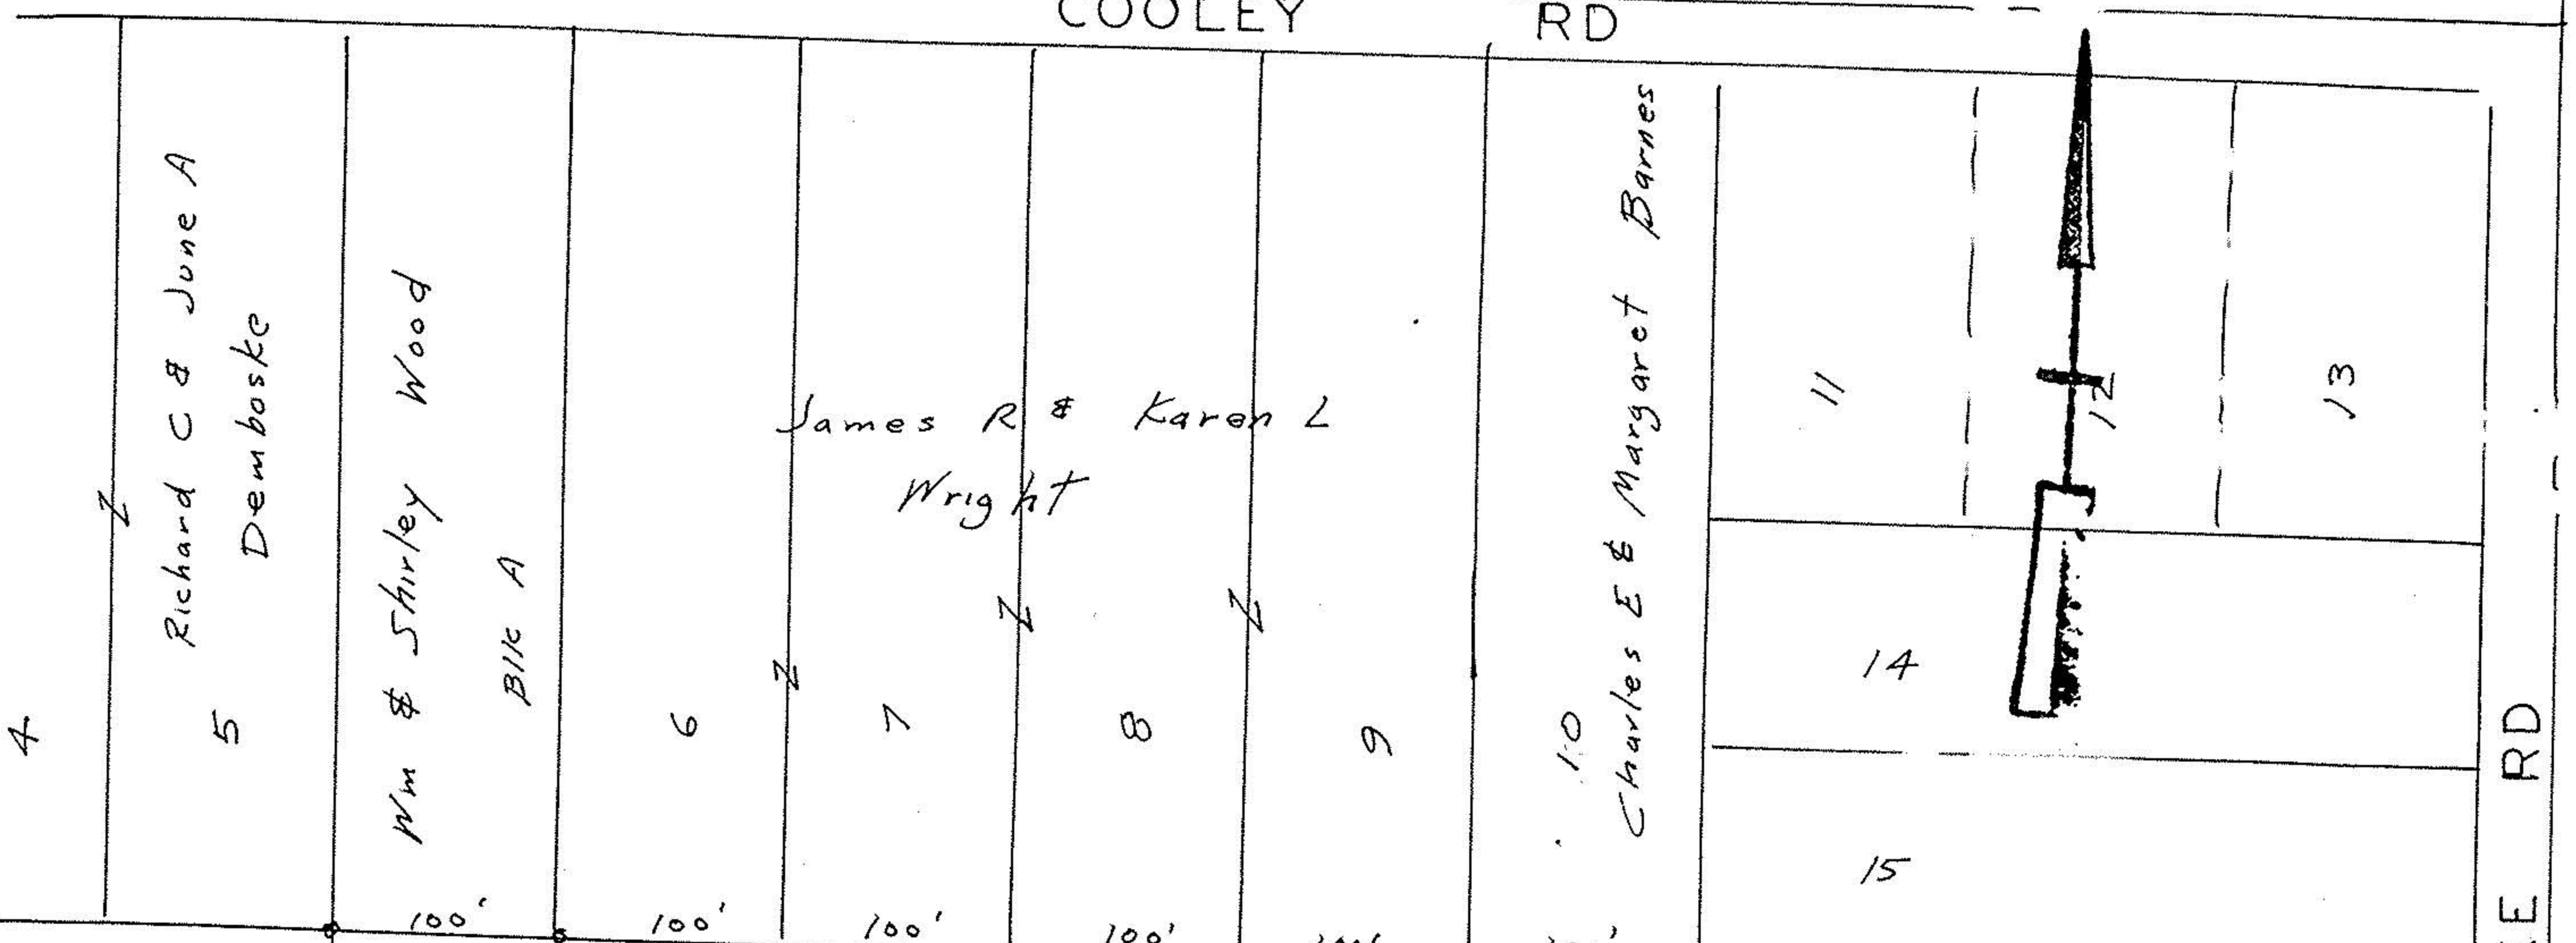

HAWKE RD

Richard C & June A Demboske

N 30° 02' 37" E

300.00'

S 86° 57' 23" E

4.148 Acres
By Survey

604.71'

BLK E

300.04'

S 20° 08' 37" W

16 James & Frieda Wilson

17 Richard & Eli

18 Christenson

19 Thorvald & Ailly Anderson

Frank Mencil
BLK B

Nichols & Katalin F Sipos

6.972 Acres
Remainder in BLK E

11-00-007-000

BLK D

BLK C

Nichols & Katalin F Sipos #15337

Donald & Paula Moskalsky

Kenneth H. Jarvis
Kmieciak Kelly

APPROVED
LORAIN CO.
MAP DEPT.
DATE 10-26-83
PAGE 11-00-007-B
BY [Signature]
VOID AFTER 15337

IP's fd or set

John Poznywal
Reg Surveyor
5292

Parcel split for James Wright
Part BLK E Hawke-Cooley Estates
Pvol 17 Pg 11
Part of Original Lot 7 Eaton Twp
Lorain County Ohio
Oct 1983 Scale 1" = 100'