
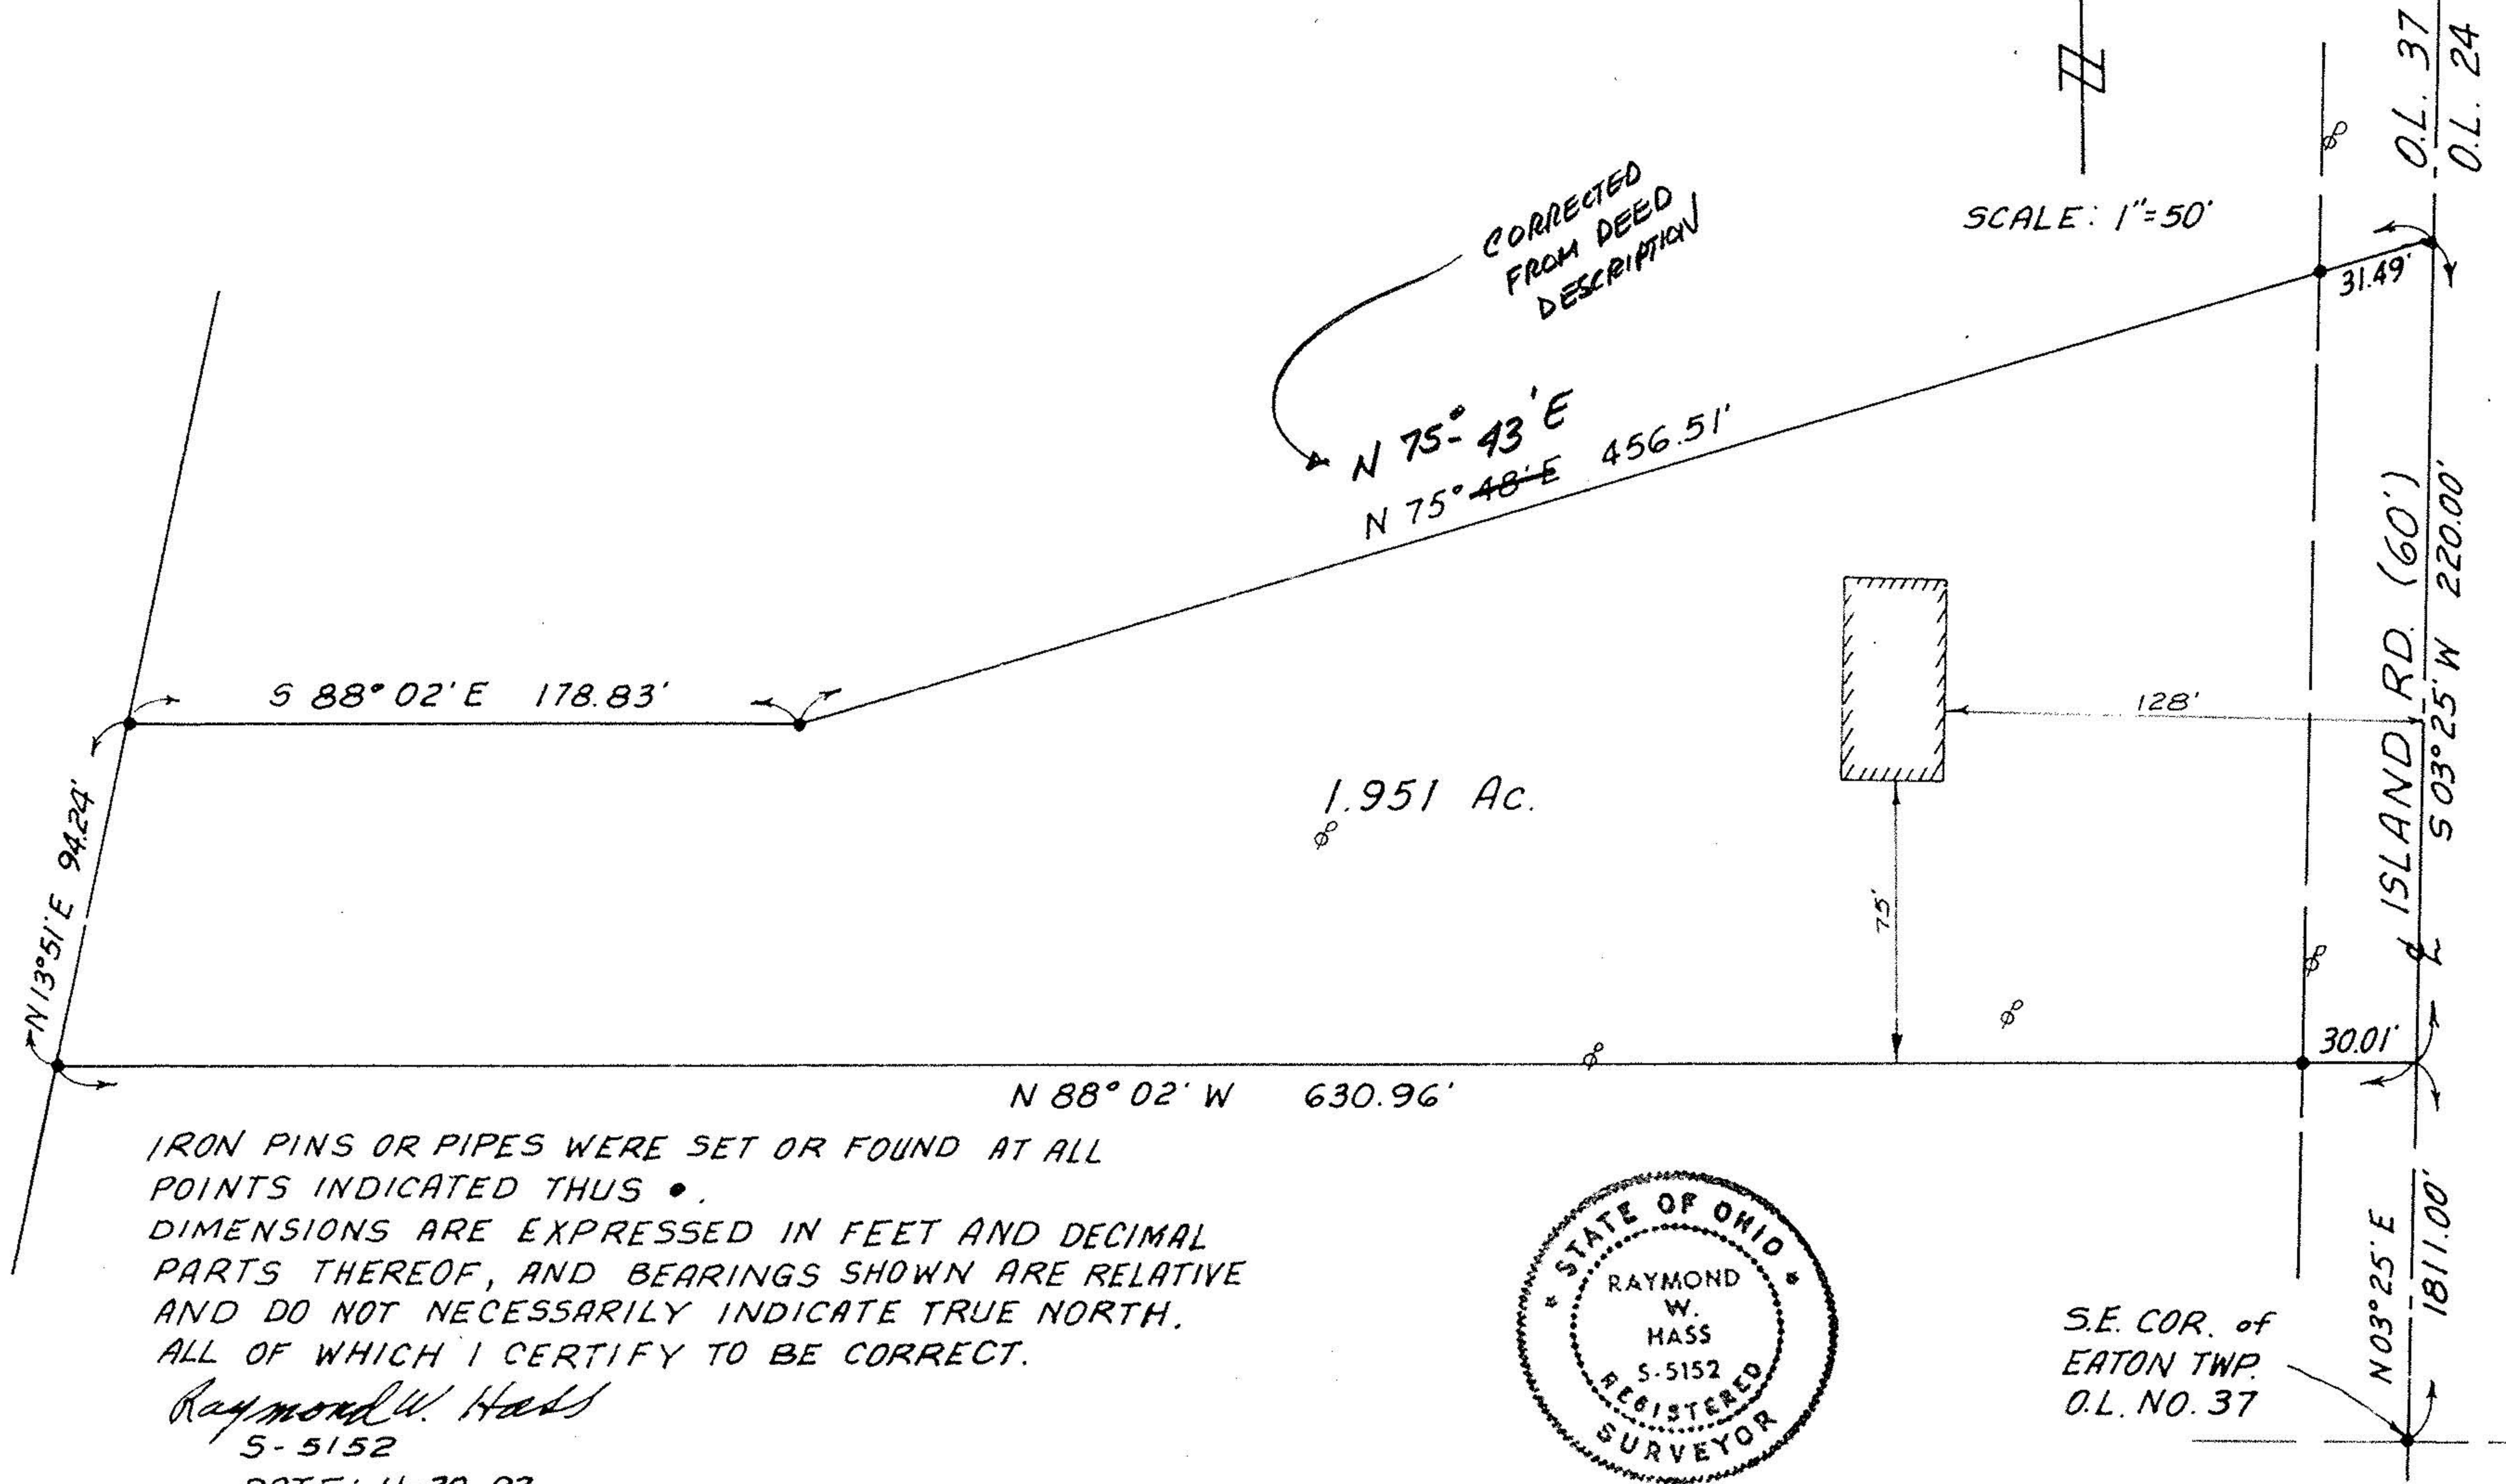


PLAT FOR KEVIN M. & SANDRA J. SILLASEN
 PART OF ORIGINAL LOT NO. 37
 EATON TOWNSHIP, LORAIN COUNTY
 STATE OF OHIO

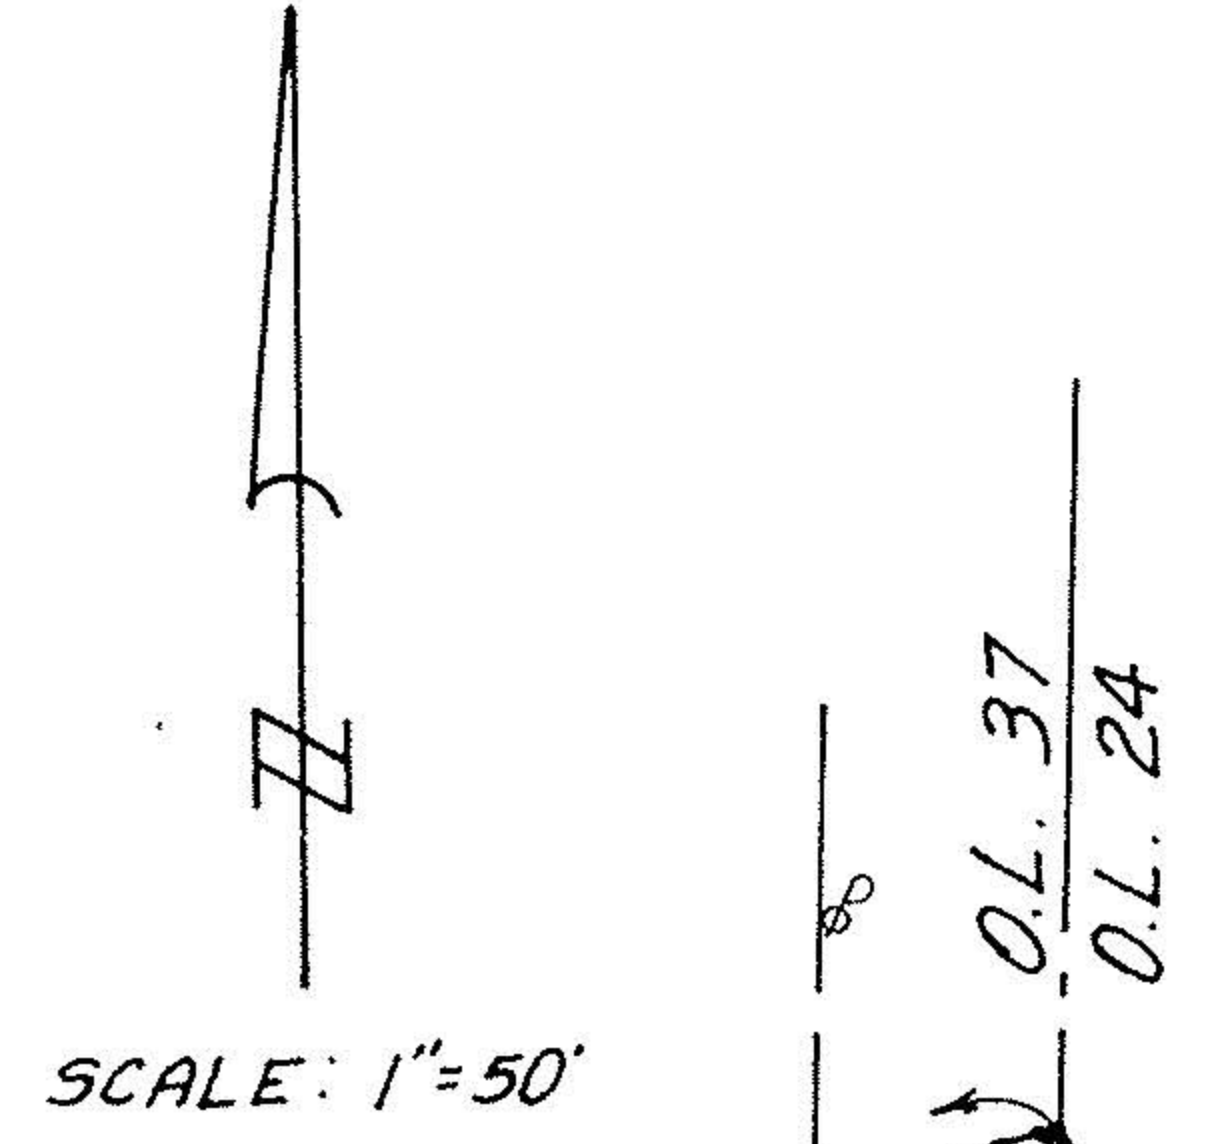

1.951 Ac.

IRON PINS OR PIPES WERE SET OR FOUND AT ALL POINTS INDICATED THUS •. DIMENSIONS ARE EXPRESSED IN FEET AND DECIMAL PARTS THEREOF, AND BEARINGS SHOWN ARE RELATIVE AND DO NOT NECESSARILY INDICATE TRUE NORTH. ALL OF WHICH I CERTIFY TO BE CORRECT.

Raymond W. Hass
 S-5152
 DATE: 11-30-83



S.E. COR. of
 EATON TWP.
 O.L. NO. 37

#15441

APPROVED
 LORAIN CO.
 MAP DEPT.

DATE 2-1-84

PAGE 11-G

BY *T. McMan*

VOID
 IF