


6-00-015-C

07-00-015-110-

GEORGE IVO FENN
VOL. 273 PG. 374

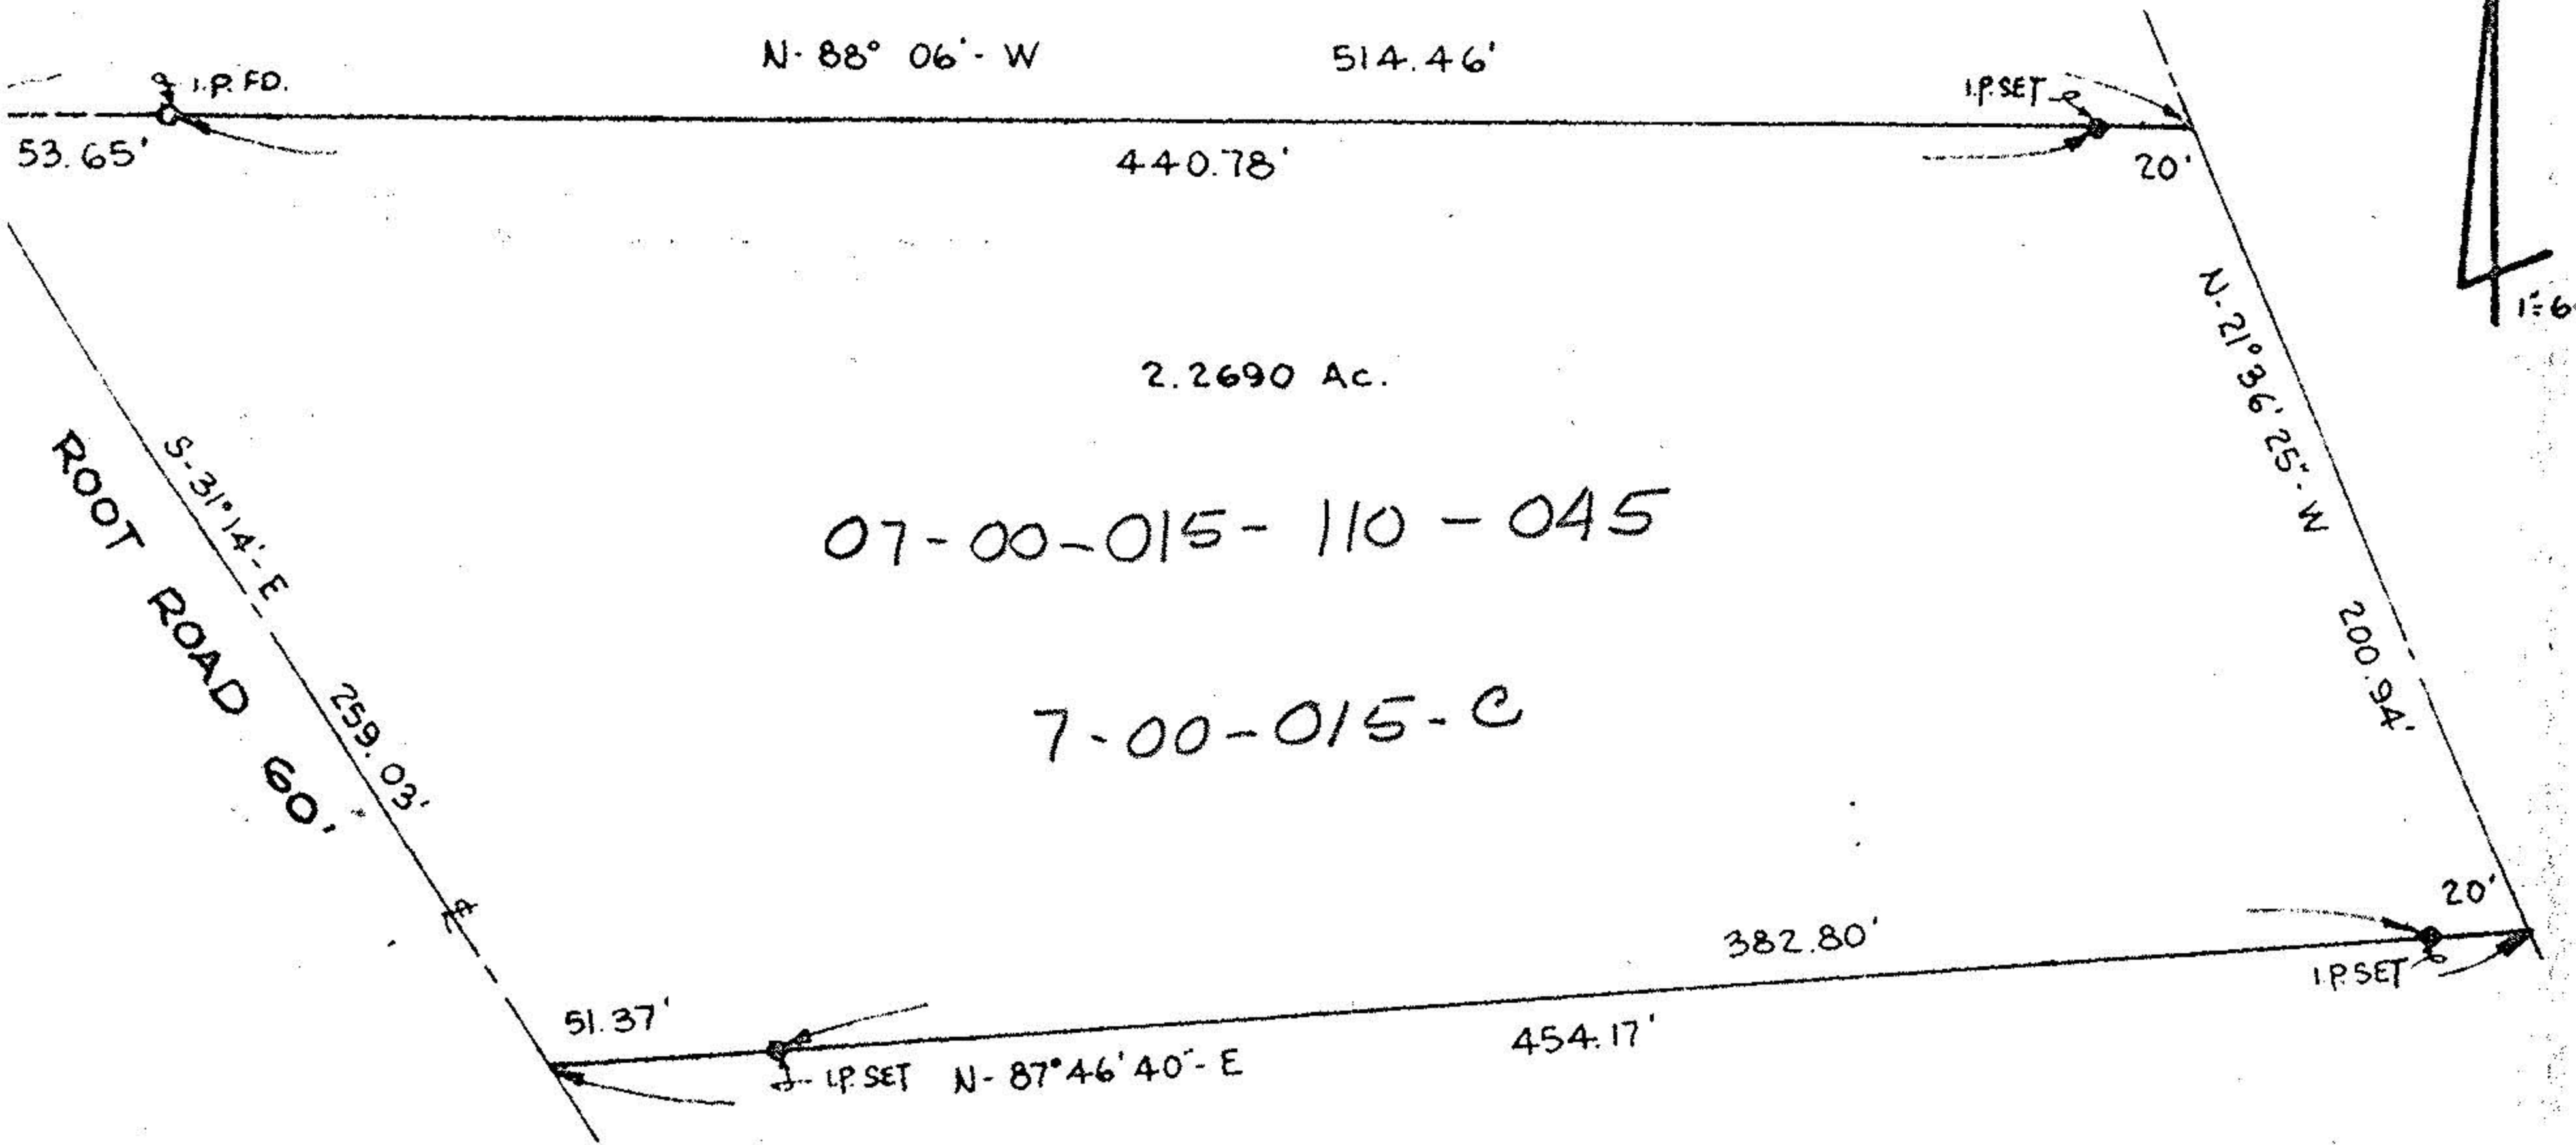

PARCEL SPLIT FROM
P.P.# 07-00-015-110-010 2.2690 Ac.
of ORIG. RIDGEVILLE TWP. LOT # 15
NOW in CITY of NORTH RIDGEVILLE, OHIO

MAP of SURVEY for:
RUBY DRAUDT
7887 ROOT ROAD
NORTH RIDGEVILLE, OHIO

PREPARED BY: MC GLINCHY & ASSOCIATES

OCT. 12, 1976 # 761283

7-68-815C
10783