

11-00-051-B

SURVEY  
 OF PART OF  
 ORIGINAL EATON TWP  
 LOT NO 51  
 COUNTY OF LORAIN  
 STATE OF OHIO

#18277  
 APPROVED  
 LORAIN CO.  
 MAP DEPT.

KARL KIESE  
 DATE 2-8-91  
 9000 ROOT ROAD  
 N. RIDGEVILLE, OH  
 BY CAROLYN  
 FRANCIS

S/L 4 JASON EST. SUBN.  
 PV. 35 PG 15-16


DATE: AUG 1990  
 SCALE: 1"=100'

REC'D & USED  
 RECORDED



#18277B

11-00-051-000-100  
 101

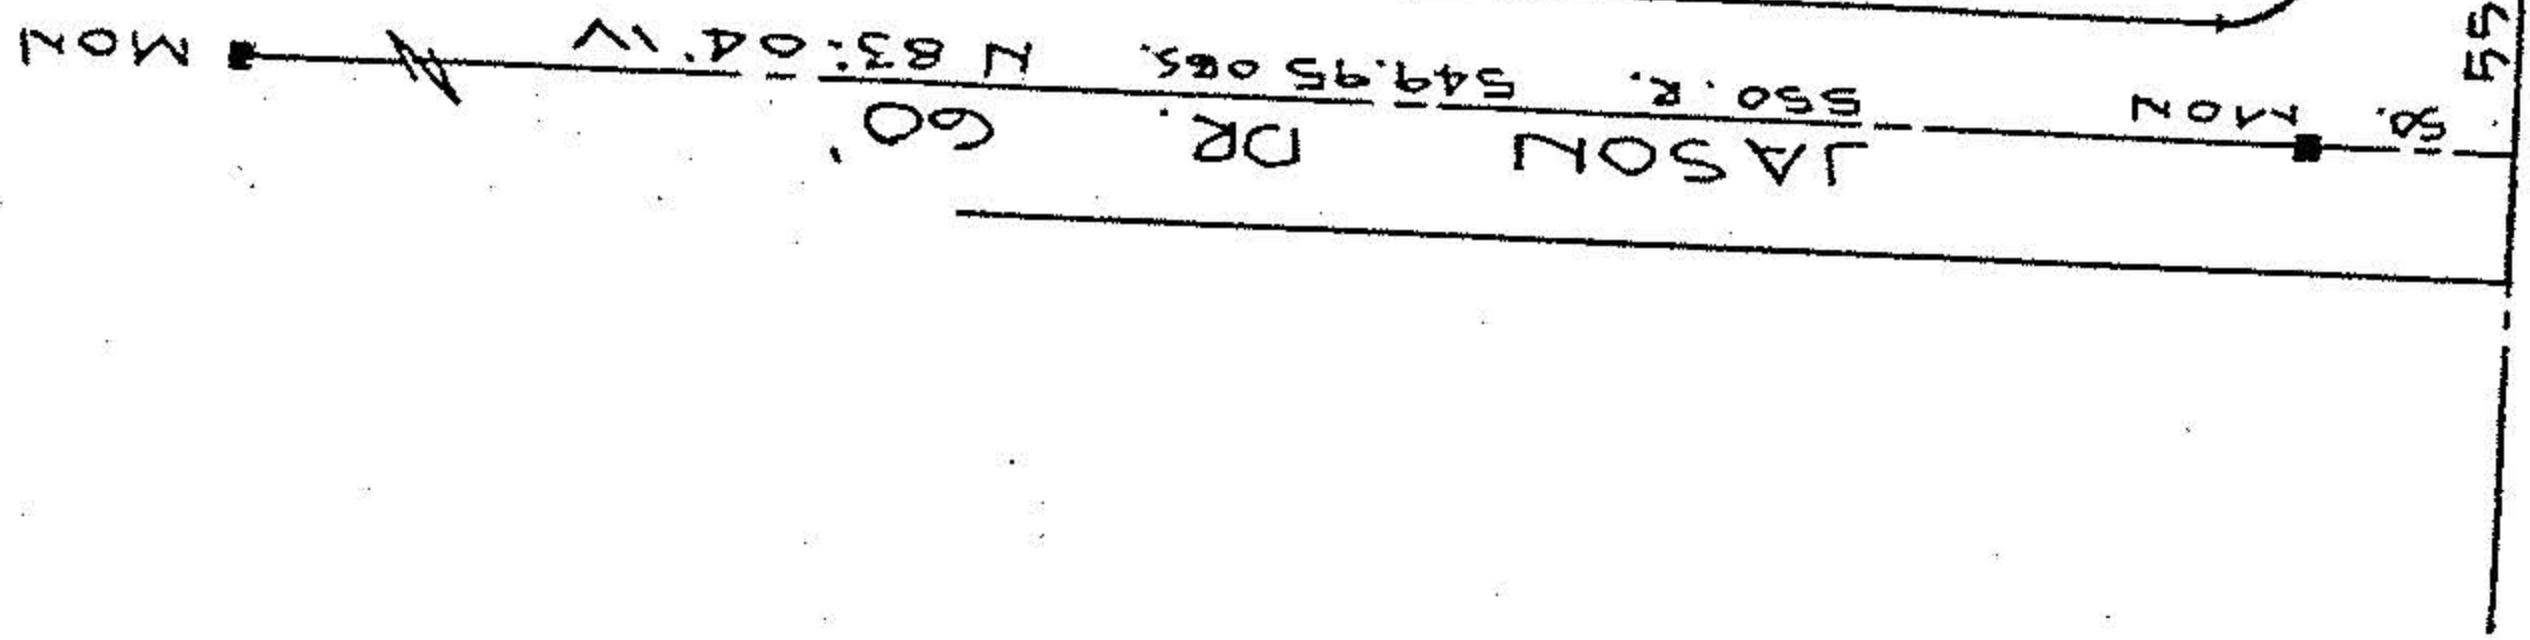

N 06:56' E 473.69 R. 471.76 OBS

100  
 1.1161 AC.

101  
 1.0795 AC.

HOMER D. MICHAELS  
 DV. 1203 PG 891  
 S 49:16-05' E REBAR SET  
 W 00:57' R USED  
 W 00:57' R USED  
 S 49:16-05' E REBAR SET  
 75 B.L.

N 06:56' E

WOOSTER - AVON LAKE RD.