

043

10010


11-00-057-000-

HUGH GRAHAM
O.R. VOL. 113 P. 499
6.95 AC. ORIG.
5.847 AC. REM.

MAP OF SURVEY FOR MIKE ENSIGN
O.L. # 57 - EATON TWP. - LORAIN CO.
AUG. 1989 SCALE 1" = 100'
JOHN R. HAMILTON - REG. SURV. # 6861

NORTH
SCALE 1" = 100'

GARDEN OF EATON ALLOT.
PLAT VOL. 34, P. 75

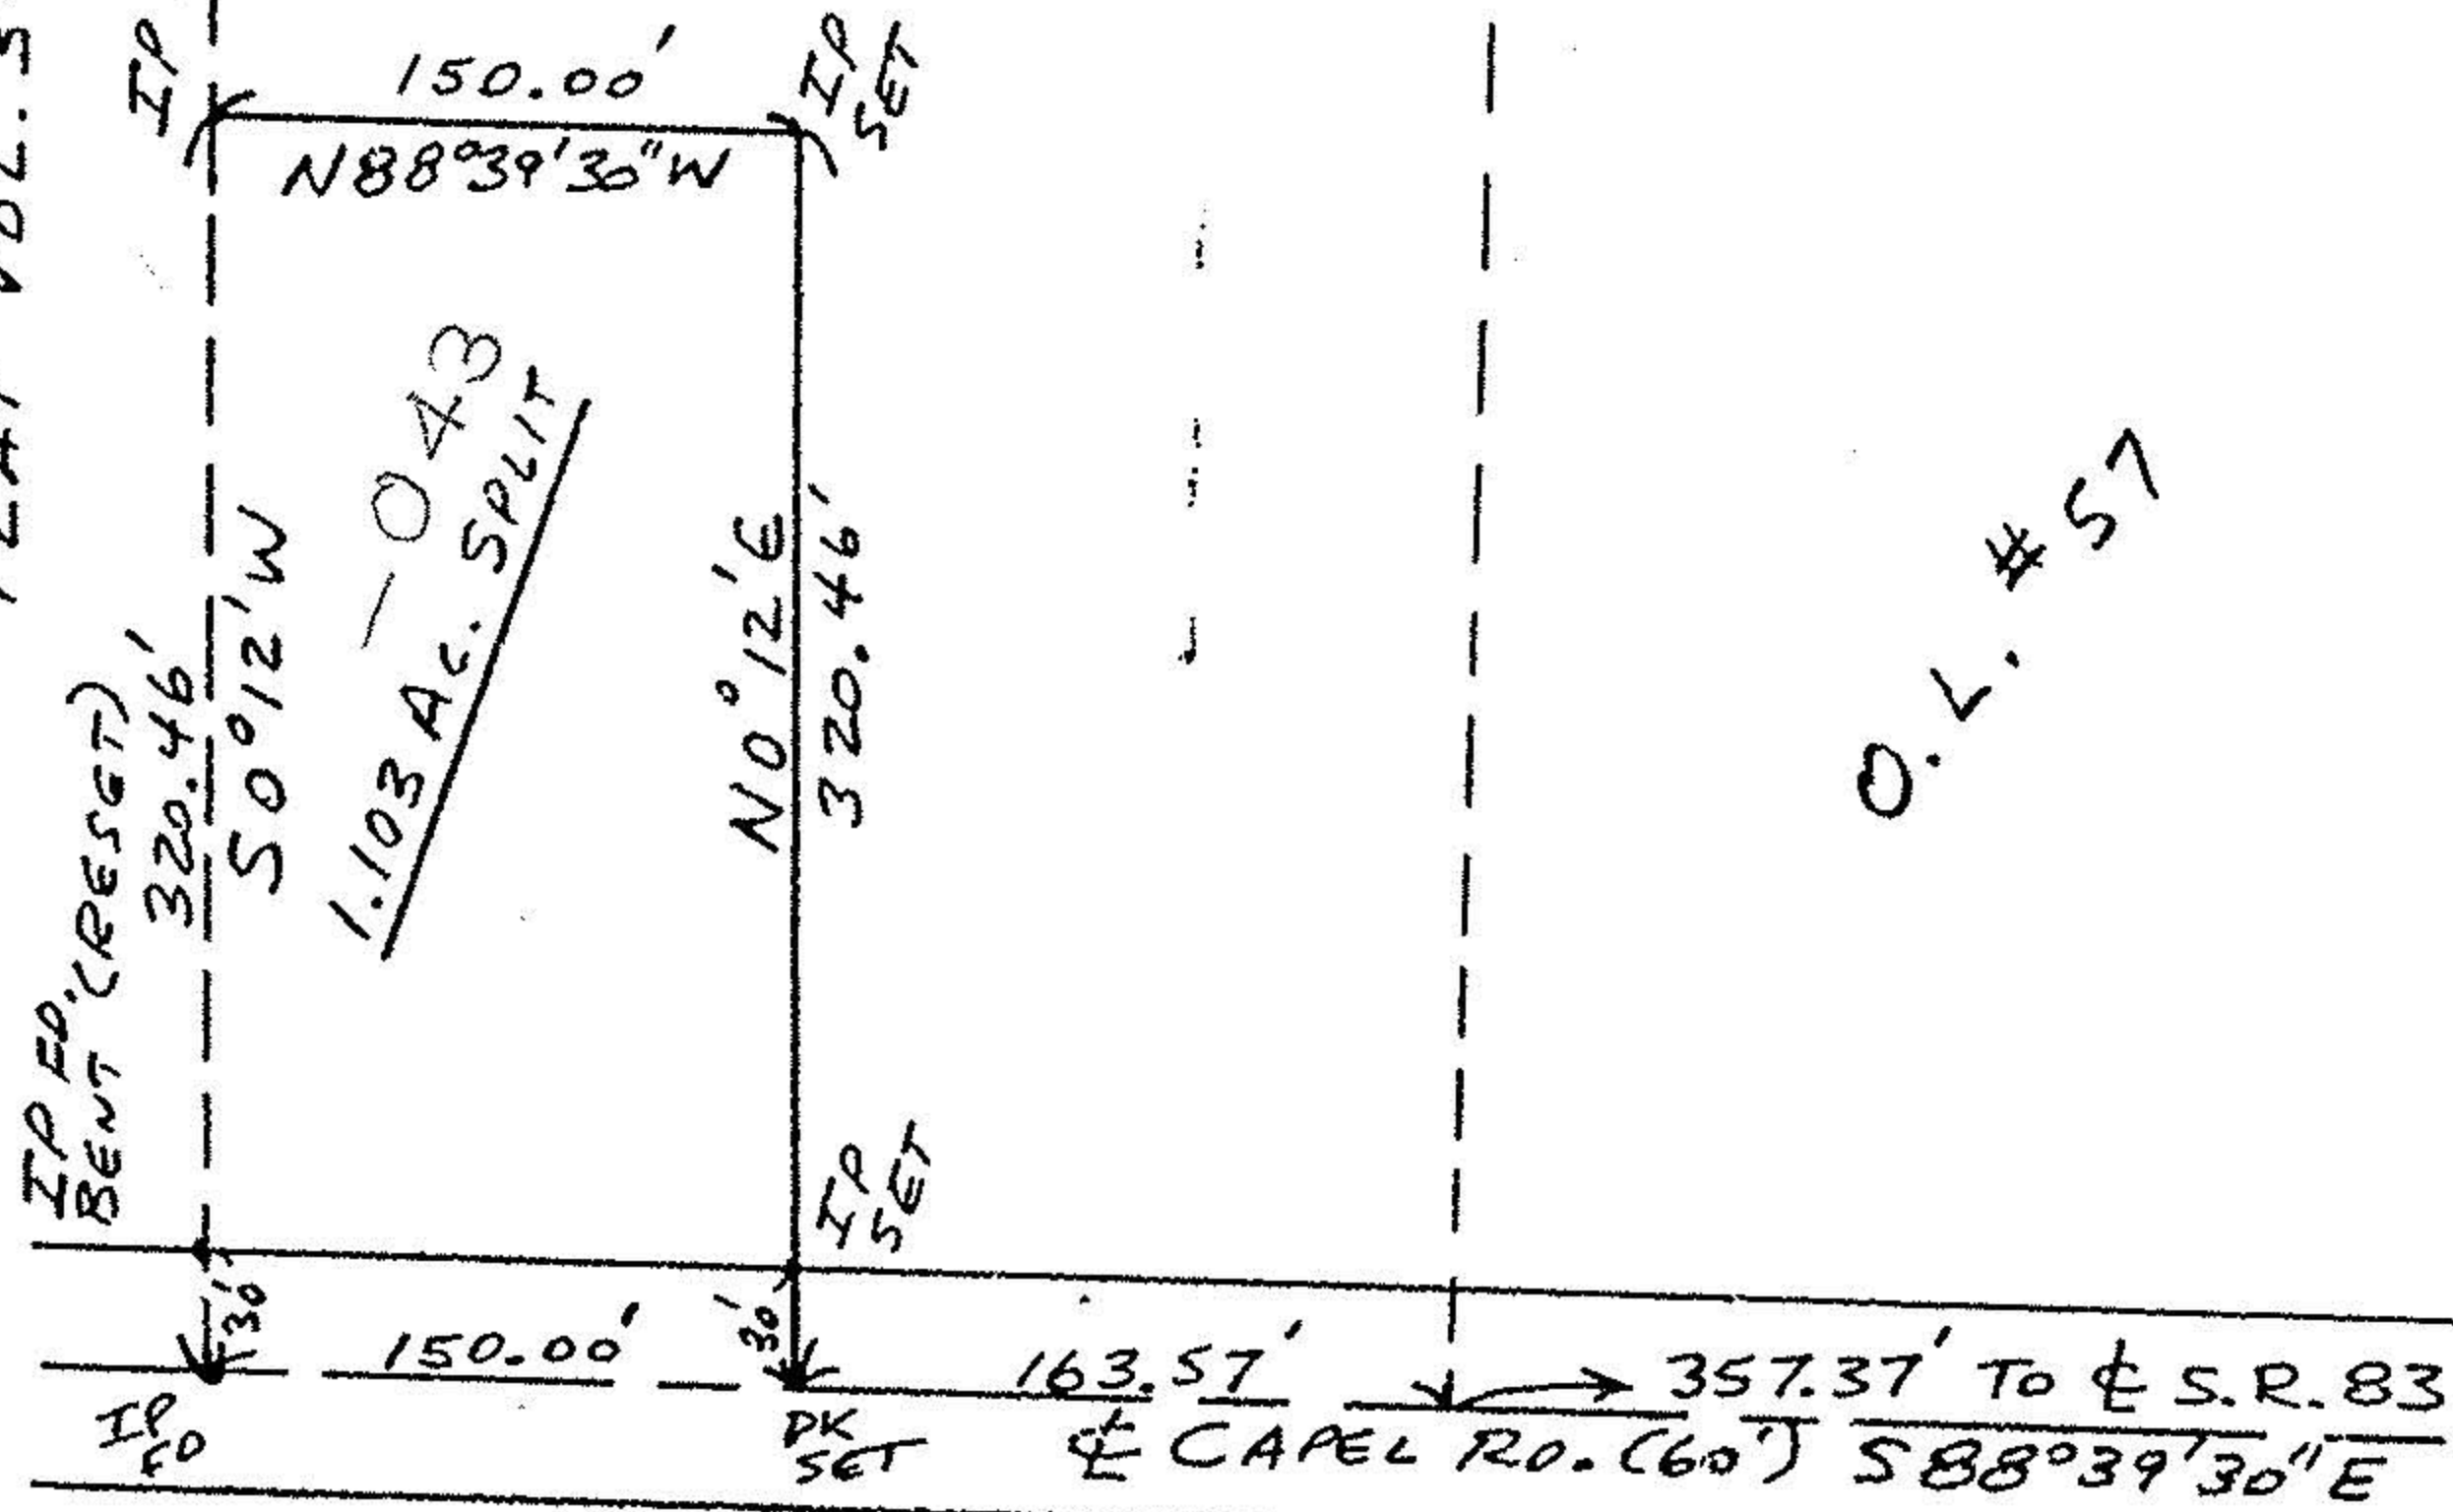

O.L. # 57

18646

APPROVED LORAIN CO. MAP DEPT.
DATE 9-25-89
PAGE 11-00-057-8
BY CAROLYN FRANCIS
VOID