


84-49-00  
 - 11-01-27  
 -----  
 73-47-33

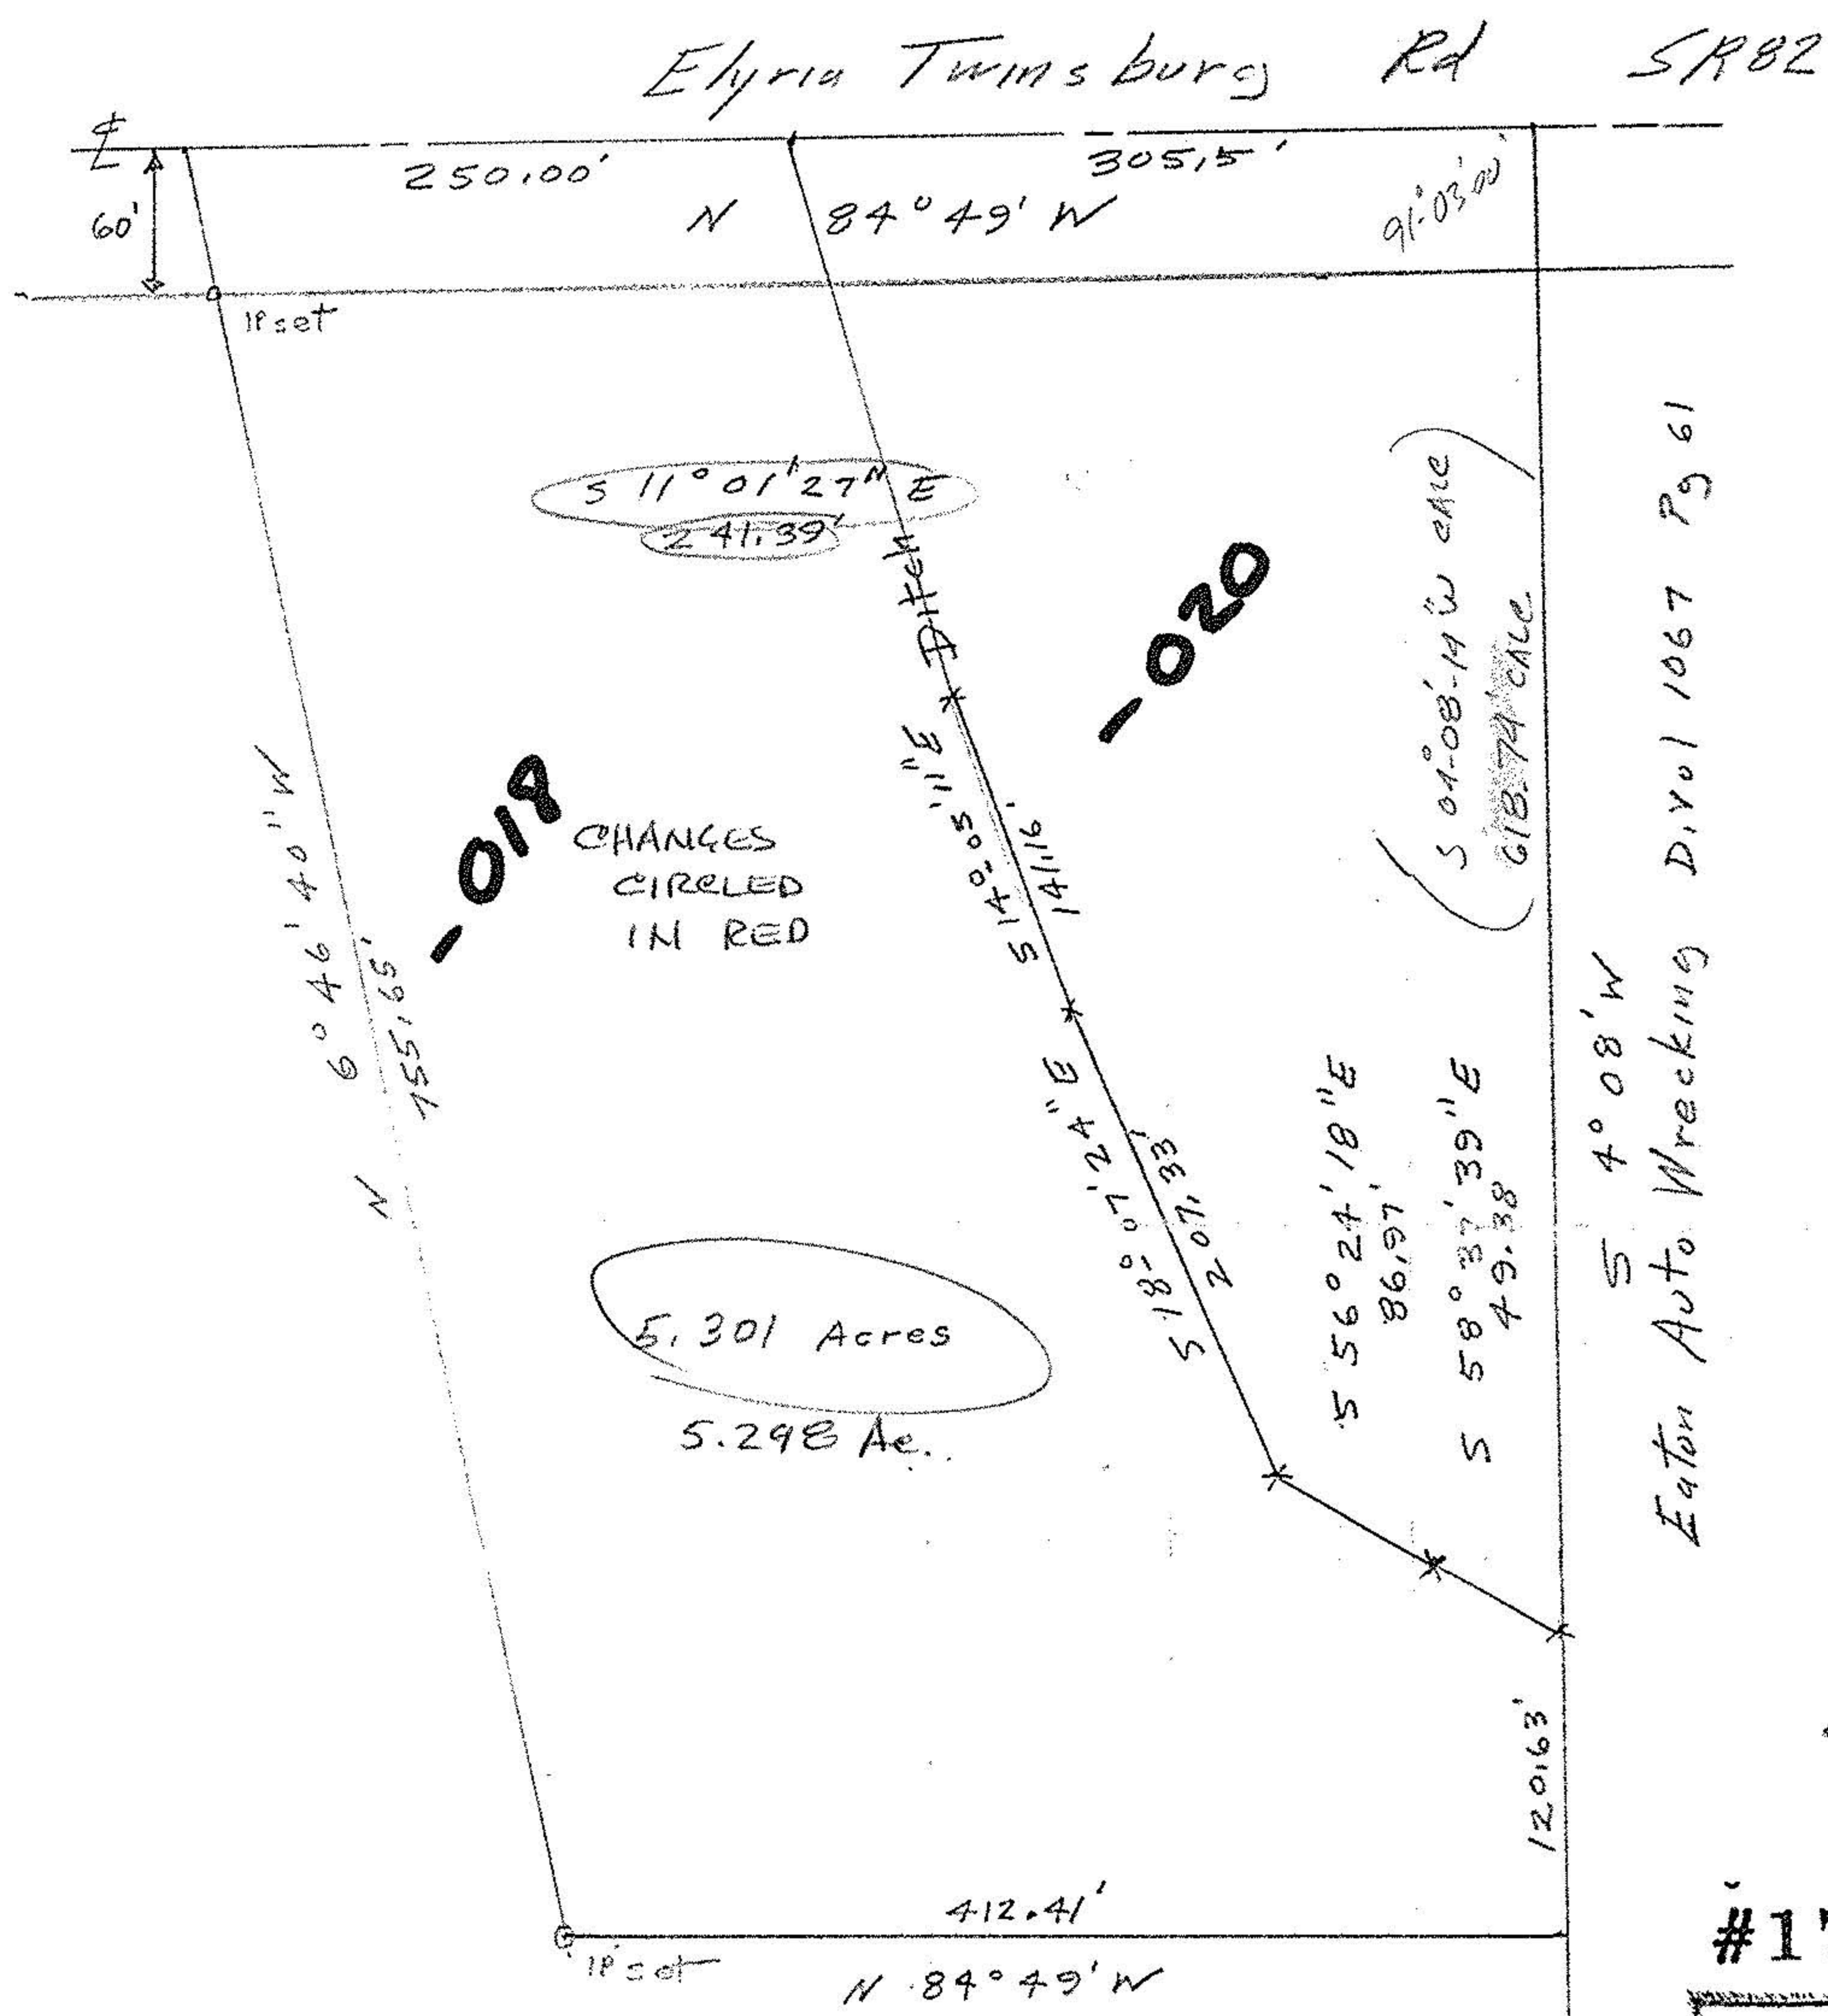

American Motorcycle Co  
 D. Vol 1123 Pg 847.  
 75.702 Acres Remainder  
 in OIL, 65

Eaton Auto Wrecking D. Vol 1067 Pg 61

#17983

APPROVED LORAIN CO. MAP DEPT.	
DATE 6-16-88	
PAGE 11-F NORTH	
BY T. McVain	
VOID AFTER	17983

Bearings from ODOT  
 to SR 82

John Poznywak  
 Reg Surveyor  
 5292



Survey for Bill Kennedy  
 Part of Original Lot 65  
 Eaton Township  
 Lorain County, Ohio  
 Scale 1" = 100' Sept 24, 1987  
 June 1988

17983

2-11

170-05000