
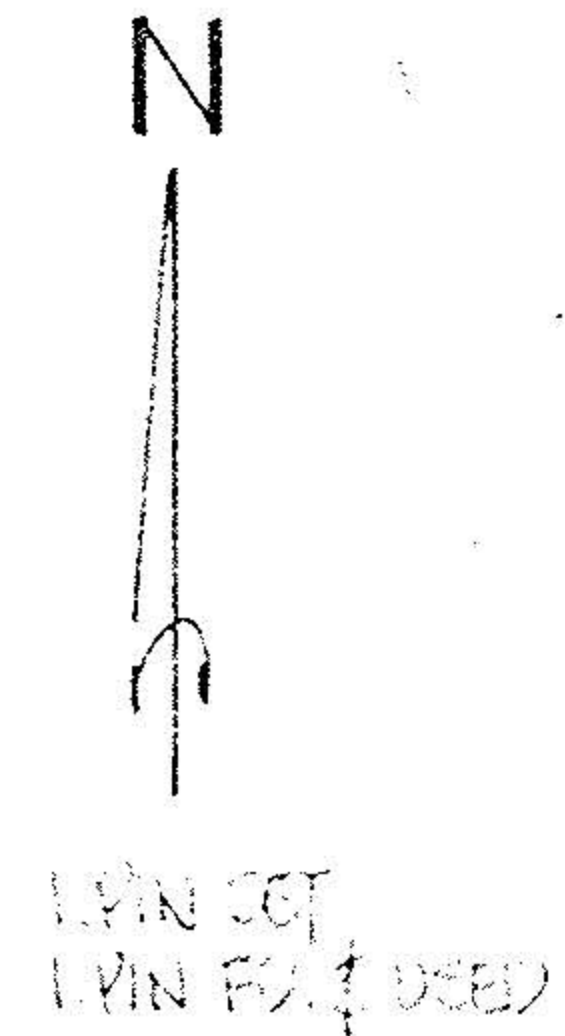


12-00-008

# PLAT OF SURVEY

County of LORAIN State of Ohio  
 Township COLUMBIA  
 Twp. lot B Tr. or Sec. \_\_\_\_\_  
 City or Village \_\_\_\_\_ Lot \_\_\_\_\_  
 Subdivision \_\_\_\_\_ Lot \_\_\_\_\_  
 Prop. Owner ARLINE M. WOLF  
 Date OCT. 1977 Scale 1"=200'

By Charles A. Rolling  
 REG. OHIO SURVEYOR No. 5569

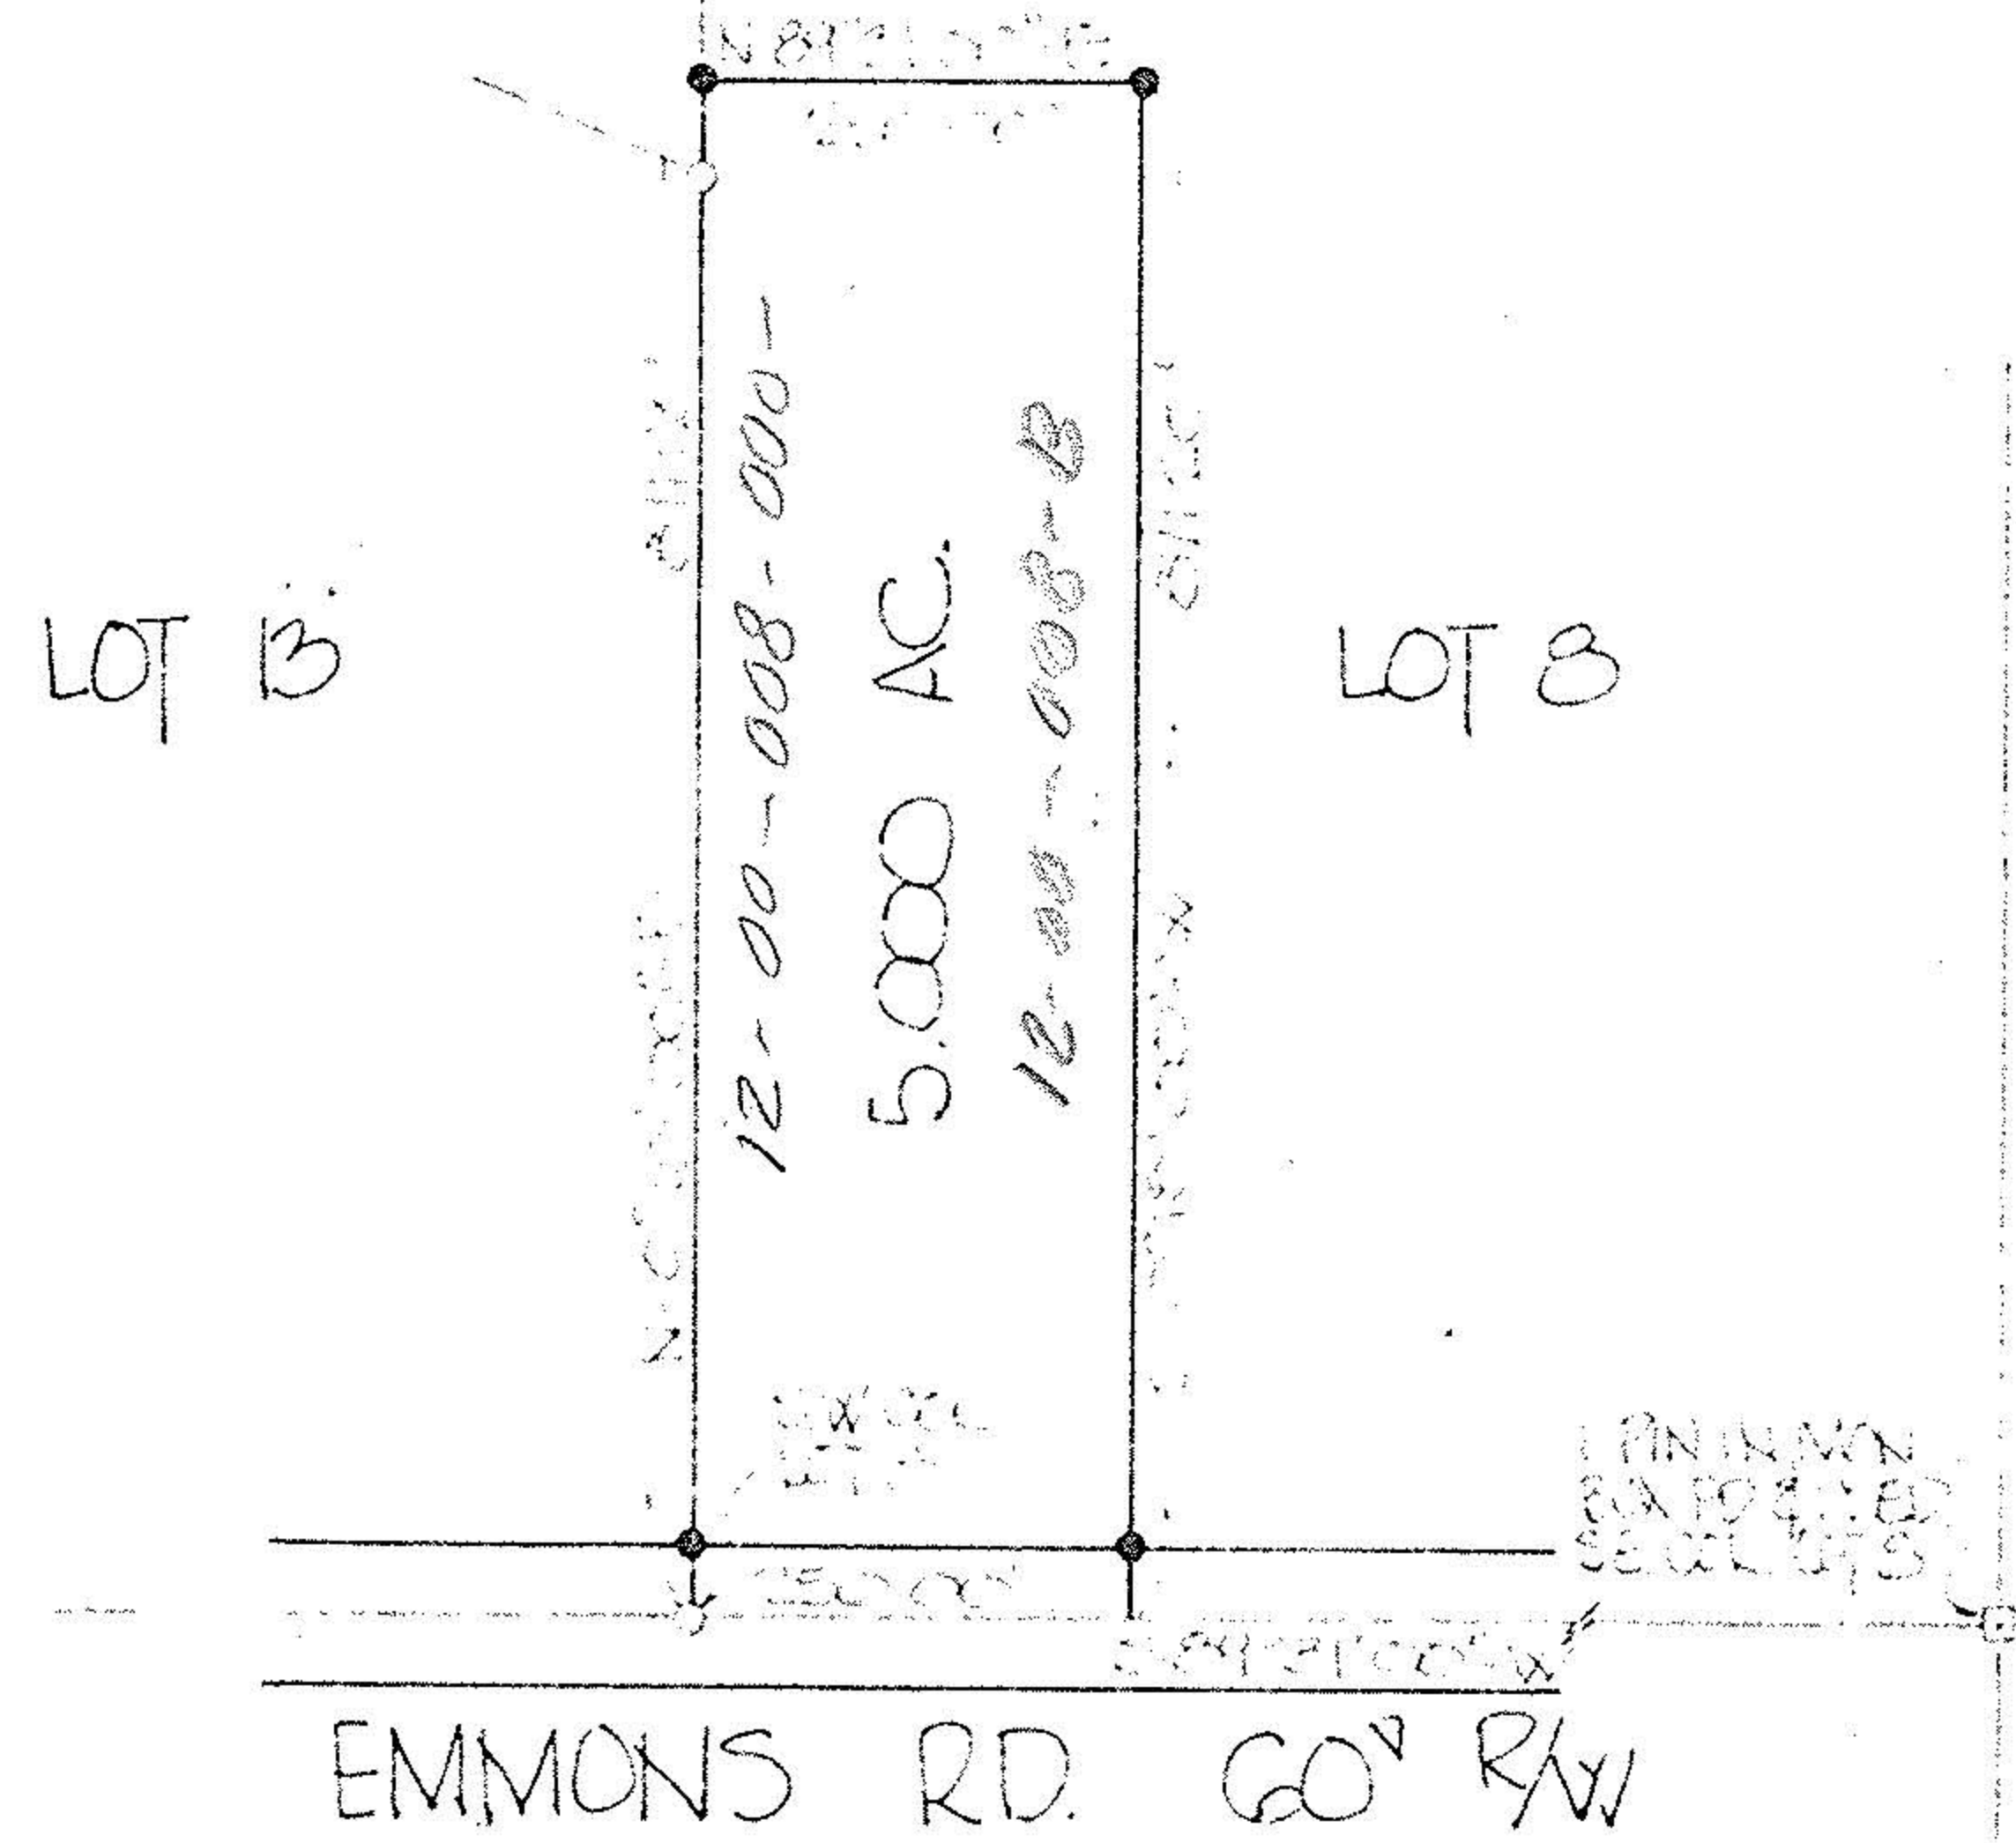

*Rolling, Hocevar & Associates, Inc.*  
 ENGINEERS SURVEYORS  
 MEDINA, OHIO 723 - 1828

Project No. 3086

12-00-8