



20007 # 20007

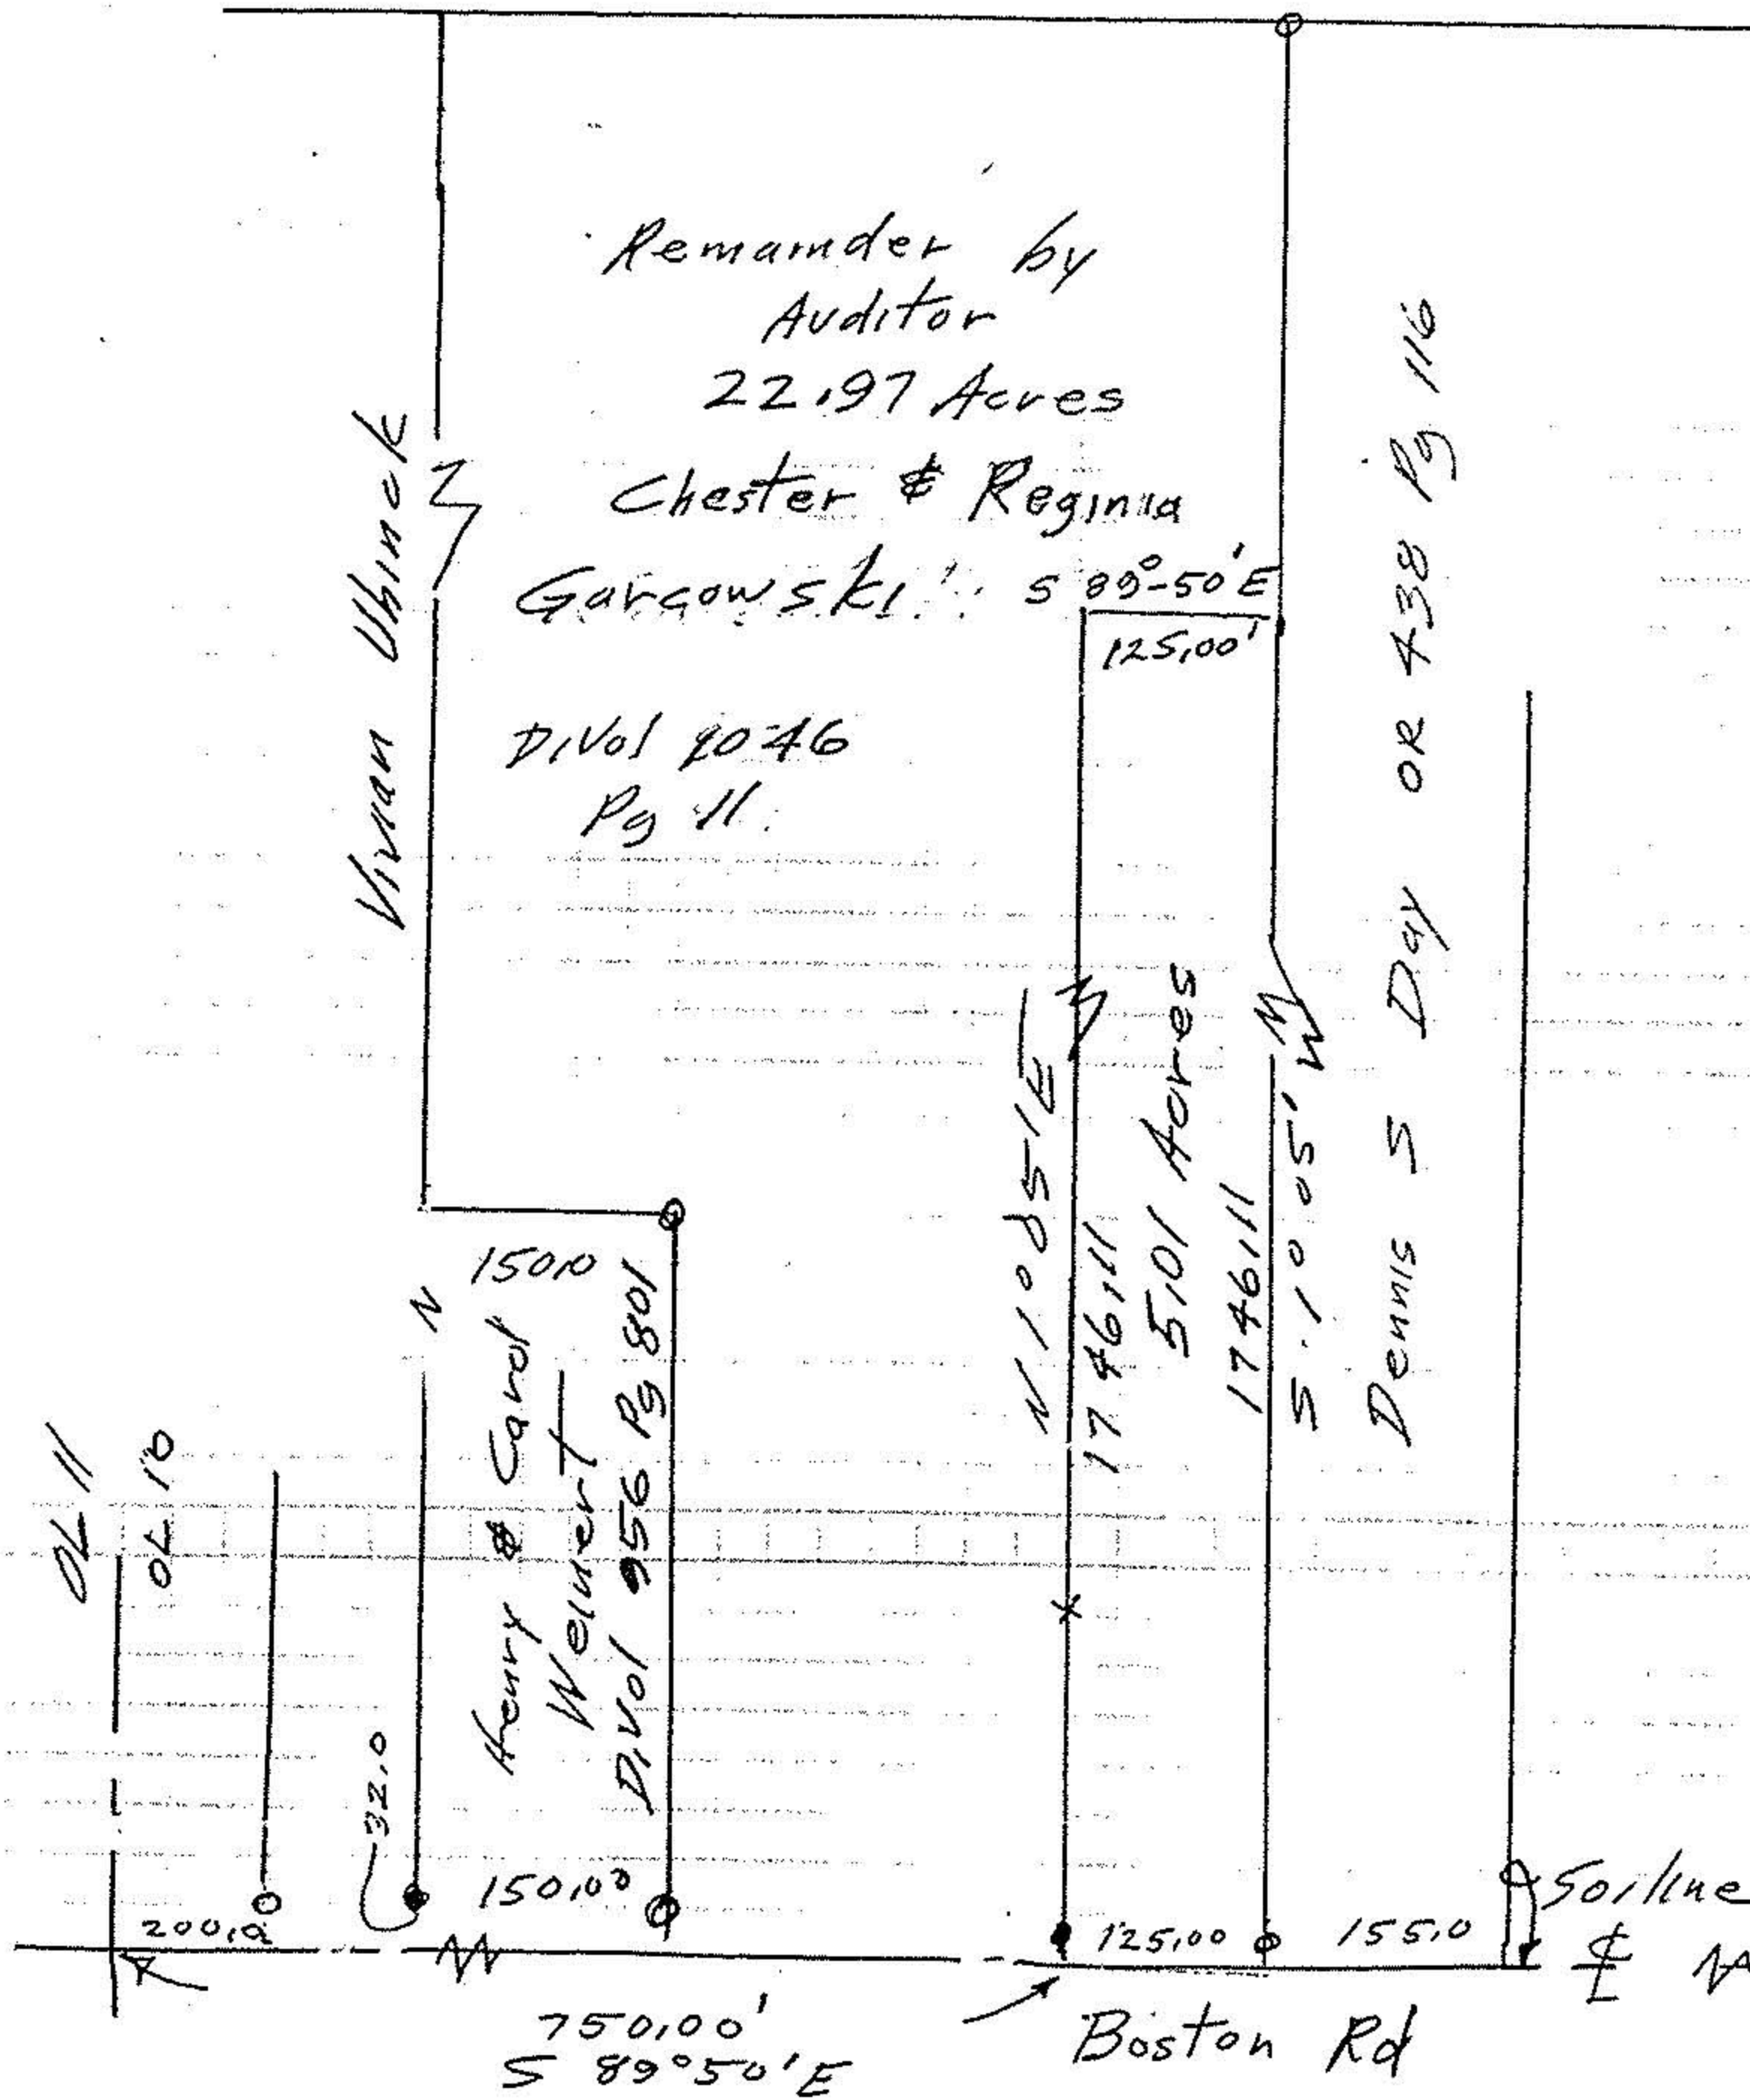

20007

APPROVED LORAIN CO. MAP DEPT.	
DATE 7-28-92	
Soil line abate 12-H	
BY CAROLYN FRANCIS	
VOID AFTER	# 20007

- iron pipes fd
- o iron pipes set

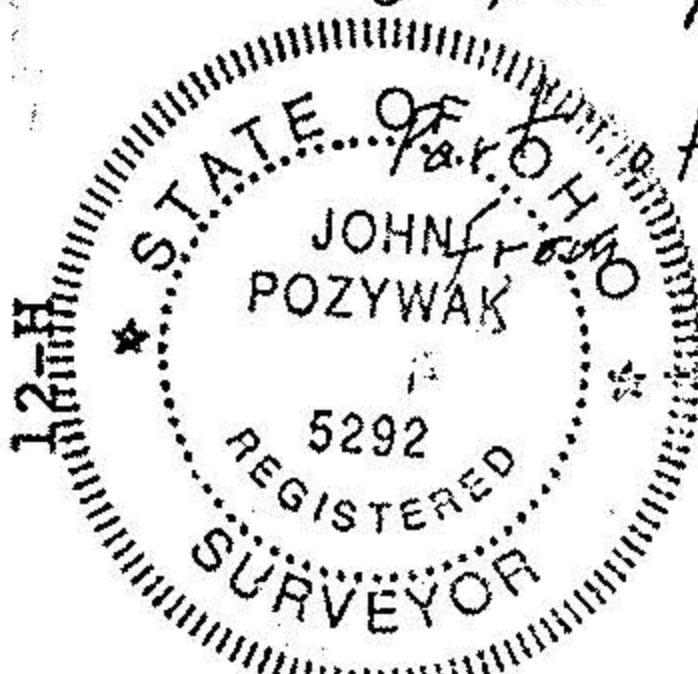

f survey data
FB 8 Pg 38
John Pozywak
Reg Surveyor
5292

Survey of a five acre
Parcel Split

Part of Original Lot 10
Columbia Township
Lorain County Ohio

Scale 1" = 200'