

CLARK ROAD 40'

1531.88

335.00

40'

225'

12-04-4


12-00-004-000

LAYENE BRADYAN
VOL. 319 PG. 174
L.C.D.R.

COLUMBIA TWP
STRONGSVILLE TWP

725.00


725.00

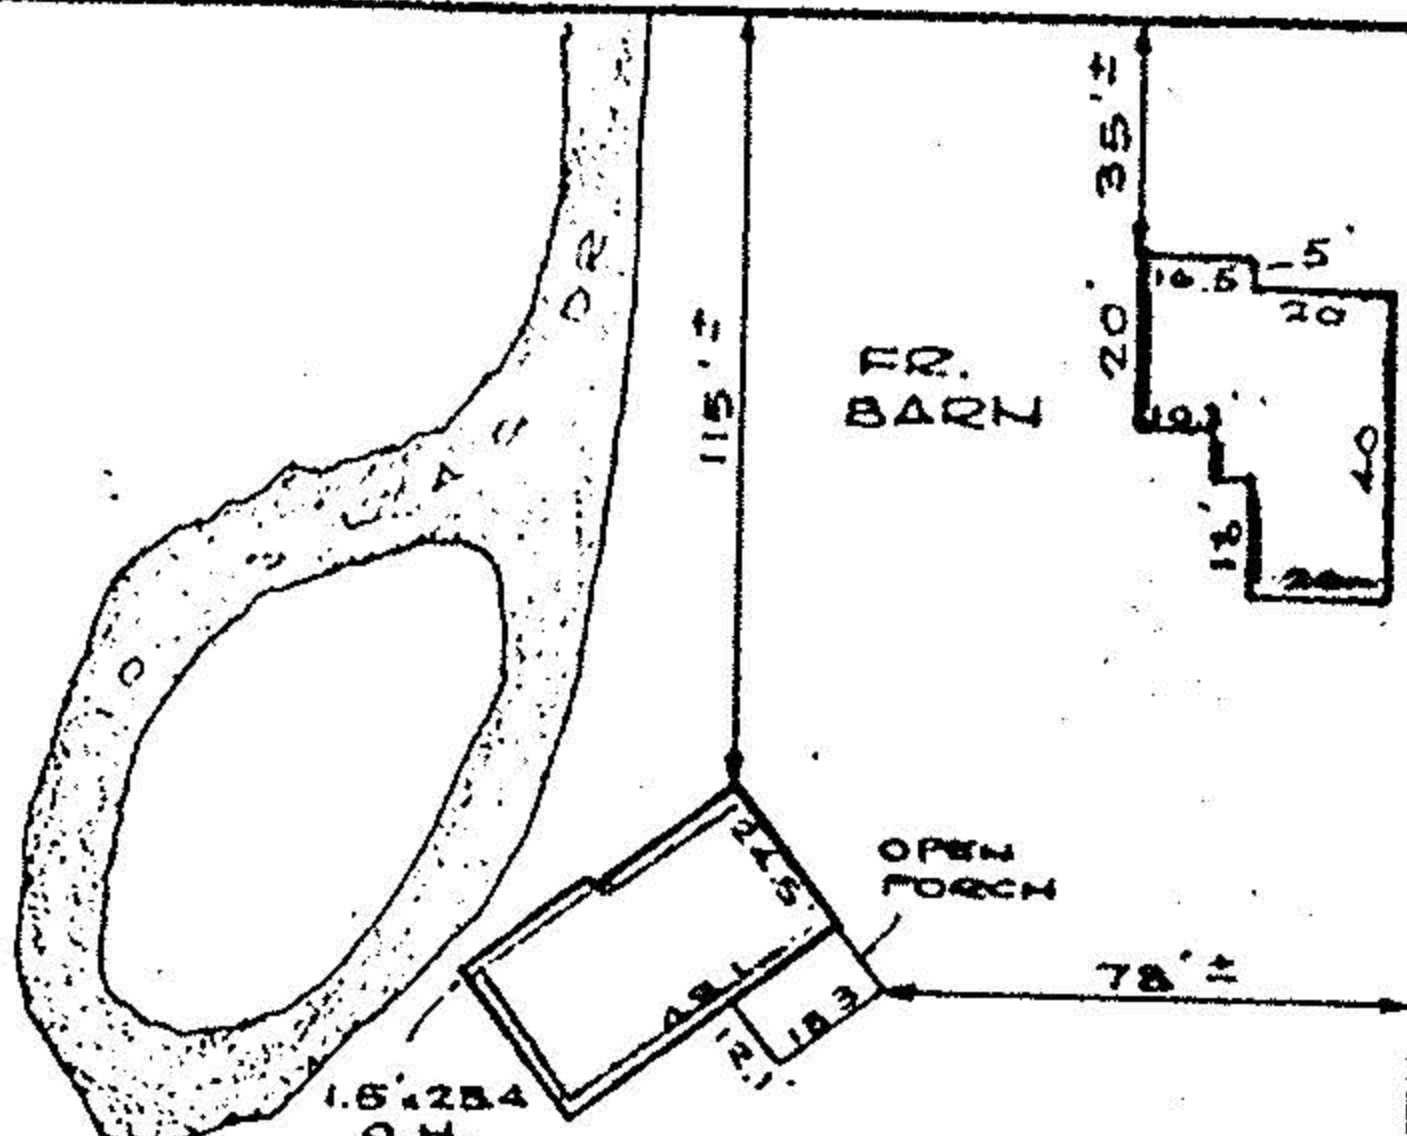

12-00-004-000

12-00-004-B

WILLIAM M. & MARJORIE F. COLE
VOL. 775 PG. 106 L.C.D.R.
5.576 Ac.

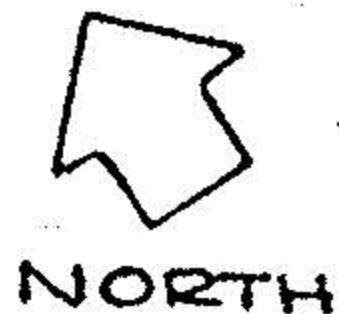

335.00

12-00-004-B
-00-211
926L

NEFF & ASSOCIATES Consulting Engineers and Surveyors CLEVELAND - ELYRIA, OHIO

This MORTGAGEE'S INSPECTION was prepared for IDENTIFICATION PURPOSES for the MORTGAGEE in connection with a new mortgage, and is not intended or represented to be a land or property line survey. NO corners were set. Do not use for establishing fence or building line.

SCALE	1" = 60'
DATE	4-16-74
JOB No.	27080
TITLE No.	E-4869