



12-00-028
12-G

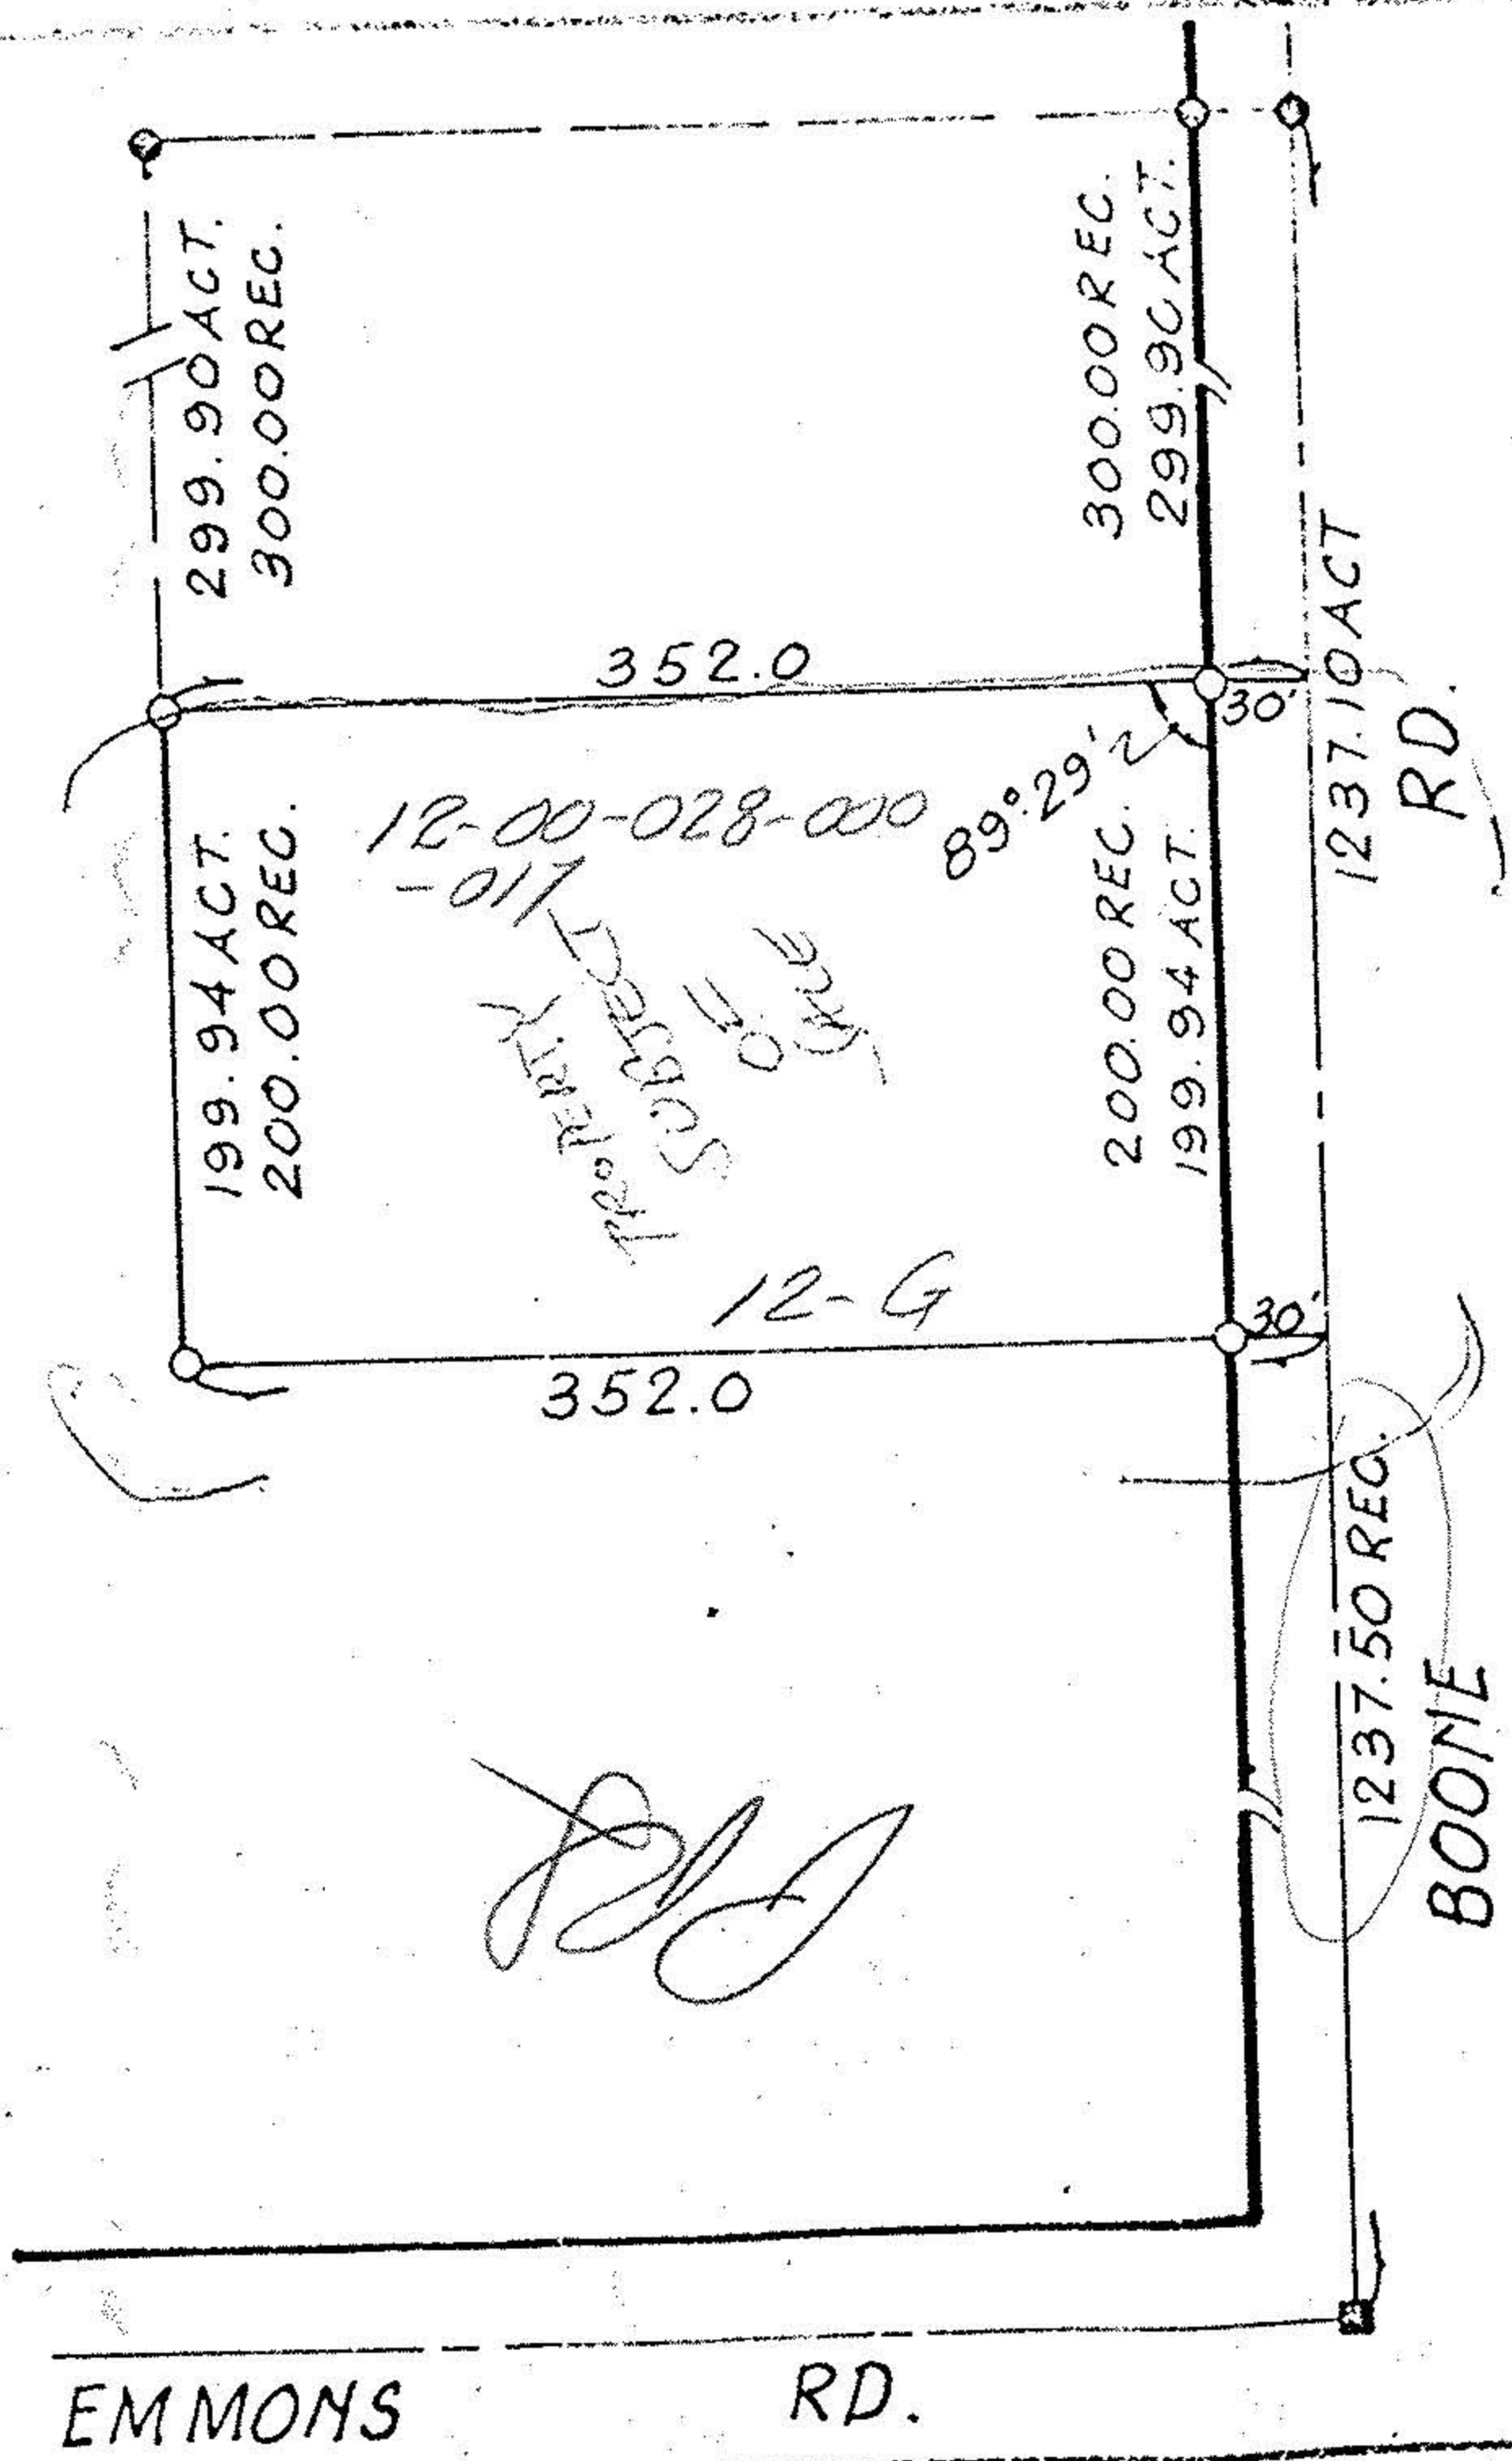

12-00-028-000-017
 PROJECT
 FILE

[Handwritten Signature]

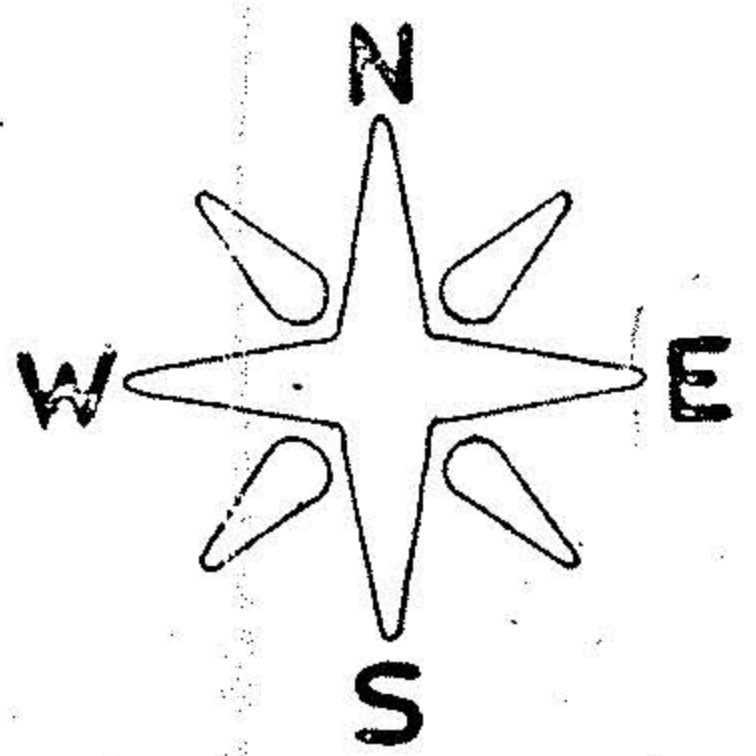

LEGEND:
 ○ I.P. SET
 ● I.P. FD.
 ■ STONE FD.

12-00-028-000-017
 1.61 Ac.

LOT No. 28	Tr. or Sec.:
TOWNSHIP: COLUMBIA	
COUNTY: LORAIN STATE: OHIO	
OWNER: ERNEST J. + LUCILLE A. TOTH	
DATE: DEC. 1973 SCALE: 1"=100'	
JOHN A. BAMBECK, P.S. REGISTERED SURVEYOR No. 5141	

EMMONS RD.

BOONE RD.