



STATE ROUTE 252  
(MALLETT CREEK - BAY VILLAGE RD)  
(COPPOPA - EAST RIVER RD)  
N 2°55'00"W

1194.00 COUNTY & MSD.

1. PIN SET  
120.25  
120.25

430.00 DEED & OBS.  
1. PIPE FD.  
125.00  
125.00

N 89° 07' 00" W. 795.22 DEED & OBS.

UARGA, ROSVETE  
1187/1792

FENCE USED  
N 89° 07' 00" W. 774.96 D.M.

N 1°50'20" W.  
92.85

013  
41.70

FENCE, PIPE FD.  
0.72 L.M.

CRAPENTER, ABEL E.  
GRACE A.  
308/329

FENCE  
N 73° 14' 27" E.  
832.60 OBS.  
838.20 DEED

LOT 34 = 41.699 AC.

69.987 AC.  
5.00  
28.29A.

N 1°56'45" E  
1419.00 DEED & OBS.  
1387.07 DEED & OBS.

SUMMAD, MELINDA  
CORNING  
973/1111

- 020

LOT 34

LOT 27

LOT 33

LOT 28

N 89° 50' 20" E 1442.75 OBS

N 88° 42' 30" W

946.78 OBS

1. PIN FD.  
500.43 OBS

MARTIN, ALEX J.  
MARGARETA  
1316/282

N 89° 47' 56" W SQUIRE ROAD

483.12 DEED & MSD.

125.00  
0 L.M.

125.00  
0 L.M.

N 0°30'00"E  
1386.43

019  
N 0°30'00"E  
1386.43 DEED & OBS.

018  
N 0°30'00"E  
1386.43

FENCE  
N 89° 47' 56" W 885.72 DEED & MSD.

N 1°56'45" E  
31.93 DEED  
& MSD.

1. PIPE FD.  
0.37 L.M.

1. PIPE FD.  
125.00

1. PIPE FD.  
0.37 L.M.

1. PIPE FD.  
0.37 L.M.

1373.76 DEED & MSD  
TREE LINE & FENCE USED


1. PIN SET

FENCE USED

BOONE ROAD

12-G  
12-00-027-000  
12-00-034-000 - 013

SURVEY  
OF  
69.987 AC. IN STATE ROUTE 252 (MALLETT CREEK - BAY VILLAGE RD)  
OF PART OF (COPPOPA - EAST RIVER RD)  
COLUMBIA TOWNSHIP LOTS 27 & 34  
IN  
COLUMBIA TOWNSHIP LORAIN COUNTY, OHIO  
FOR  
RICHARD & MARY BESS ROSS  
BY  
THE HENRY G. REITZ ENGINEERING COMPANY  
BY Donald E. Wike V. PRES.  
SCALE 1"=200' FEB. 1984

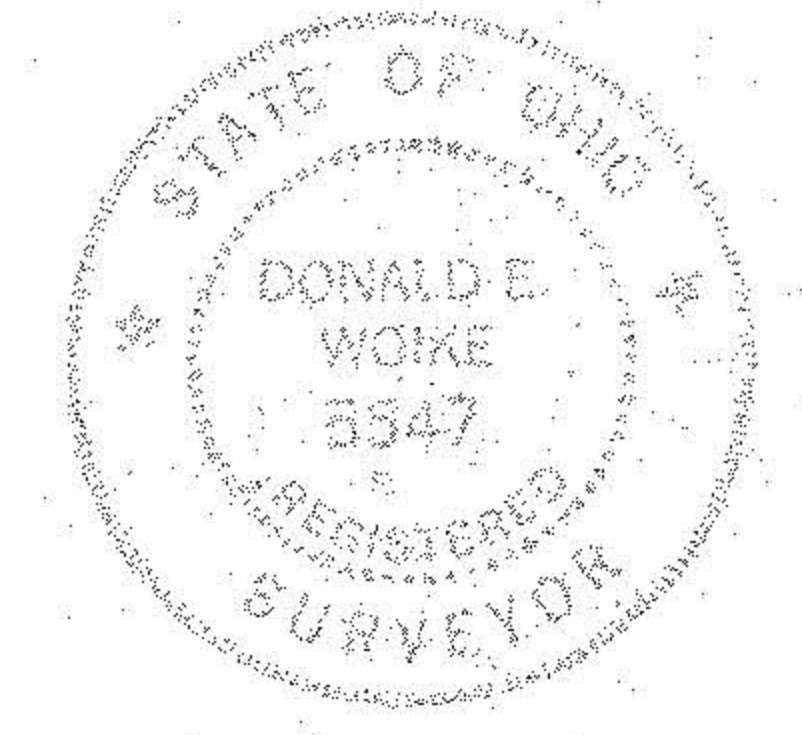

#15514  
APPROVED  
LORAIN CO. MAP DEPT.  
DATE 4.12.84  
PAGE 12-G  
BY T. McNeil  
1010 PIER