


MARKS RO. NO. 16 E

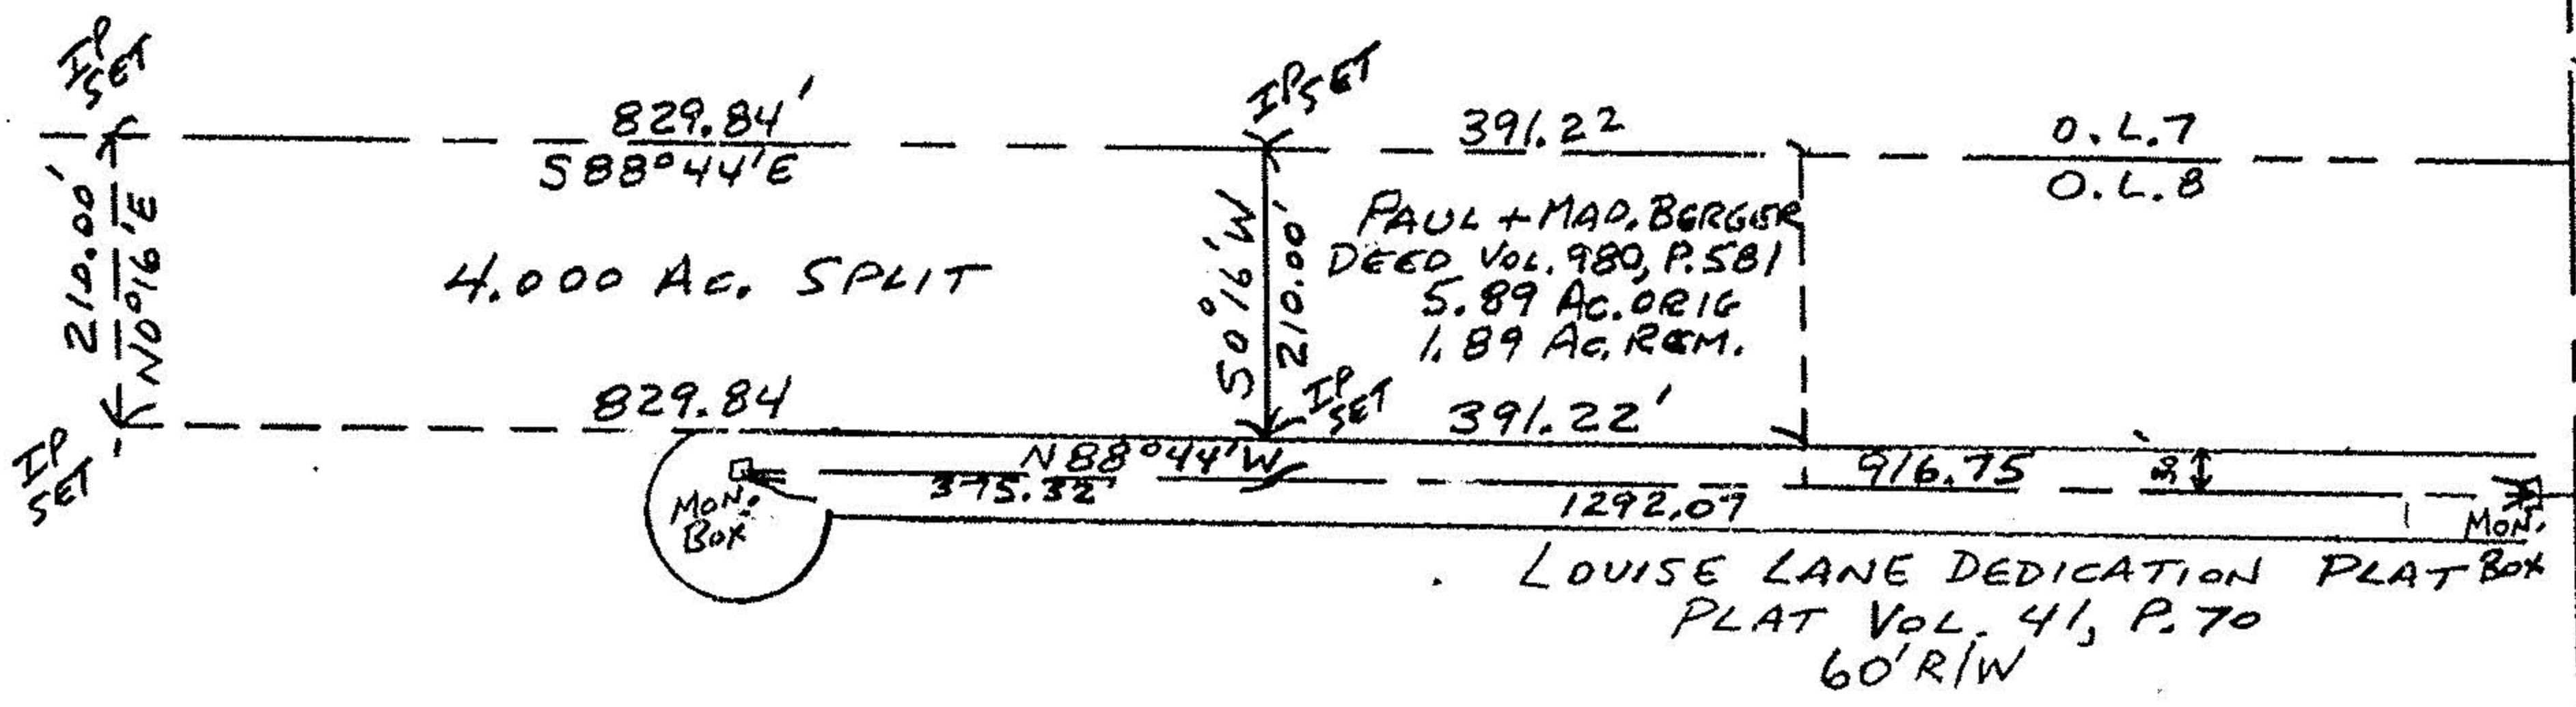

MAP OF SURVEY FOR DOUG KEYSE
O.L. 8 - COLUMBIA TWP. - LORAIN CO.
MAY 1991 SCALE 1" = 200'
JOHN R. HAMILTON - REG. SURVEYOR #6861

NORTH
SCALE 1" = 200'

#19425
APPROVED LORAIN CO. MAP DEPT.
DATE 6-17-91
PAGE 1200-008-B
BY CALOLYN FRANCIS
VOID # 19425