


ROYAL CREST GOLF CLUB INC.
 DEED VOL. 964, P. 643
 20.37 AC. ORIG., 20.026 AC. REM.



NORTH
 SCALE 1" = 100'

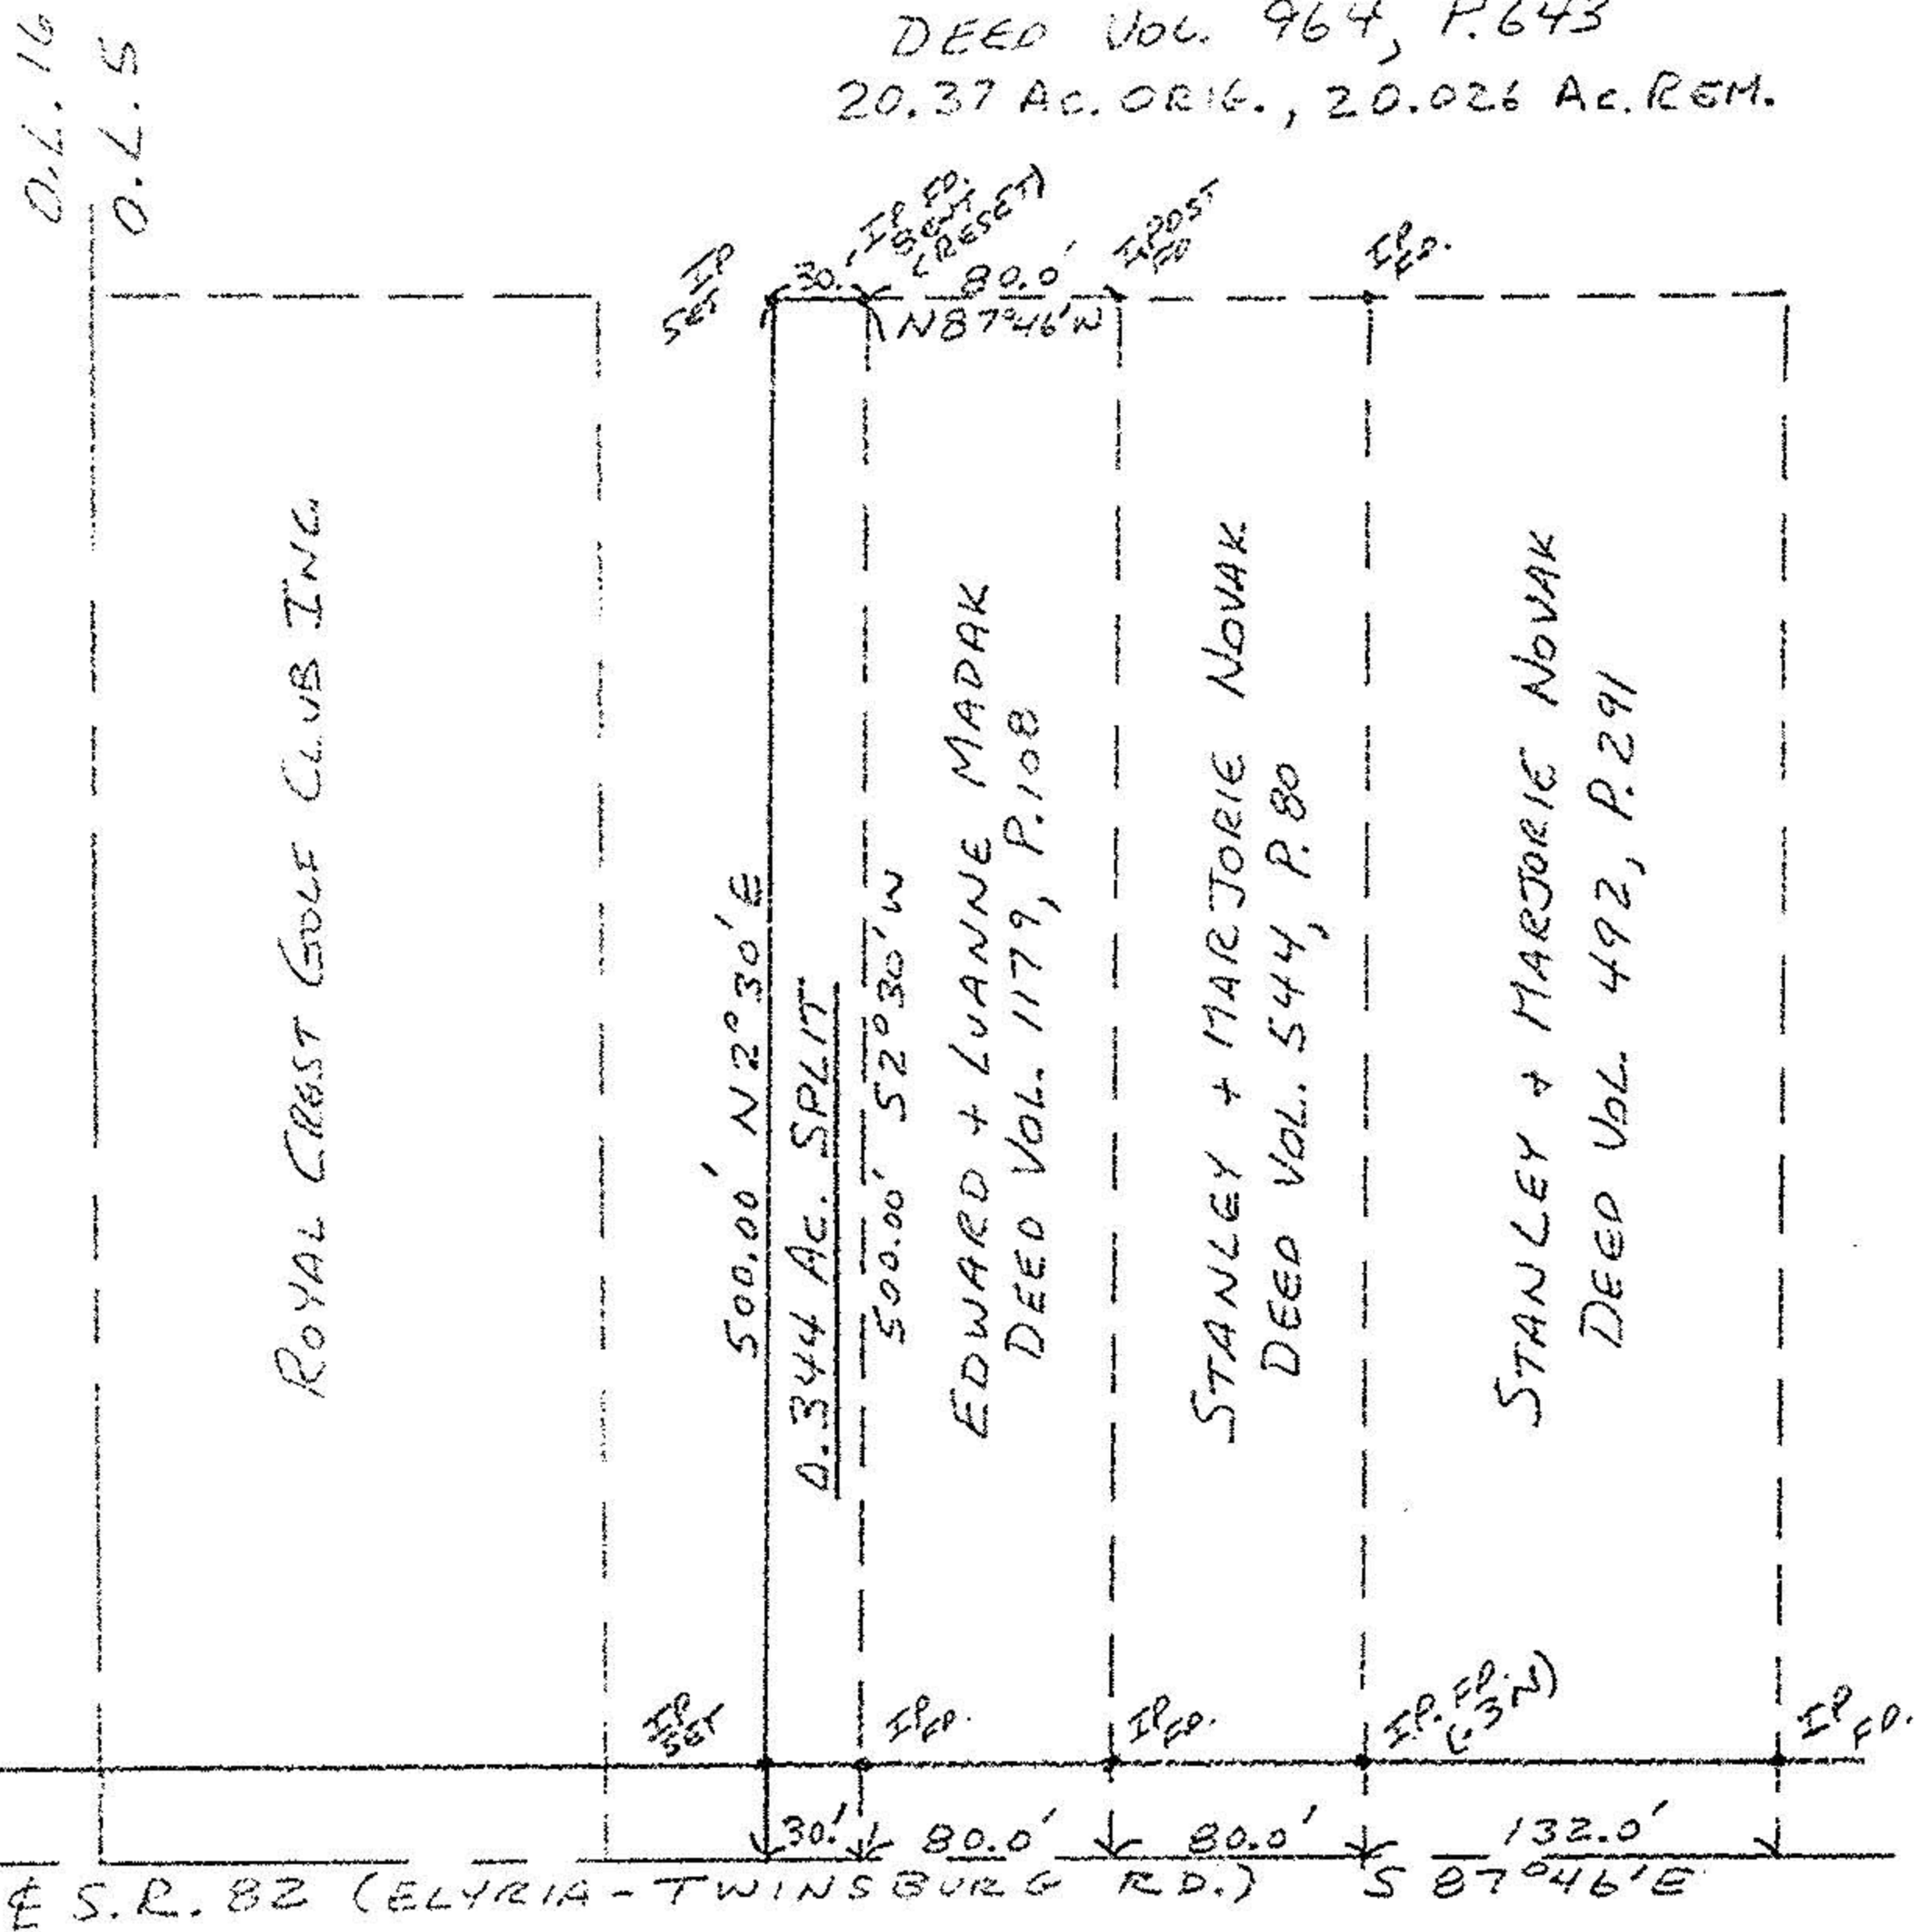

17977

APPROVED
LORAIN CO.
MAP DEPT.
DATE 6-7-88
PAGE 12-00-005A
BY [Signature]
VOID AFTER <input checked="" type="checkbox"/> 17977

MAP OF SURVEY OF 0.344 AC.
 SPLIT FOR EDWARD MADAK
 D.L. 5 - COLUMBIA TWP.
 JOHN R. HAMILTON - REG. SURV. #6861
 MAY, 1988 SCALE 1" = 100'