


SEE 12-00-008-A

50% REDUCED

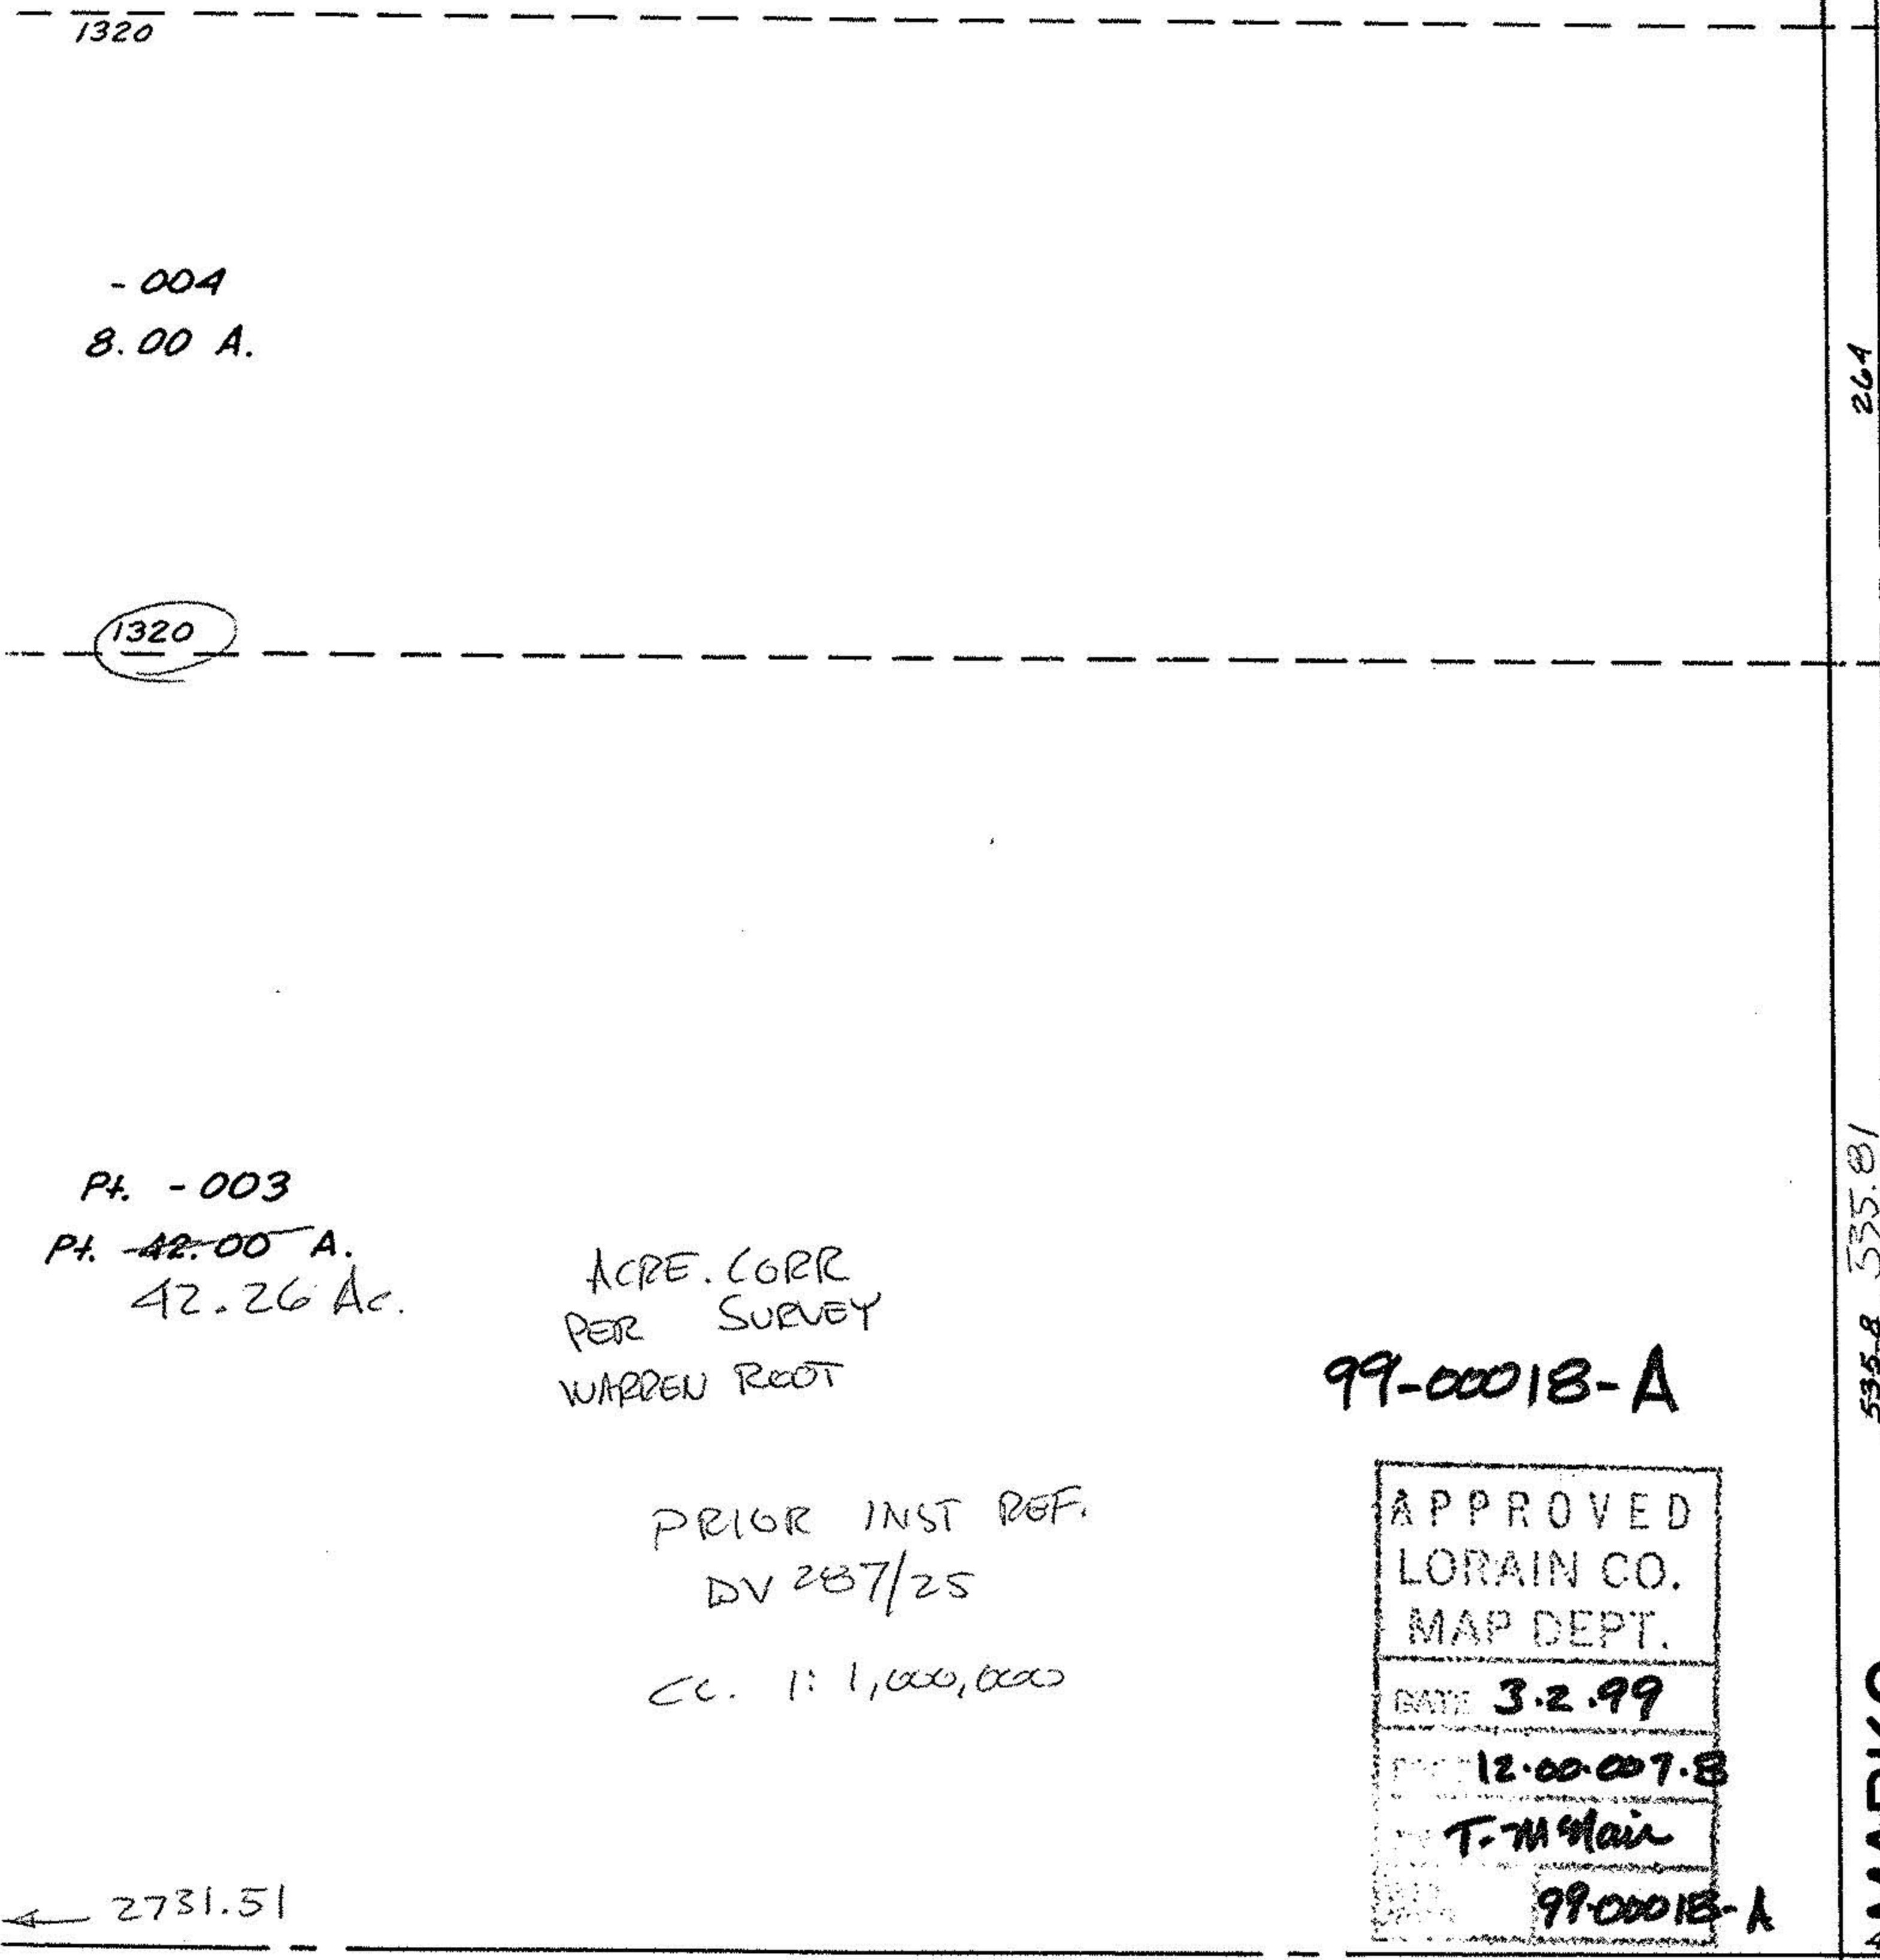

00-008-B

2007-B

264

535.8 535.81

MARKS

APPROVED
LORAIN CO.
MAP DEPT.
DATE 3.2.99
12.00.007-A
T. M. Main
99-00018-A

APPROVED
LORAIN CO.
MAP DEPT.
DATE 3.2.99
12.00.007-B
T. M. Main
99-00018-A