

20547

APPROVED
LORAIN CO.
MAP DEPT.

DATE 10-6-93

PAGE 3-00-038-B

BY CAROLYN
FRANLIS

VOID
AFTER # 20547

S 89° 46' E
8
BIR FF


West Shore Sub'd
Pivot 10 Pg.

- iron pipes set
- iron pipes fd

Survey for Russell Halstead

sublots 1, 2, 3 and north half of 4

sublots 5, 6, 7 and south half of 4

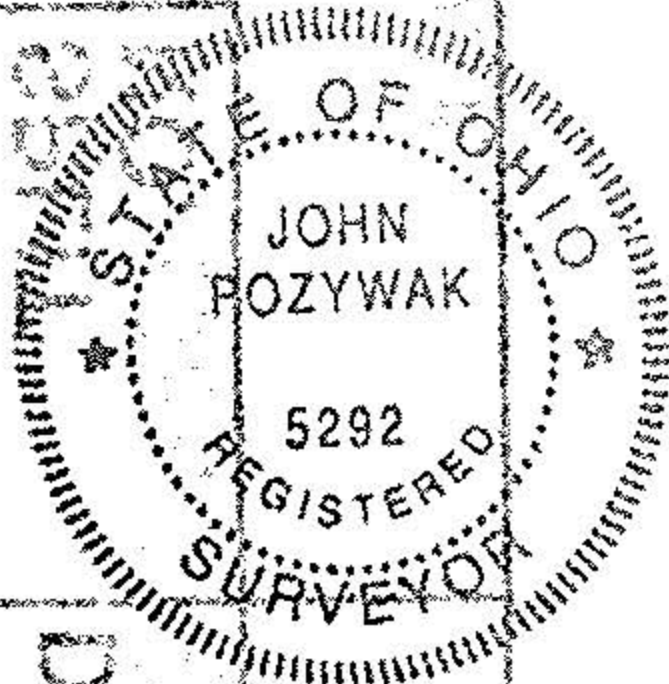

ORIGINAL LOT 38 DATE July 1993

TOWNSHIP Sheffield SCALE 1"=60'

CITY OF Sheffield Lake FIELD BOOK N/A

COUNTY OF Lorain DRAWN BY J. Poz

STATE OF Ohio CHECKED BY _____

W. O. _____ FILE NO. _____

DATE