

CITY OF SHEFFIELD LAKE, OHIO  
PLANNING COMMISSION

# SURVEY OF SUB LOTS

1/2 9, 10, 11


OF BORDER CITIES COMPANY  
SHORE SUBDIVISION  
IN SHEFFIELD LAKE

Plans Reviewed 3/6/91  
Approved [Signature]  
Disapproved \_\_\_\_\_

SCALE 1" = 20'

DEC. 1990

BY JOHN S PARDOE  
REC. SURV. NO. 5656

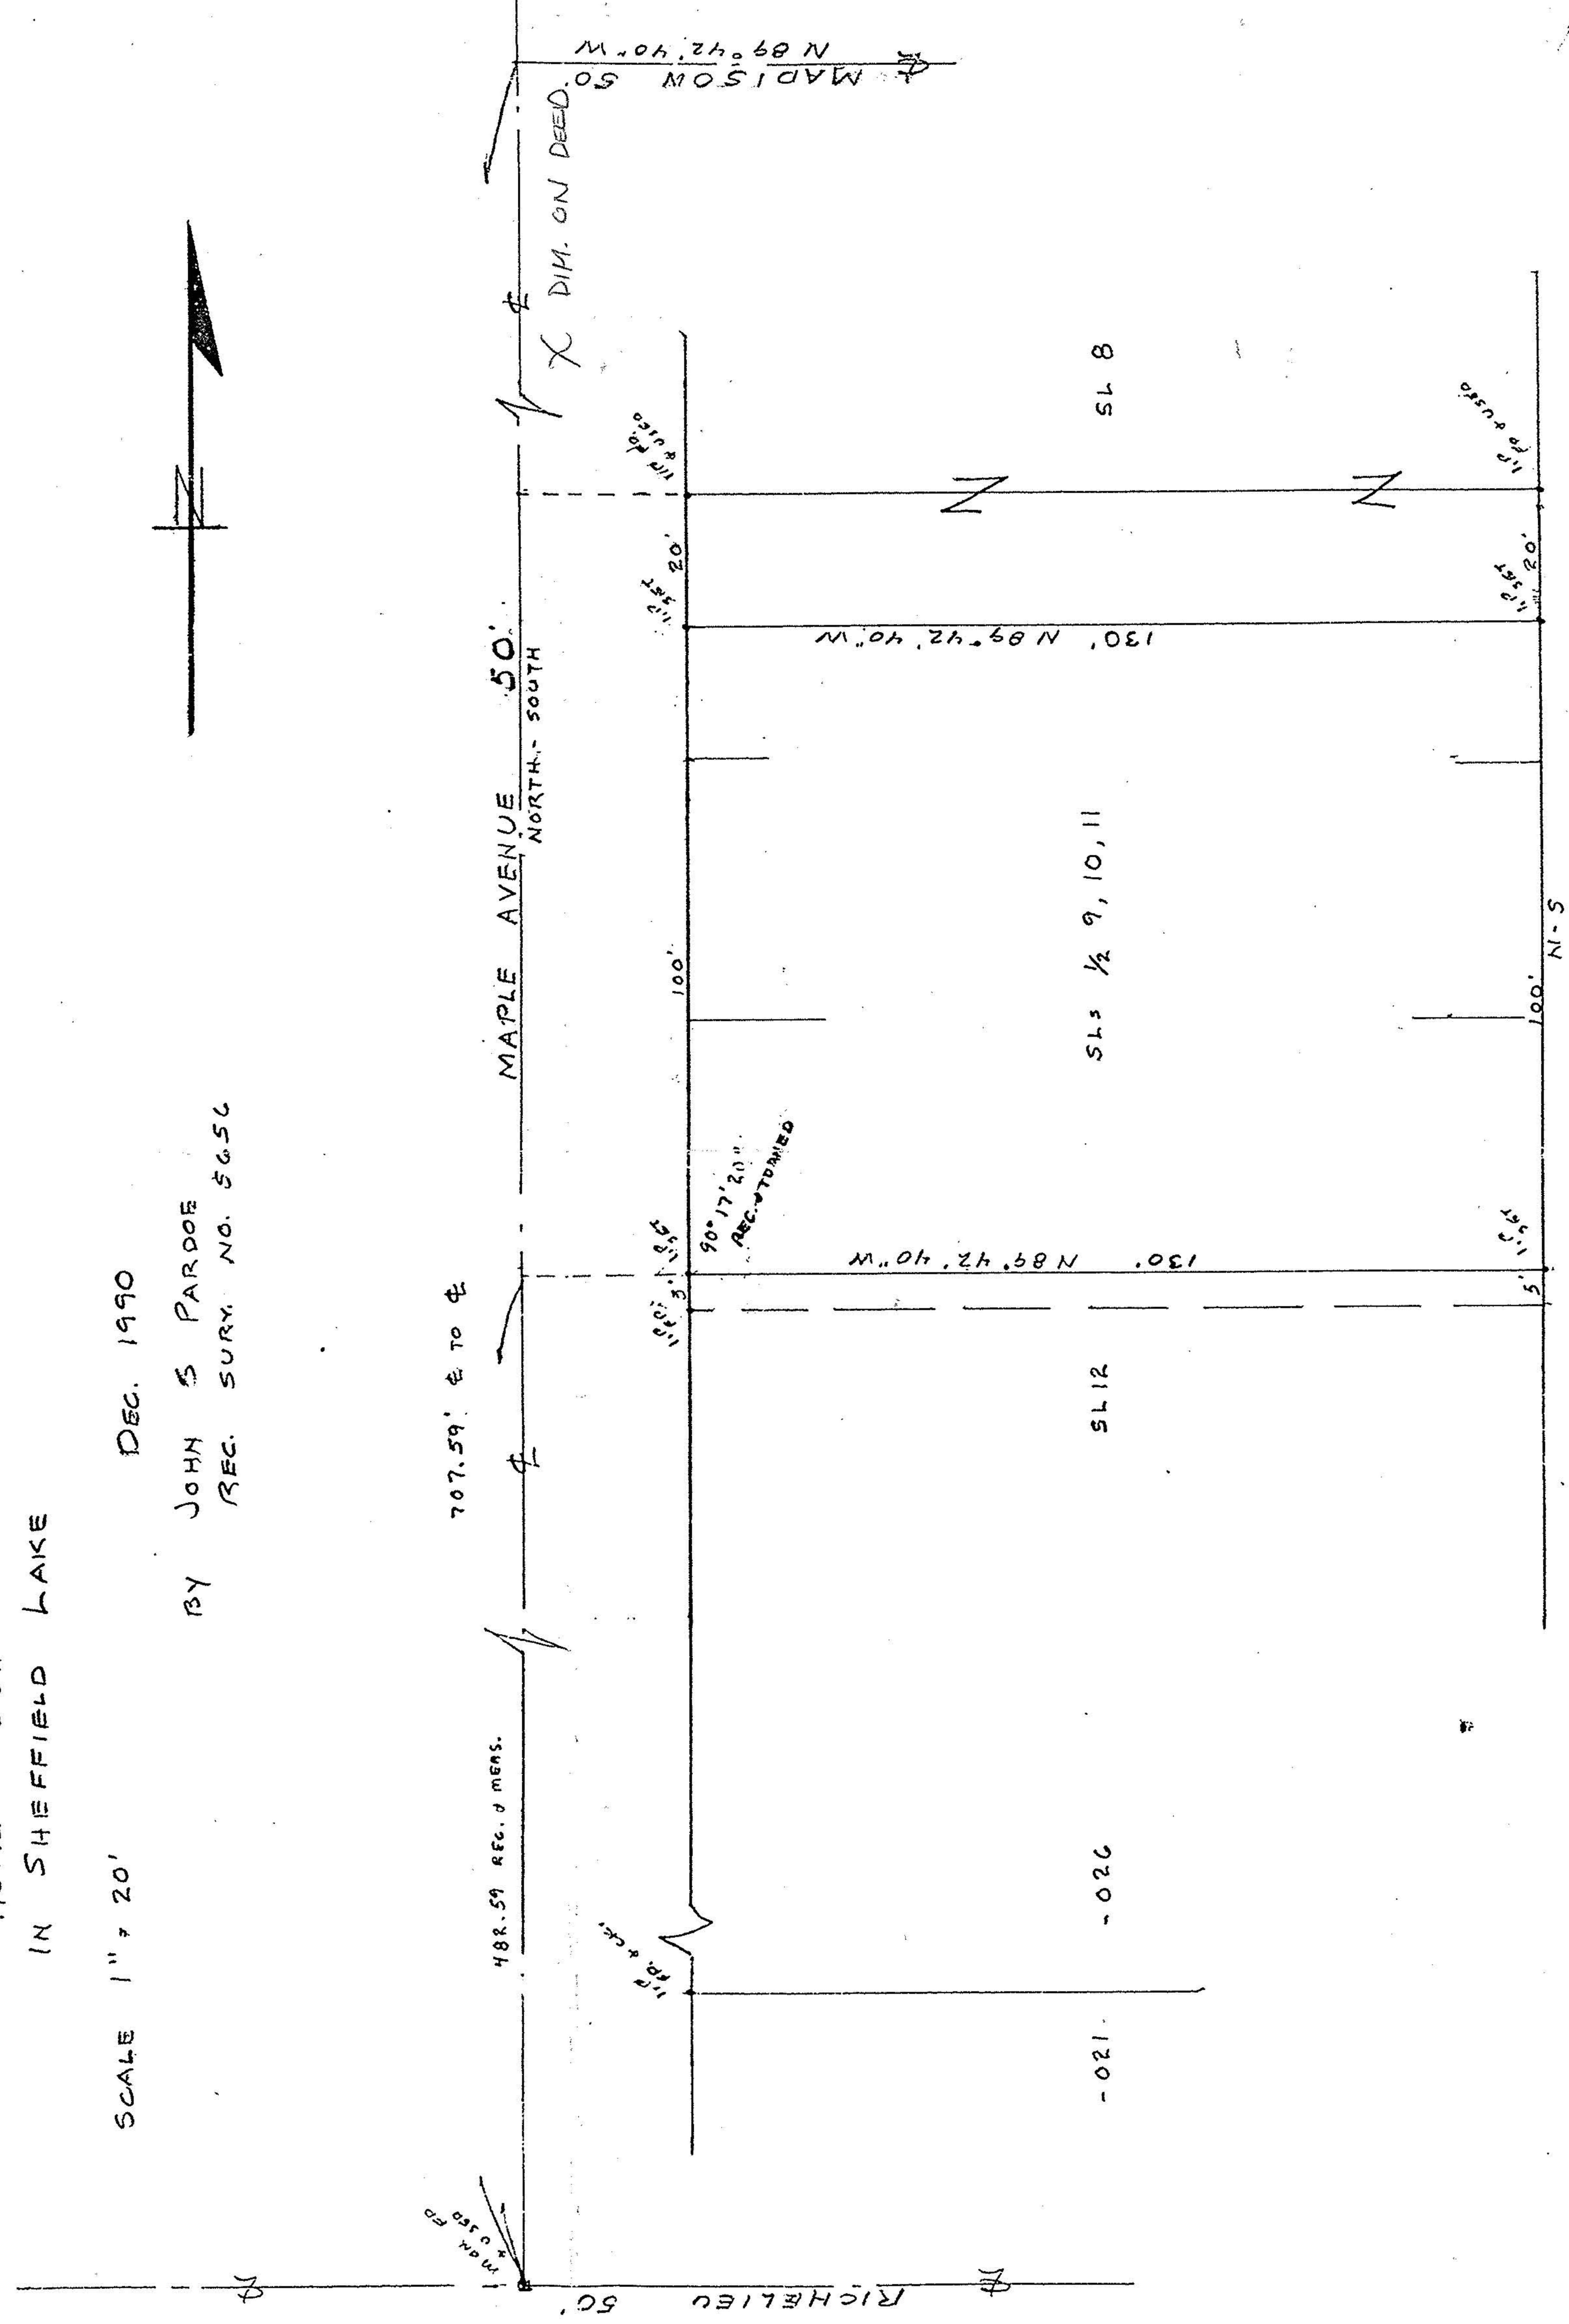

MAPLE AVENUE 50'  
NORTH-SOUTH

707.59' E TO E

482.59 REC. D MEAS.

RICHFIELD 50'

MADISON 50'  
N 89° 42' 40" W

X DIM. ON DEED.

112.5 FT  
112.5 FT

112.5 FT  
112.5 FT

100'

112.5 FT  
112.5 FT

90° 17' 20"  
REC. TURNED

130' N 89° 42' 40" W

130' N 89° 42' 40" W

SLs 1/2 9, 10, 11

SL 12

- 026

- 021

SL 8

112.5 FT  
112.5 FT

112.5 FT  
112.5 FT

100'

112.5 FT  
112.5 FT

N-S