


3-00-033-B

3-00-033-B
03-00-033-118-058

1" = 30'



COVE BEACH AVE. 48'

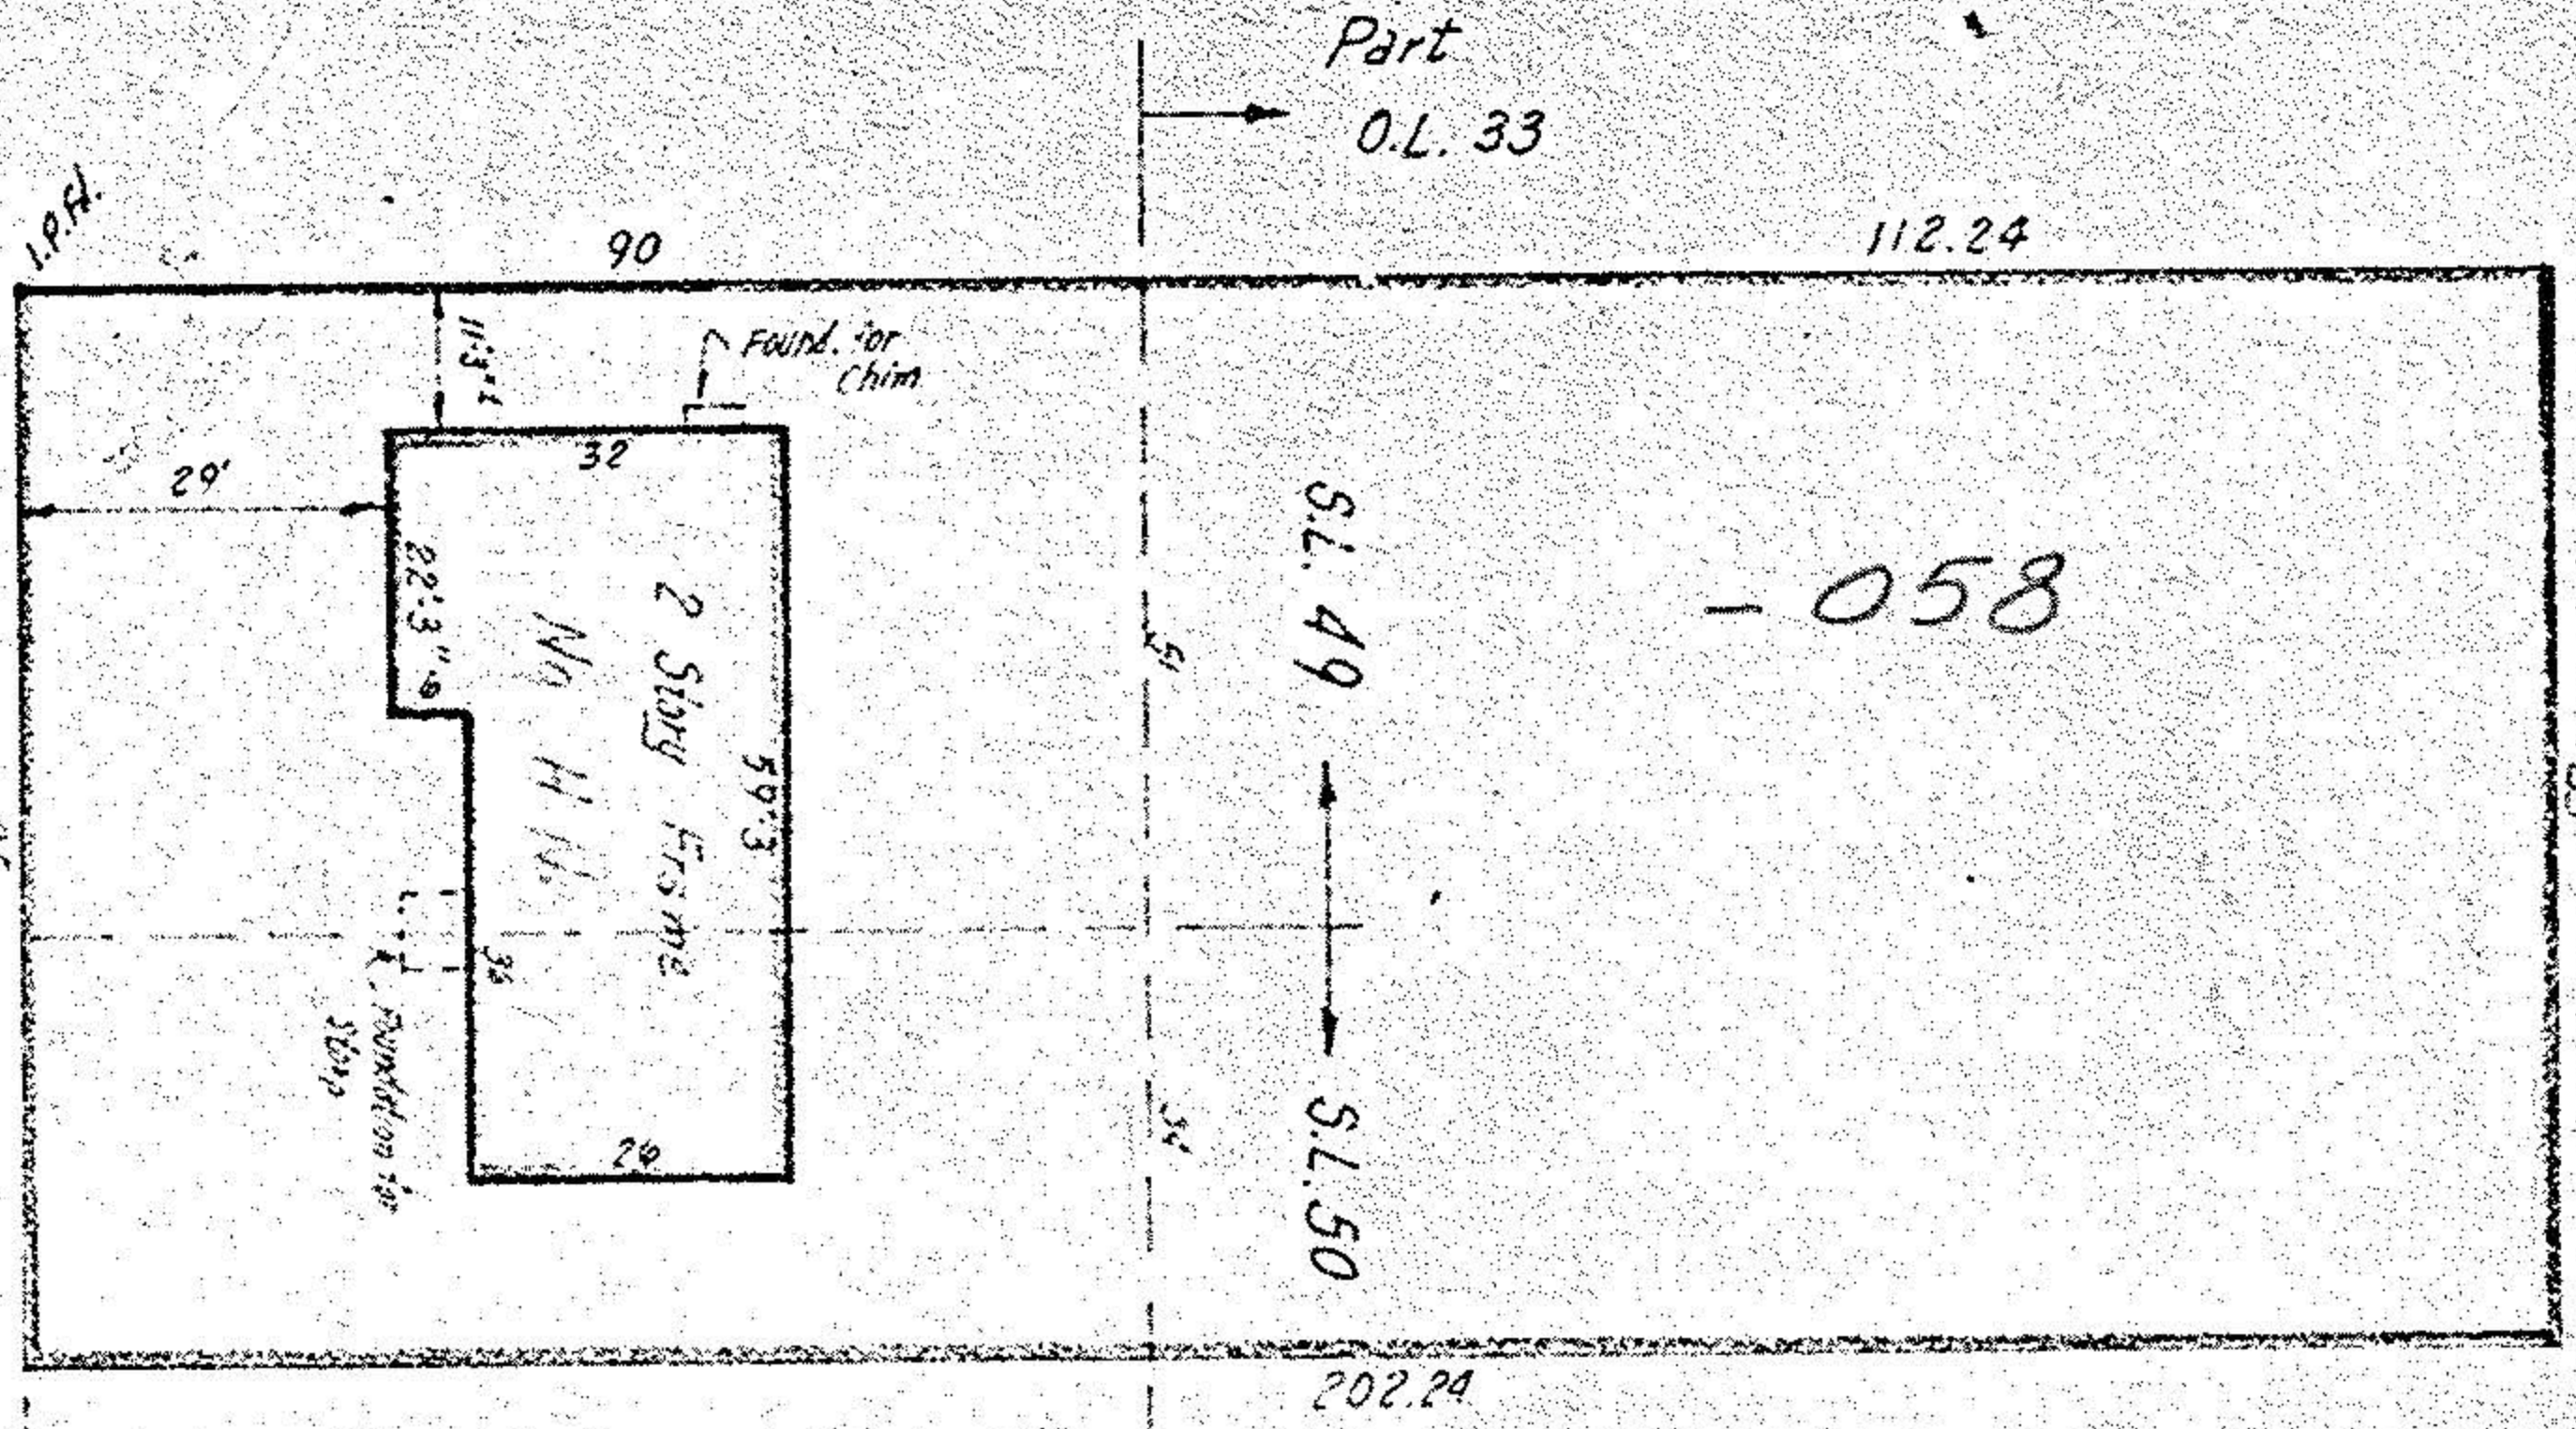

PART of SUBLLOT # 50 plus ALL of
 SUBLLOT # 49 of COVE BEACH ALLOTMENT
 PLAT VOL. II PAGE II plus
 PART of ORIG. SHEFFIELD TWP. LOT 33
 NOW in CITY of SHEFFIELD LAKE, OHIO

#1751	APPROVED	
	LORAIN CO.	
	MAP DEPT.	
	DATE 6-14-78	
	PAGE 3-00-033-B	
	BY T. McNeil	
VOID AFTER		

THIS IS NOT A PLAT OF SURVEY:
 FOR MORTGAGE LOAN PURPOSES ONLY

Mc GLINCHY & ASSOCIATES
 FEB. 14, 1978 *772534
 ST-L-8126