


Blackmore Grain & Cattle Co

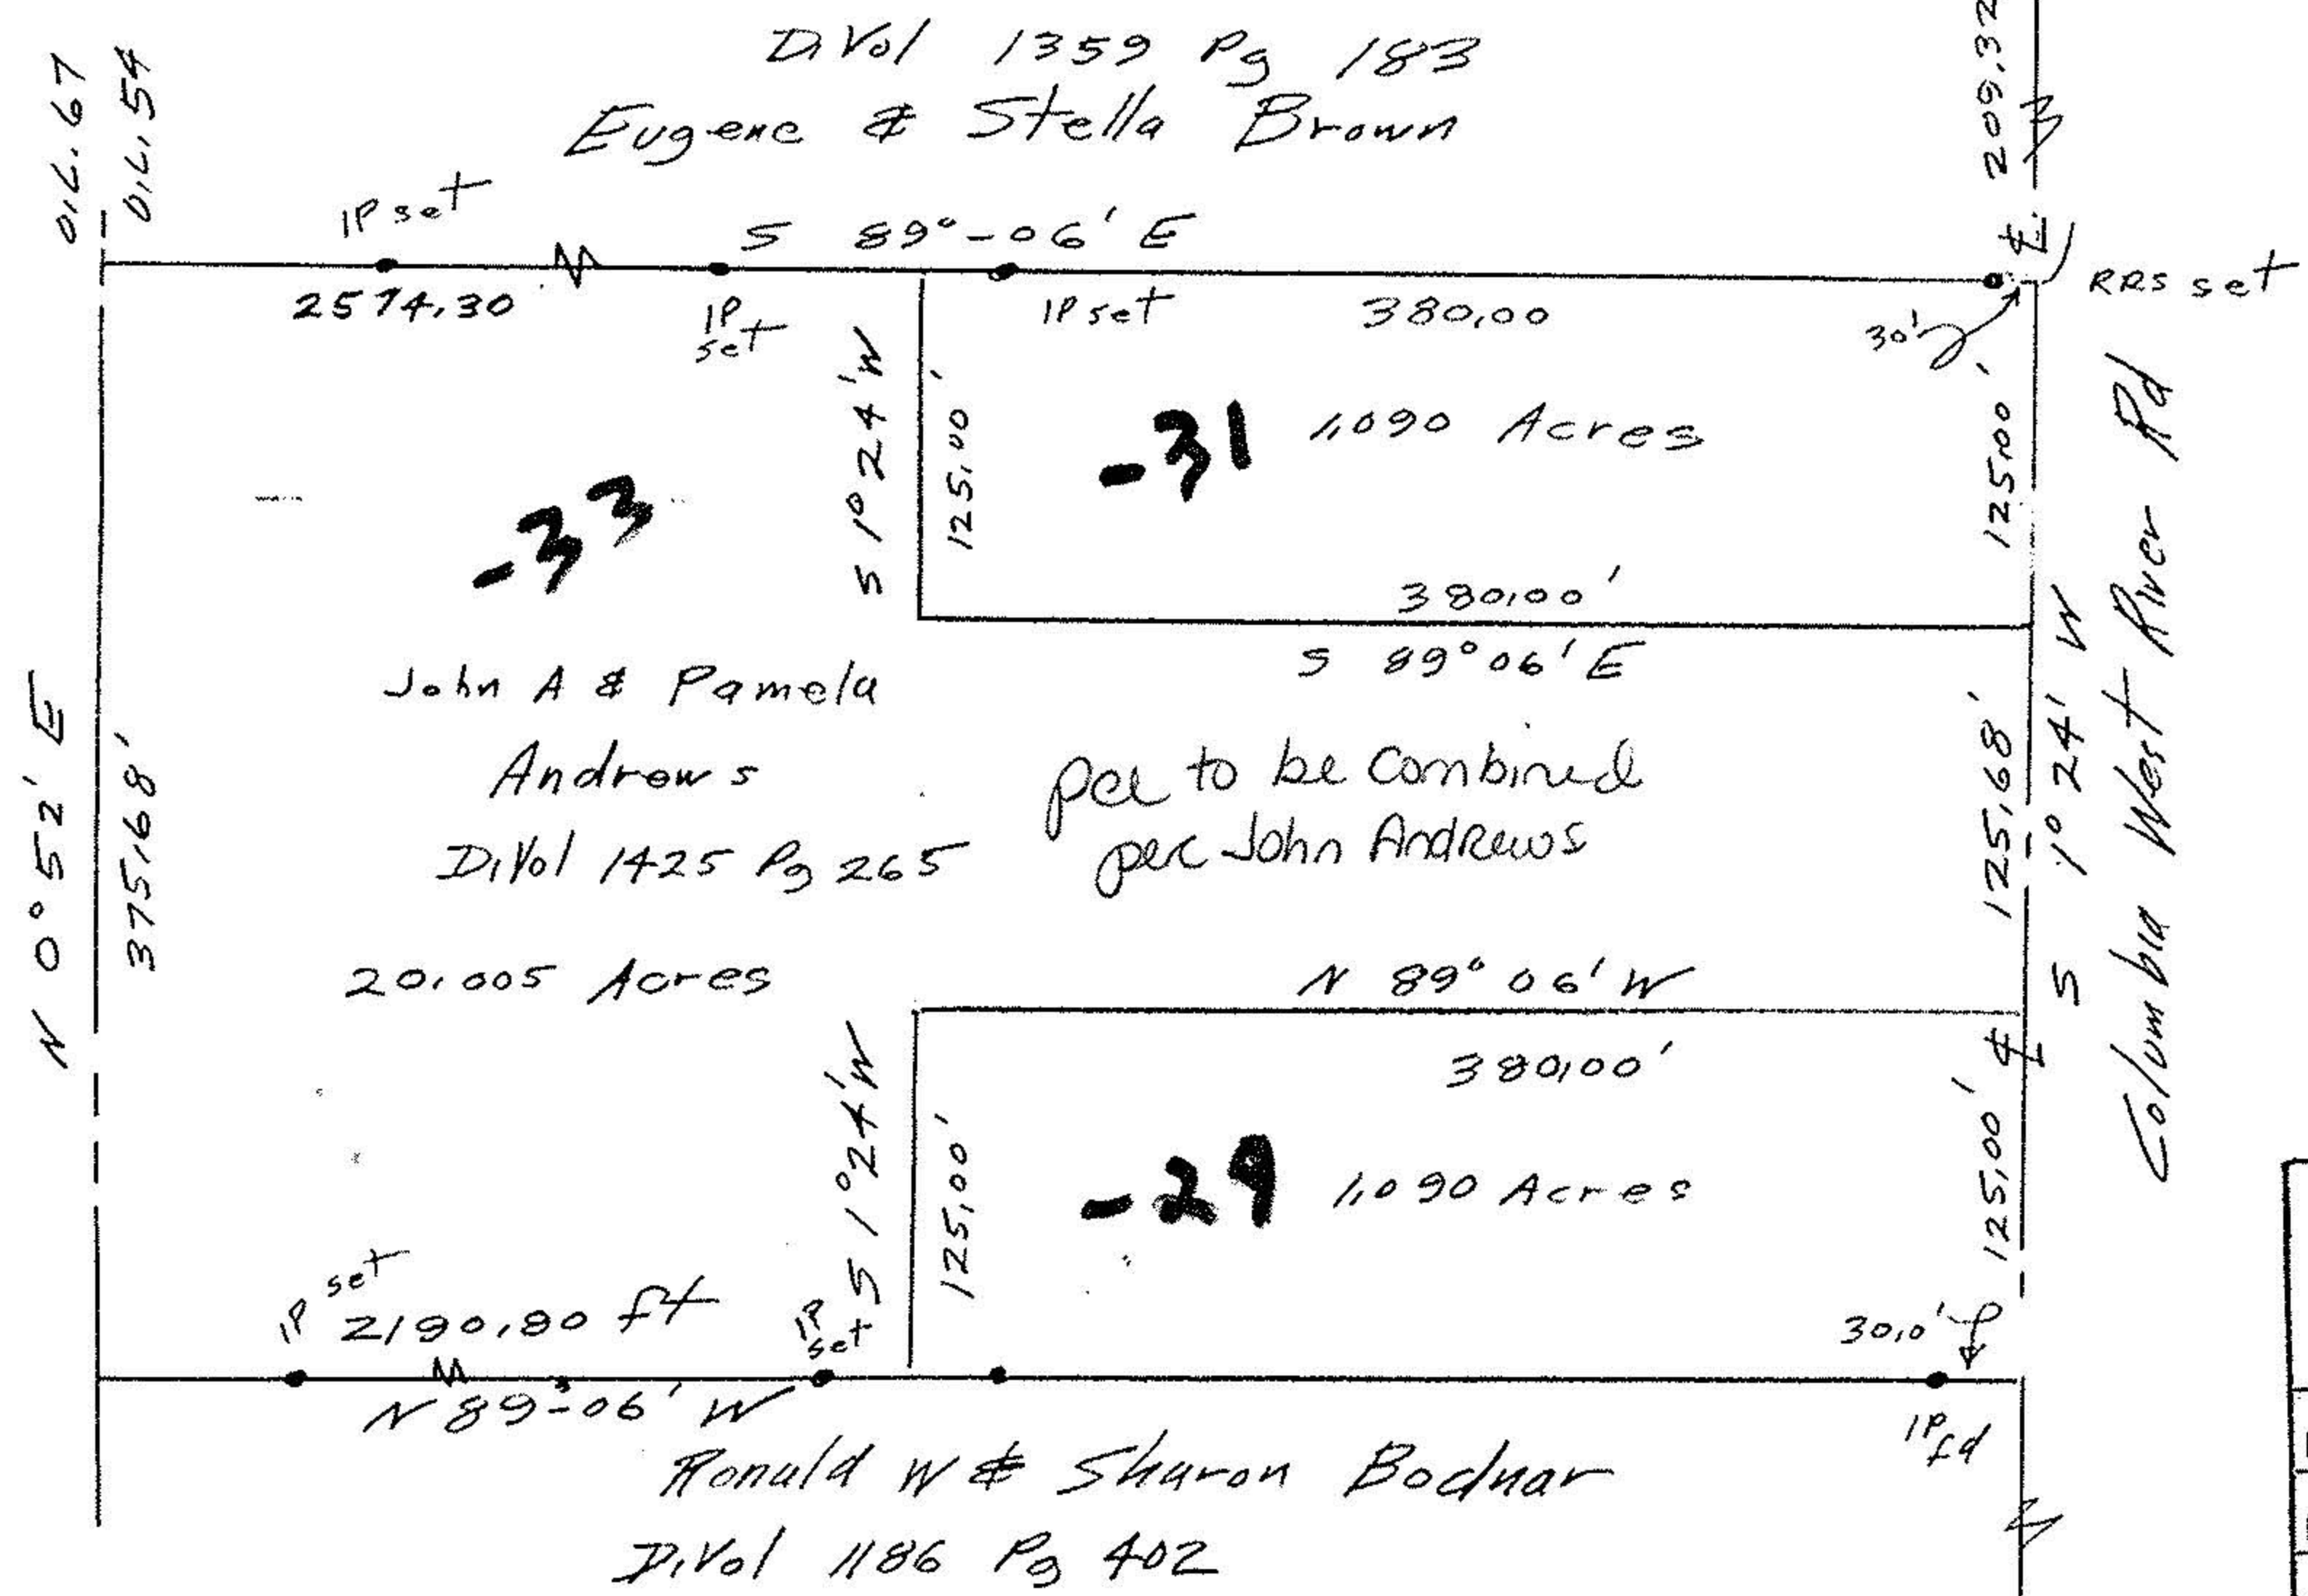

#18603

APPROVED  
LORAIN CO.  
MAP DEPT.

DATE 8-29-89

PAGE 12-00-054 B

CAROLYN  
BY FRANCIS

VOID AFTER # 18603



Previous surveys & matters of Record

John Poznyusak  
Reg Surveyor  
5292

Survey for John Andrews  
Part of Original Lot 54  
Columbia Township  
Lorain County Ohio  
Not to scale June 1989

ORIGINAL