
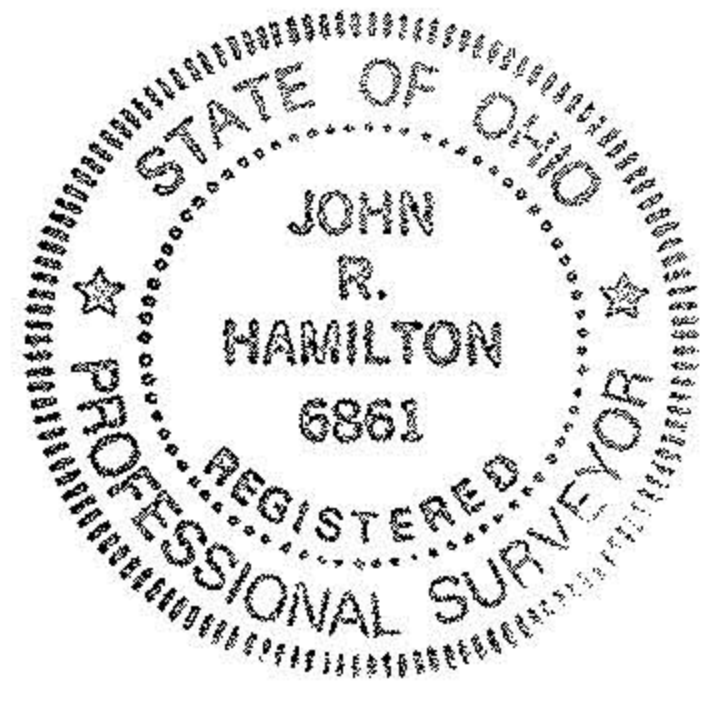


MAP OF SURVEY FOR VIOLA MILLER
 O.L. 65 - COLUMBIA TWP. - LORAIN Co.
 JOHN R. HAMILTON - REG. SURV. #6861
 NOV. 1986

NORTH
 SCALE 1"=100'

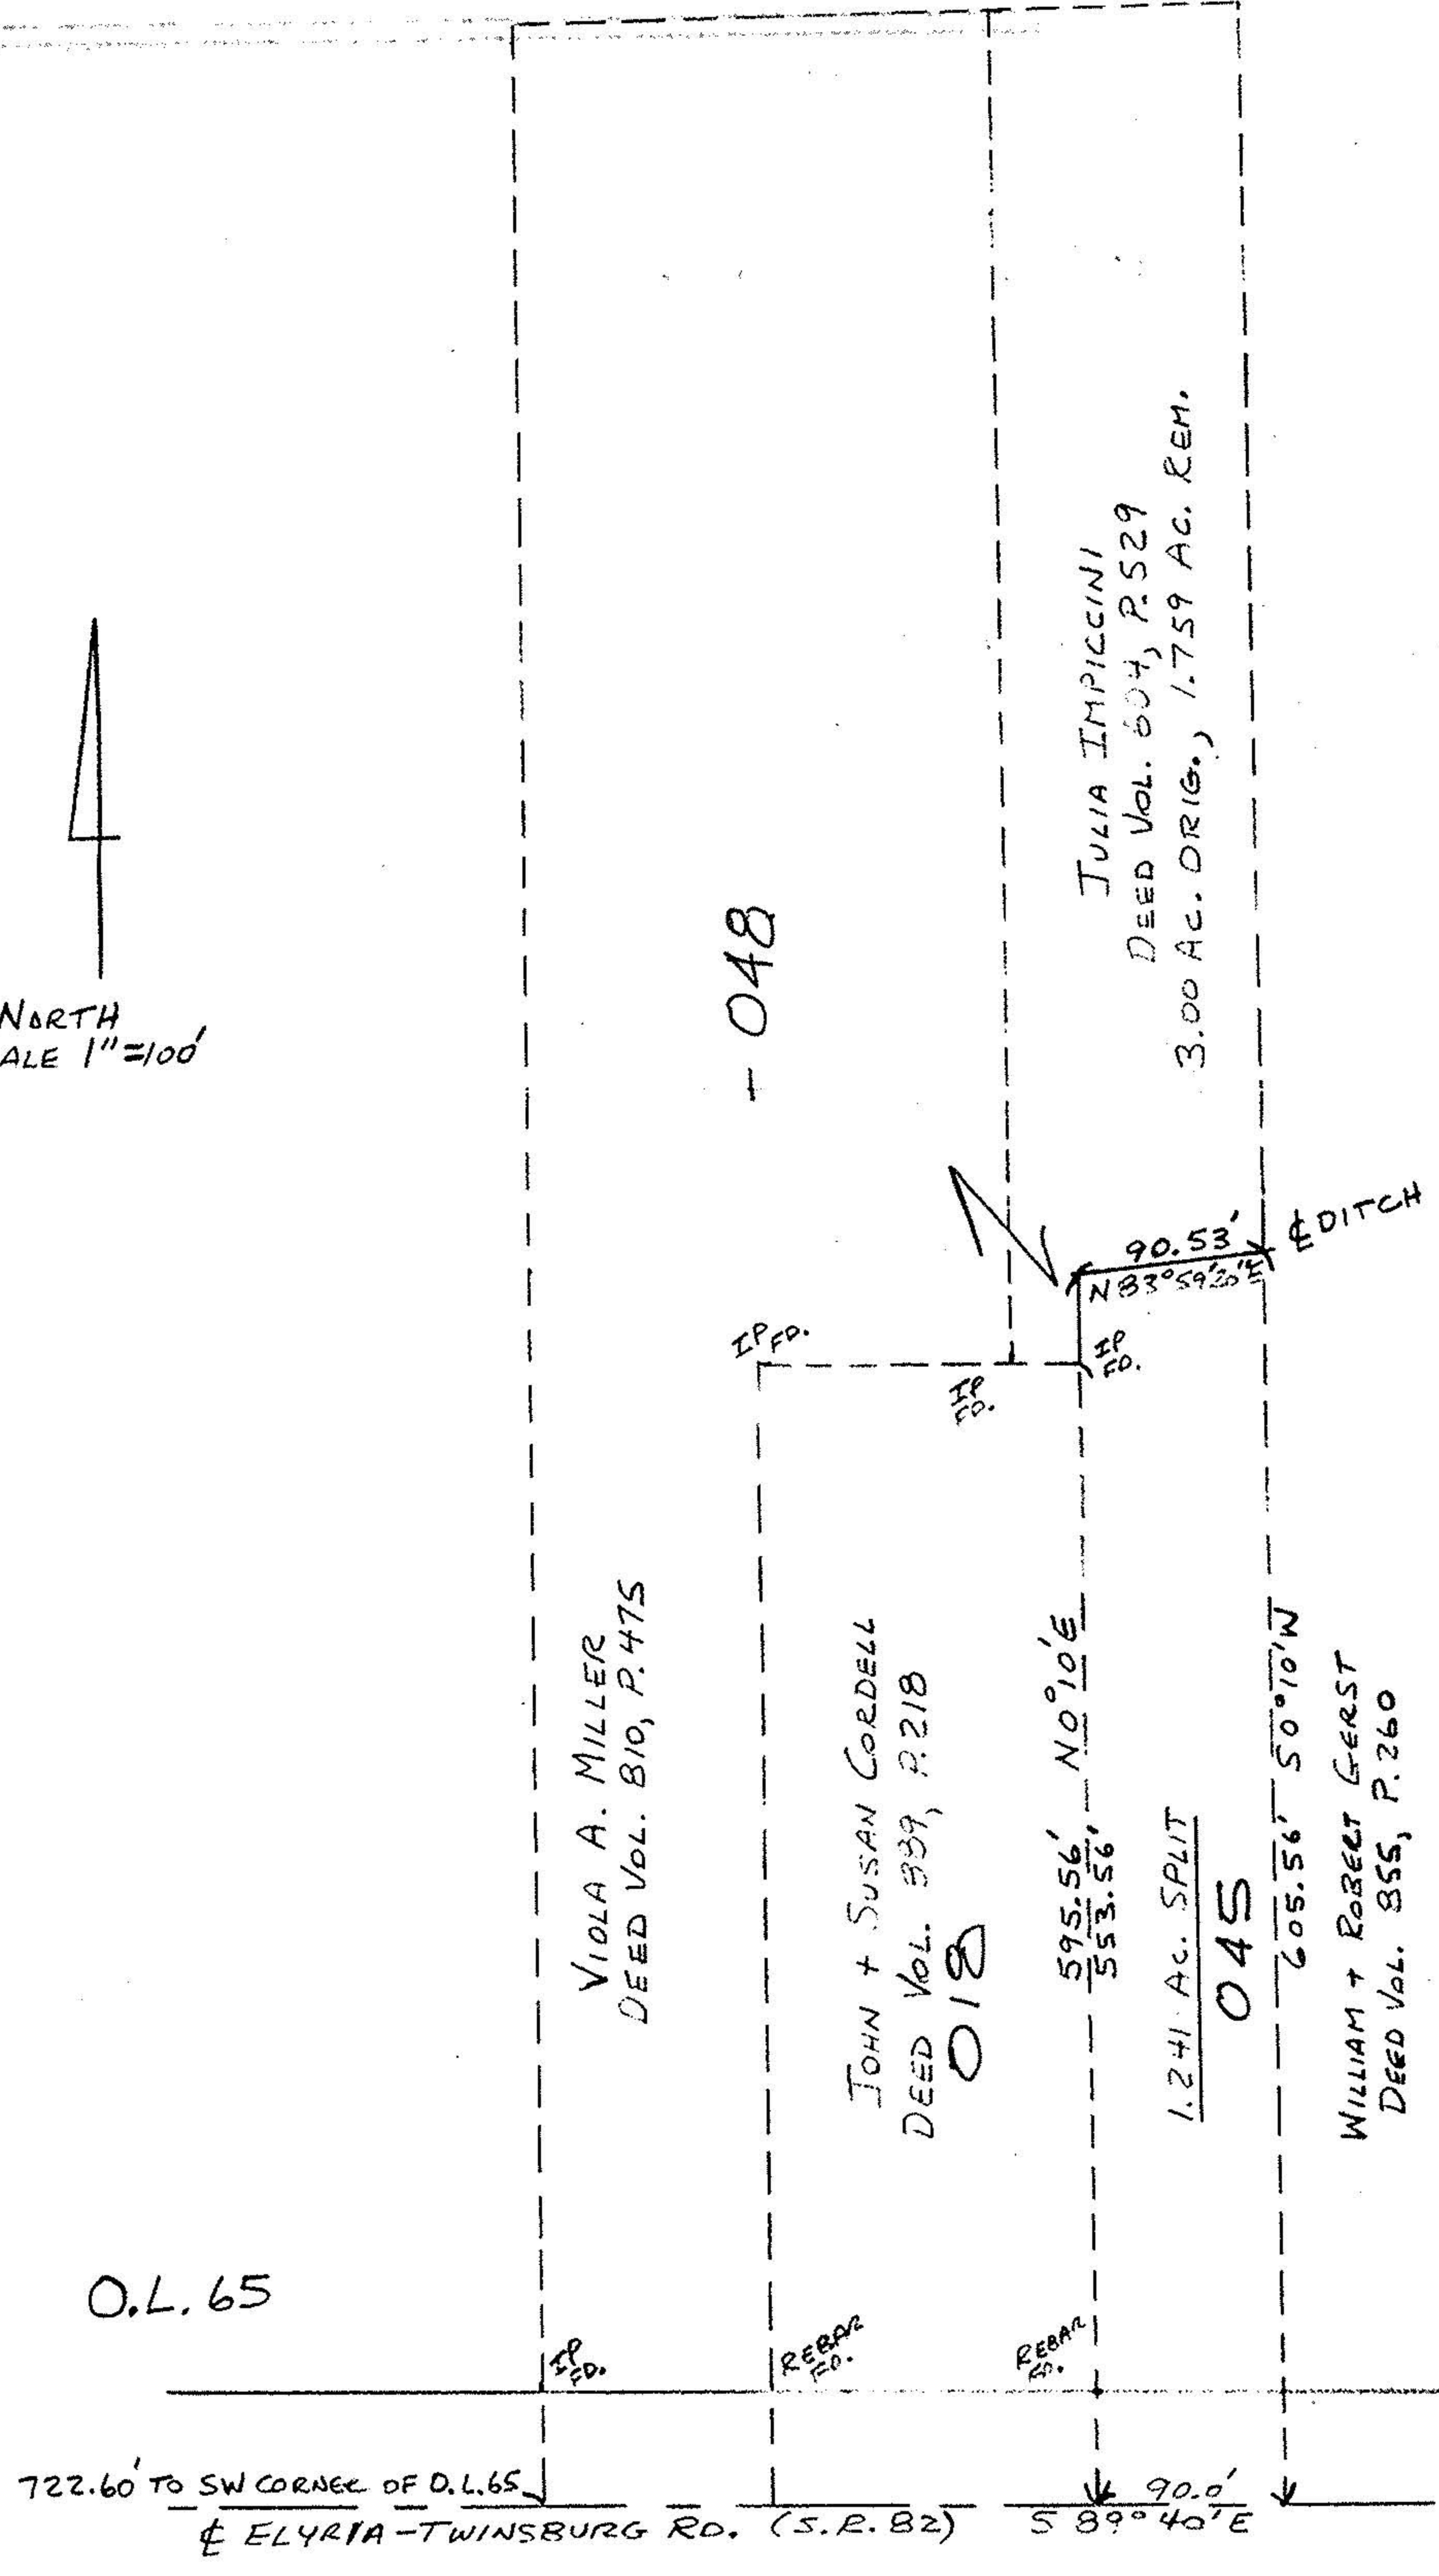

#17121

APPROVED
 LORAIN CO.
 MAP DEPT.
 DATE 11-20-86
 PAGE 12-00-065-
 BY T. McMain
 VOID AFTER

A