

12-00-061-000


#15386

12-00-061-B

# SURVEY FOR HOLK

SITUATED IN THE TOWNSHIP OF COLUMBIA, COUNTY OF LARAIN, AND STATE OF OHIO, BEING PART OF ORIGINAL COLUMBIA TOWNSHIP LOT NO. 61

*City Engineer*

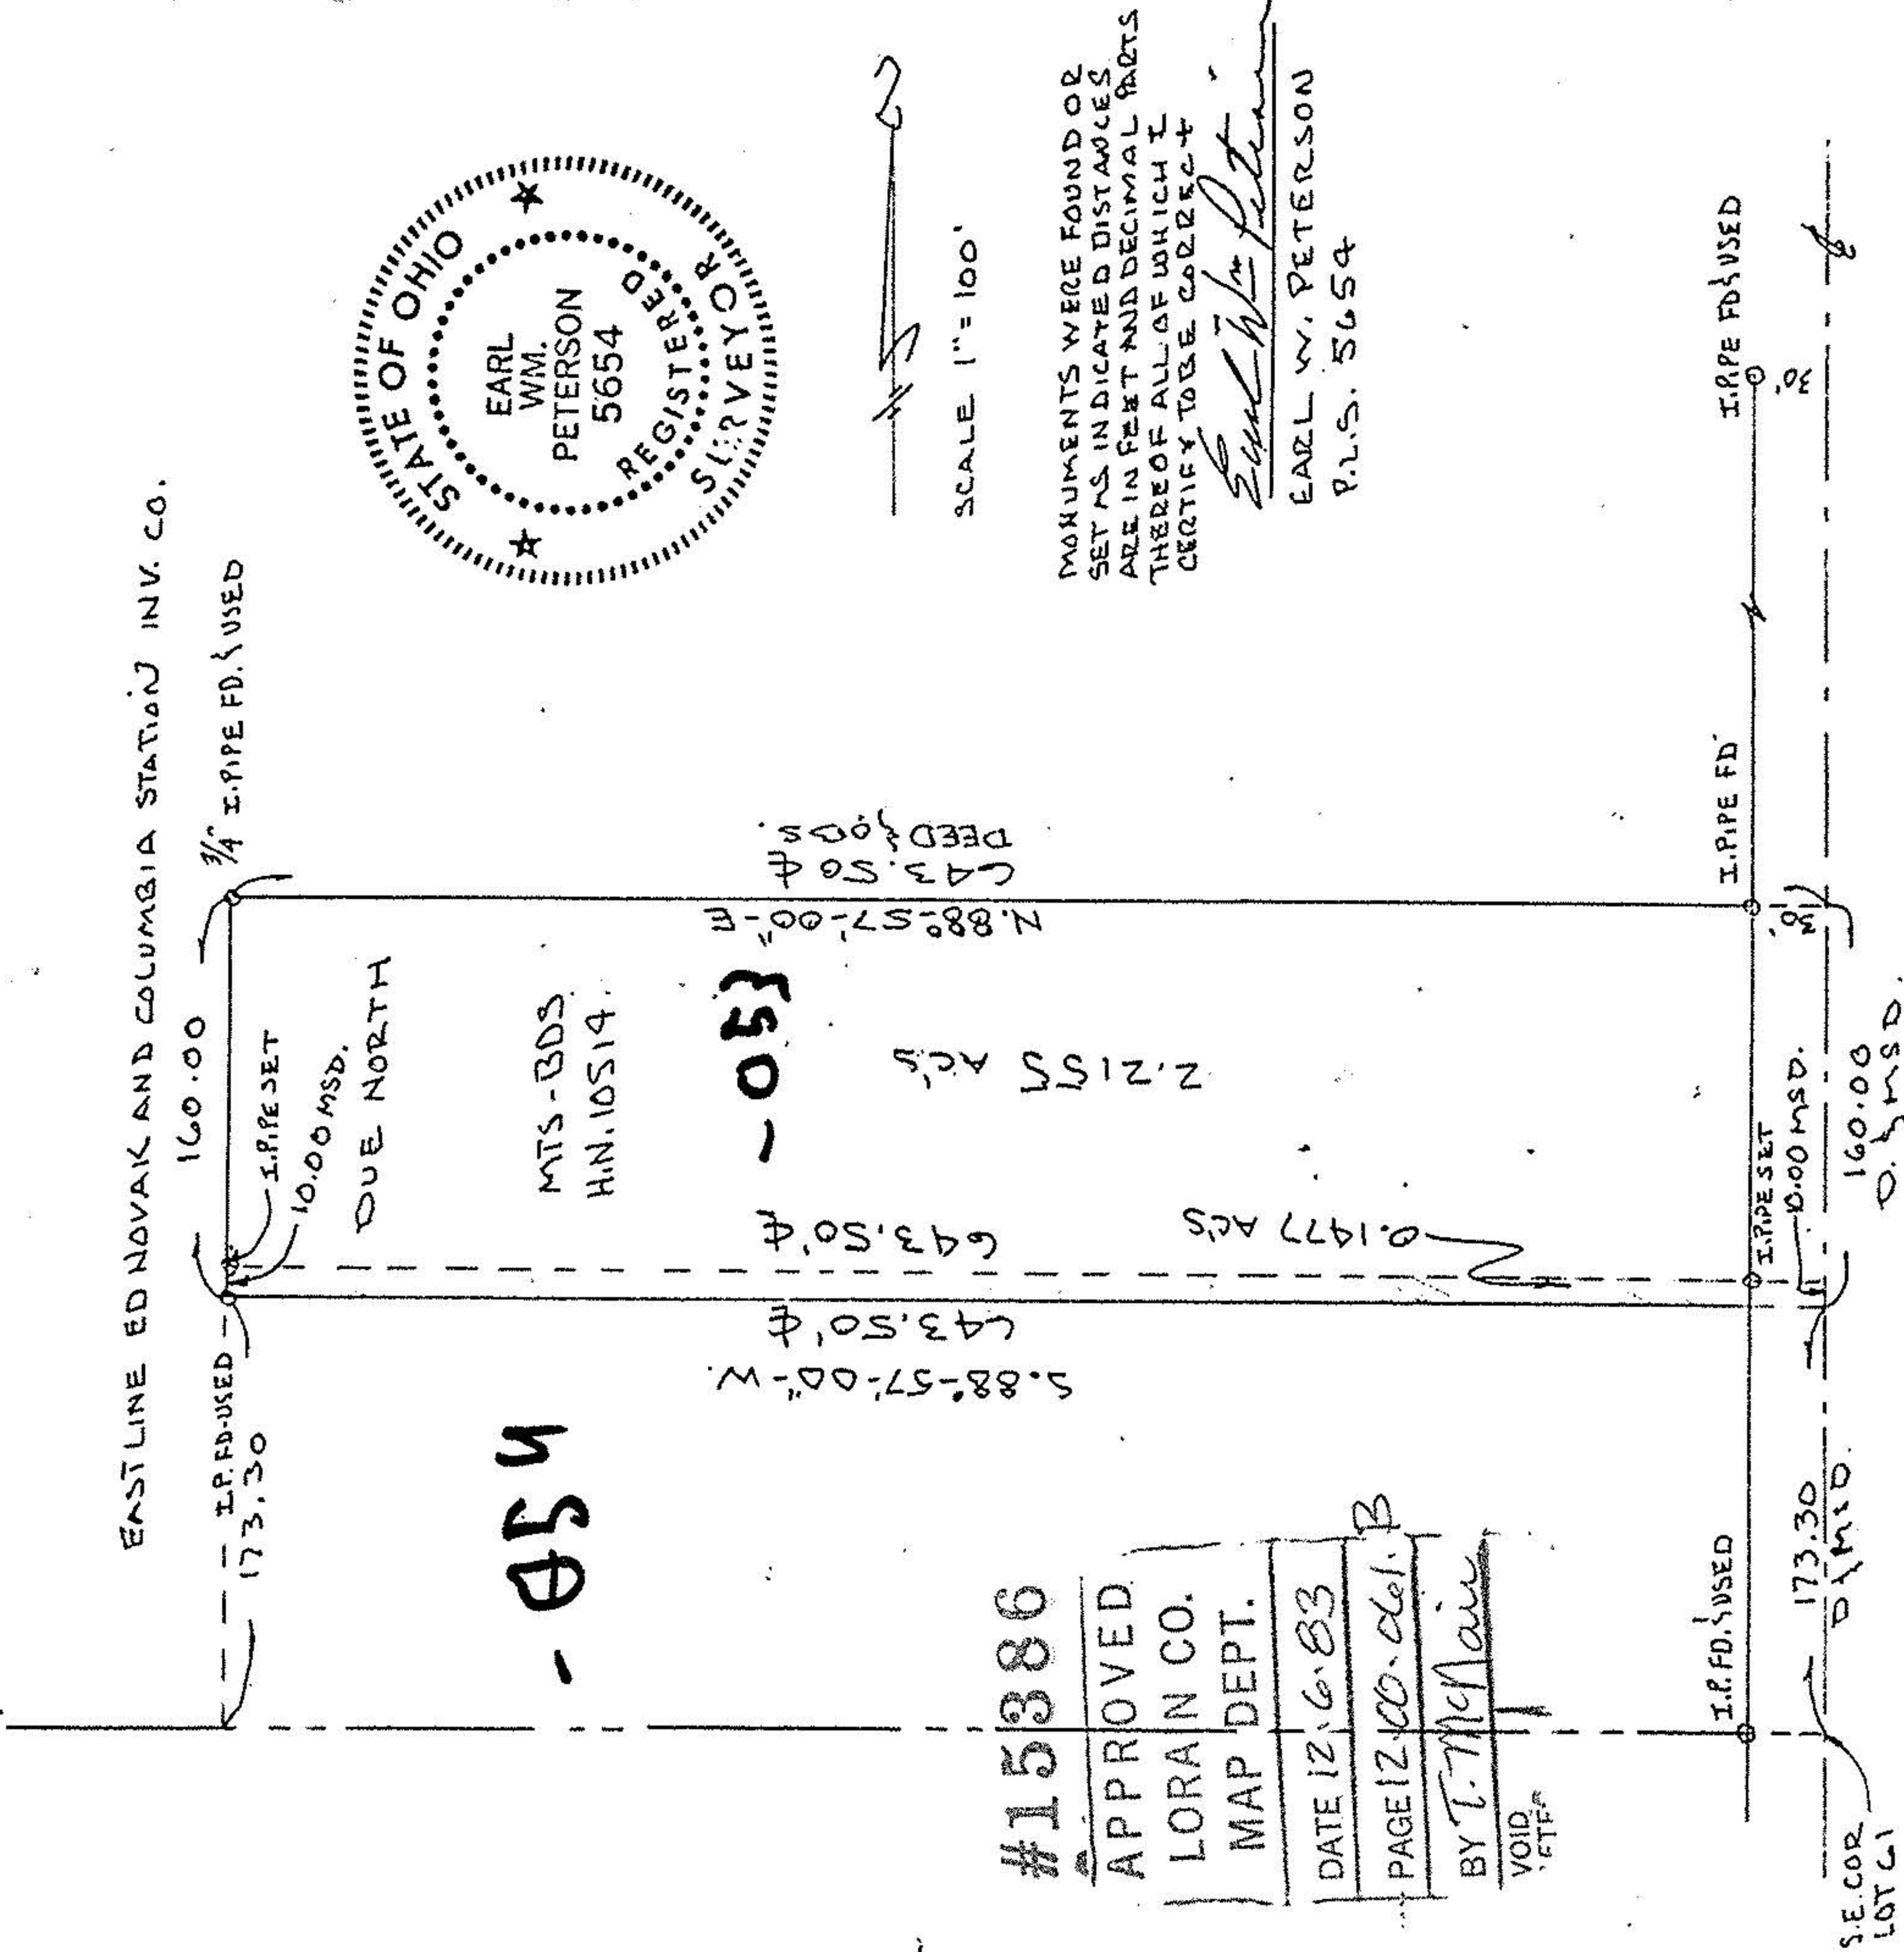

SCALE 1" = 100'

MONUMENTS WERE FOUND OR SET AS INDICATED DISTANCES ARE IN FEET AND DECIMAL PARTS THEREOF ALL OF WHICH I CERTIFY TO BE CORRECT

*Earl Wm Peterson*  
EARL W. PETERSON  
P.L.S. 5654

#15386

APPROVED

LORAIN CO. MAP DEPT.

DATE 12.6.83

PAGE 12 CO. 061. B

BY T. McNamee

VOID AFTER

S.E. COR. LOT 61

JAGUAY ROAD 60'