

1890.28 - 1890.28

840.32

corp.


320  
1049.96 to

SR301

80

80

89°52'

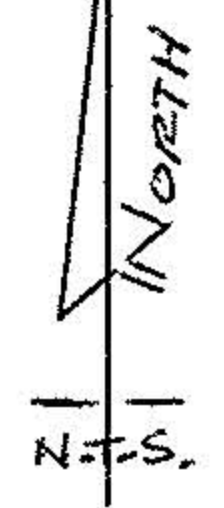

SHIFT DASHED LINE  
EAST PER SURVEY

PARCEL #2  
Pt. 084

PARCEL NO. 1

Pt. -084  
Pt. ~~10.47A.~~

Pt. -084

~~Pt. 10.47A.~~

(2) SPLIT  
NOT  
PROCESSED

SPLIT  
NOT  
PROCESSED

#00387-D

APPROVED  
LORAIN CO.  
MAP DEPT

DATE 7-27-00

PAGE 15-00-045-A

BY T-McNair  
PARCEL #1

SURVEY- RODGER G. SIMON, P.S.  
ENCLOSURE PARCEL #2  
PARCEL #1  
1: INF. 0.02:10,000  
PRIOR INST. REF. ① 0.02:10,000 ② 0.1% 10,000

#00387-D

APPROVED  
LORAIN CO.  
MAP DEPT.

DATE 7-27-00

PAGE 15-00-045-B

BY T-McNair  
00387-D

835.3

521.60

15-00-045-A

15-00-045-B

837.51

840 - 840

15-00-045-

-A

-B

800.58

521.60

452.03

431.75

29.65 50.48

29.85 50.28

0.33 A.

80

160

100

100

100

183.58

57.95

70.46

80

160

100

50

50

KI

4 - 067

50

50

MAP (2) OF (5)

101