


Leopold & Theresa Malik

N

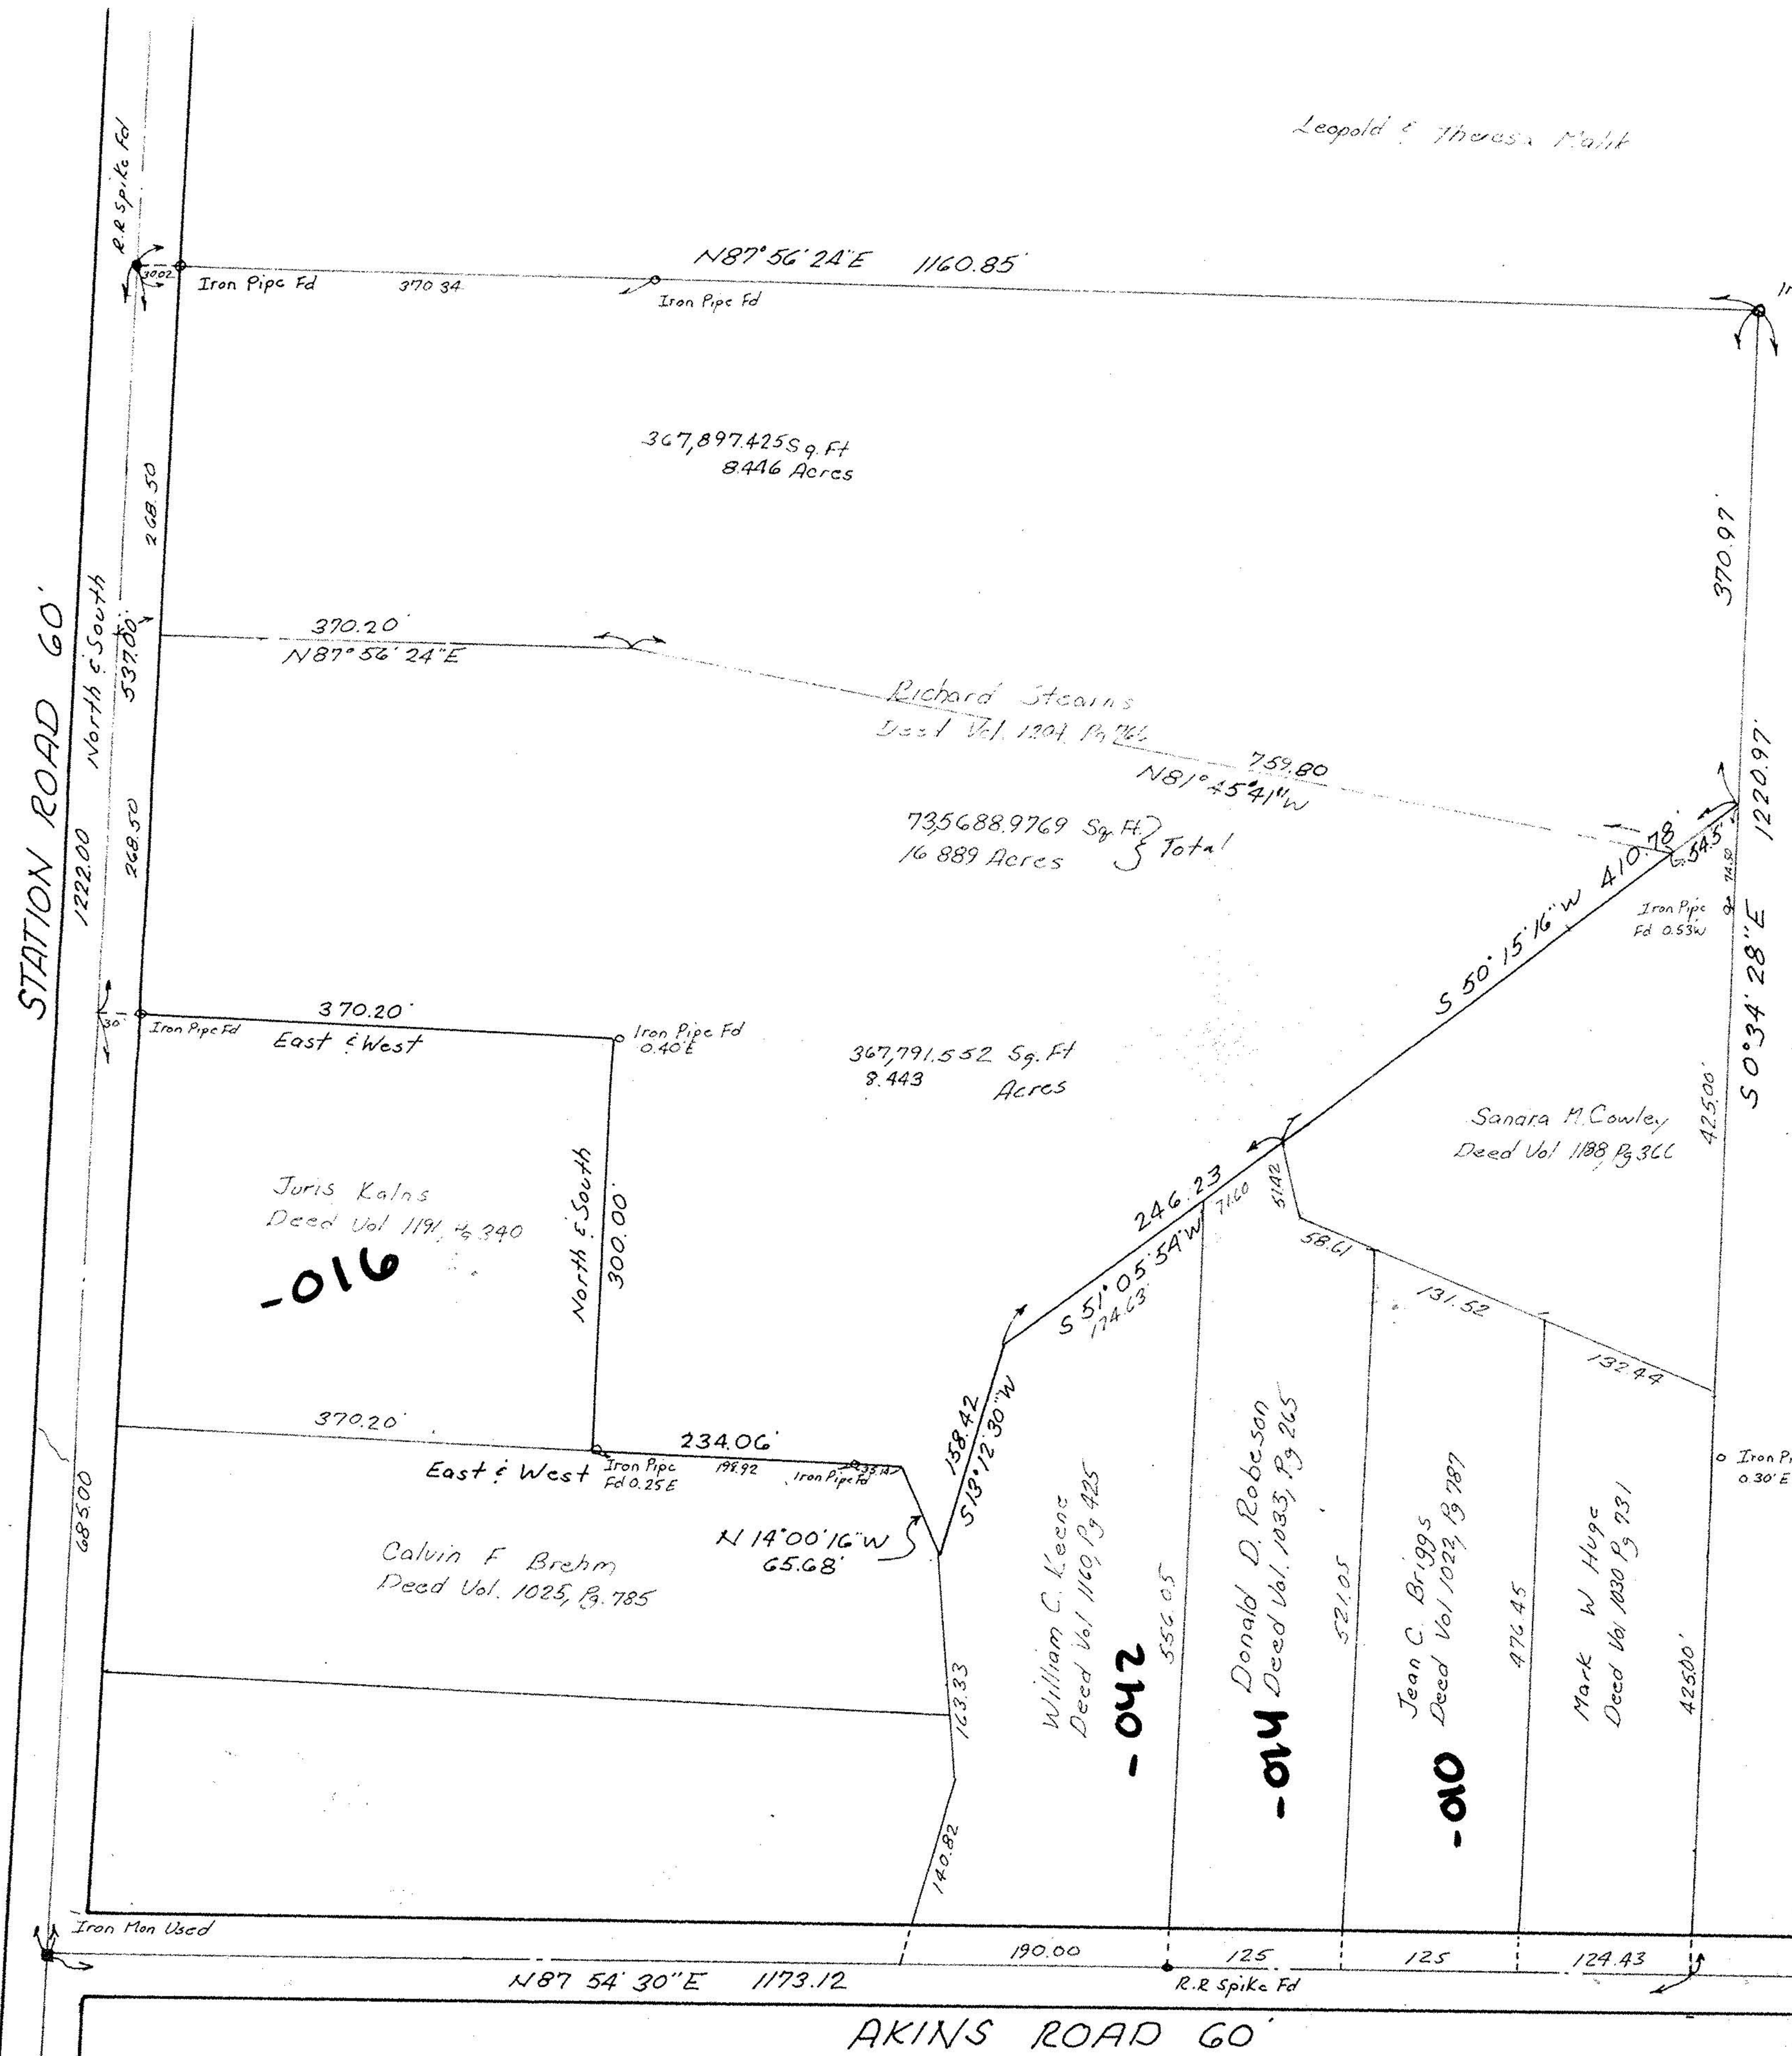

367,897.425 Sq. Ft
8.446 Acres

Richard Stearns
Deed Vol. 1204, Pg. 1476
735,688.9769 Sq. Ft } Total
16.889 Acres

367,791.552 Sq. Ft
8.443 Acres

Joris Kalns
Deed Vol. 1191, Pg. 340

-016

Calvin F. Brehm
Deed Vol. 1025, Pg. 785

William C. Keene
Deed Vol. 1169, Pg. 425

-014

Donald D. Roberson
Deed Vol. 1033, Pg. 265

Jean C. Briggs
Deed Vol. 1023, Pg. 787

-010

Mark W. Huger
Deed Vol. 1030, Pg. 731

Map of Survey
Made For
RICHARD STEARNIS
Original Columbia Township Lot 73
Lorain County, Ohio

Order N° 9426
F.B. Pg
Scale 1"=100'
August, 1987

JAMES B. ROOT & ASSOCIATES
Consulting Civil Engineers & Surveyors
By: *George Hoffmann*
Registered Surveyor N° 6752

Lot Split Added 11-24-87

12-00-073-000

#17884

APPROVED
LORAIN CO.
MAP DEPT.
DATE 4-1-88
PAGE 2-E
BY Carol-Francis
VOID AFTER X 17884