

26-1-36

18044


12-00-075-000

1200-075-A

Elyria Twinsburg Rd

SR 82

102

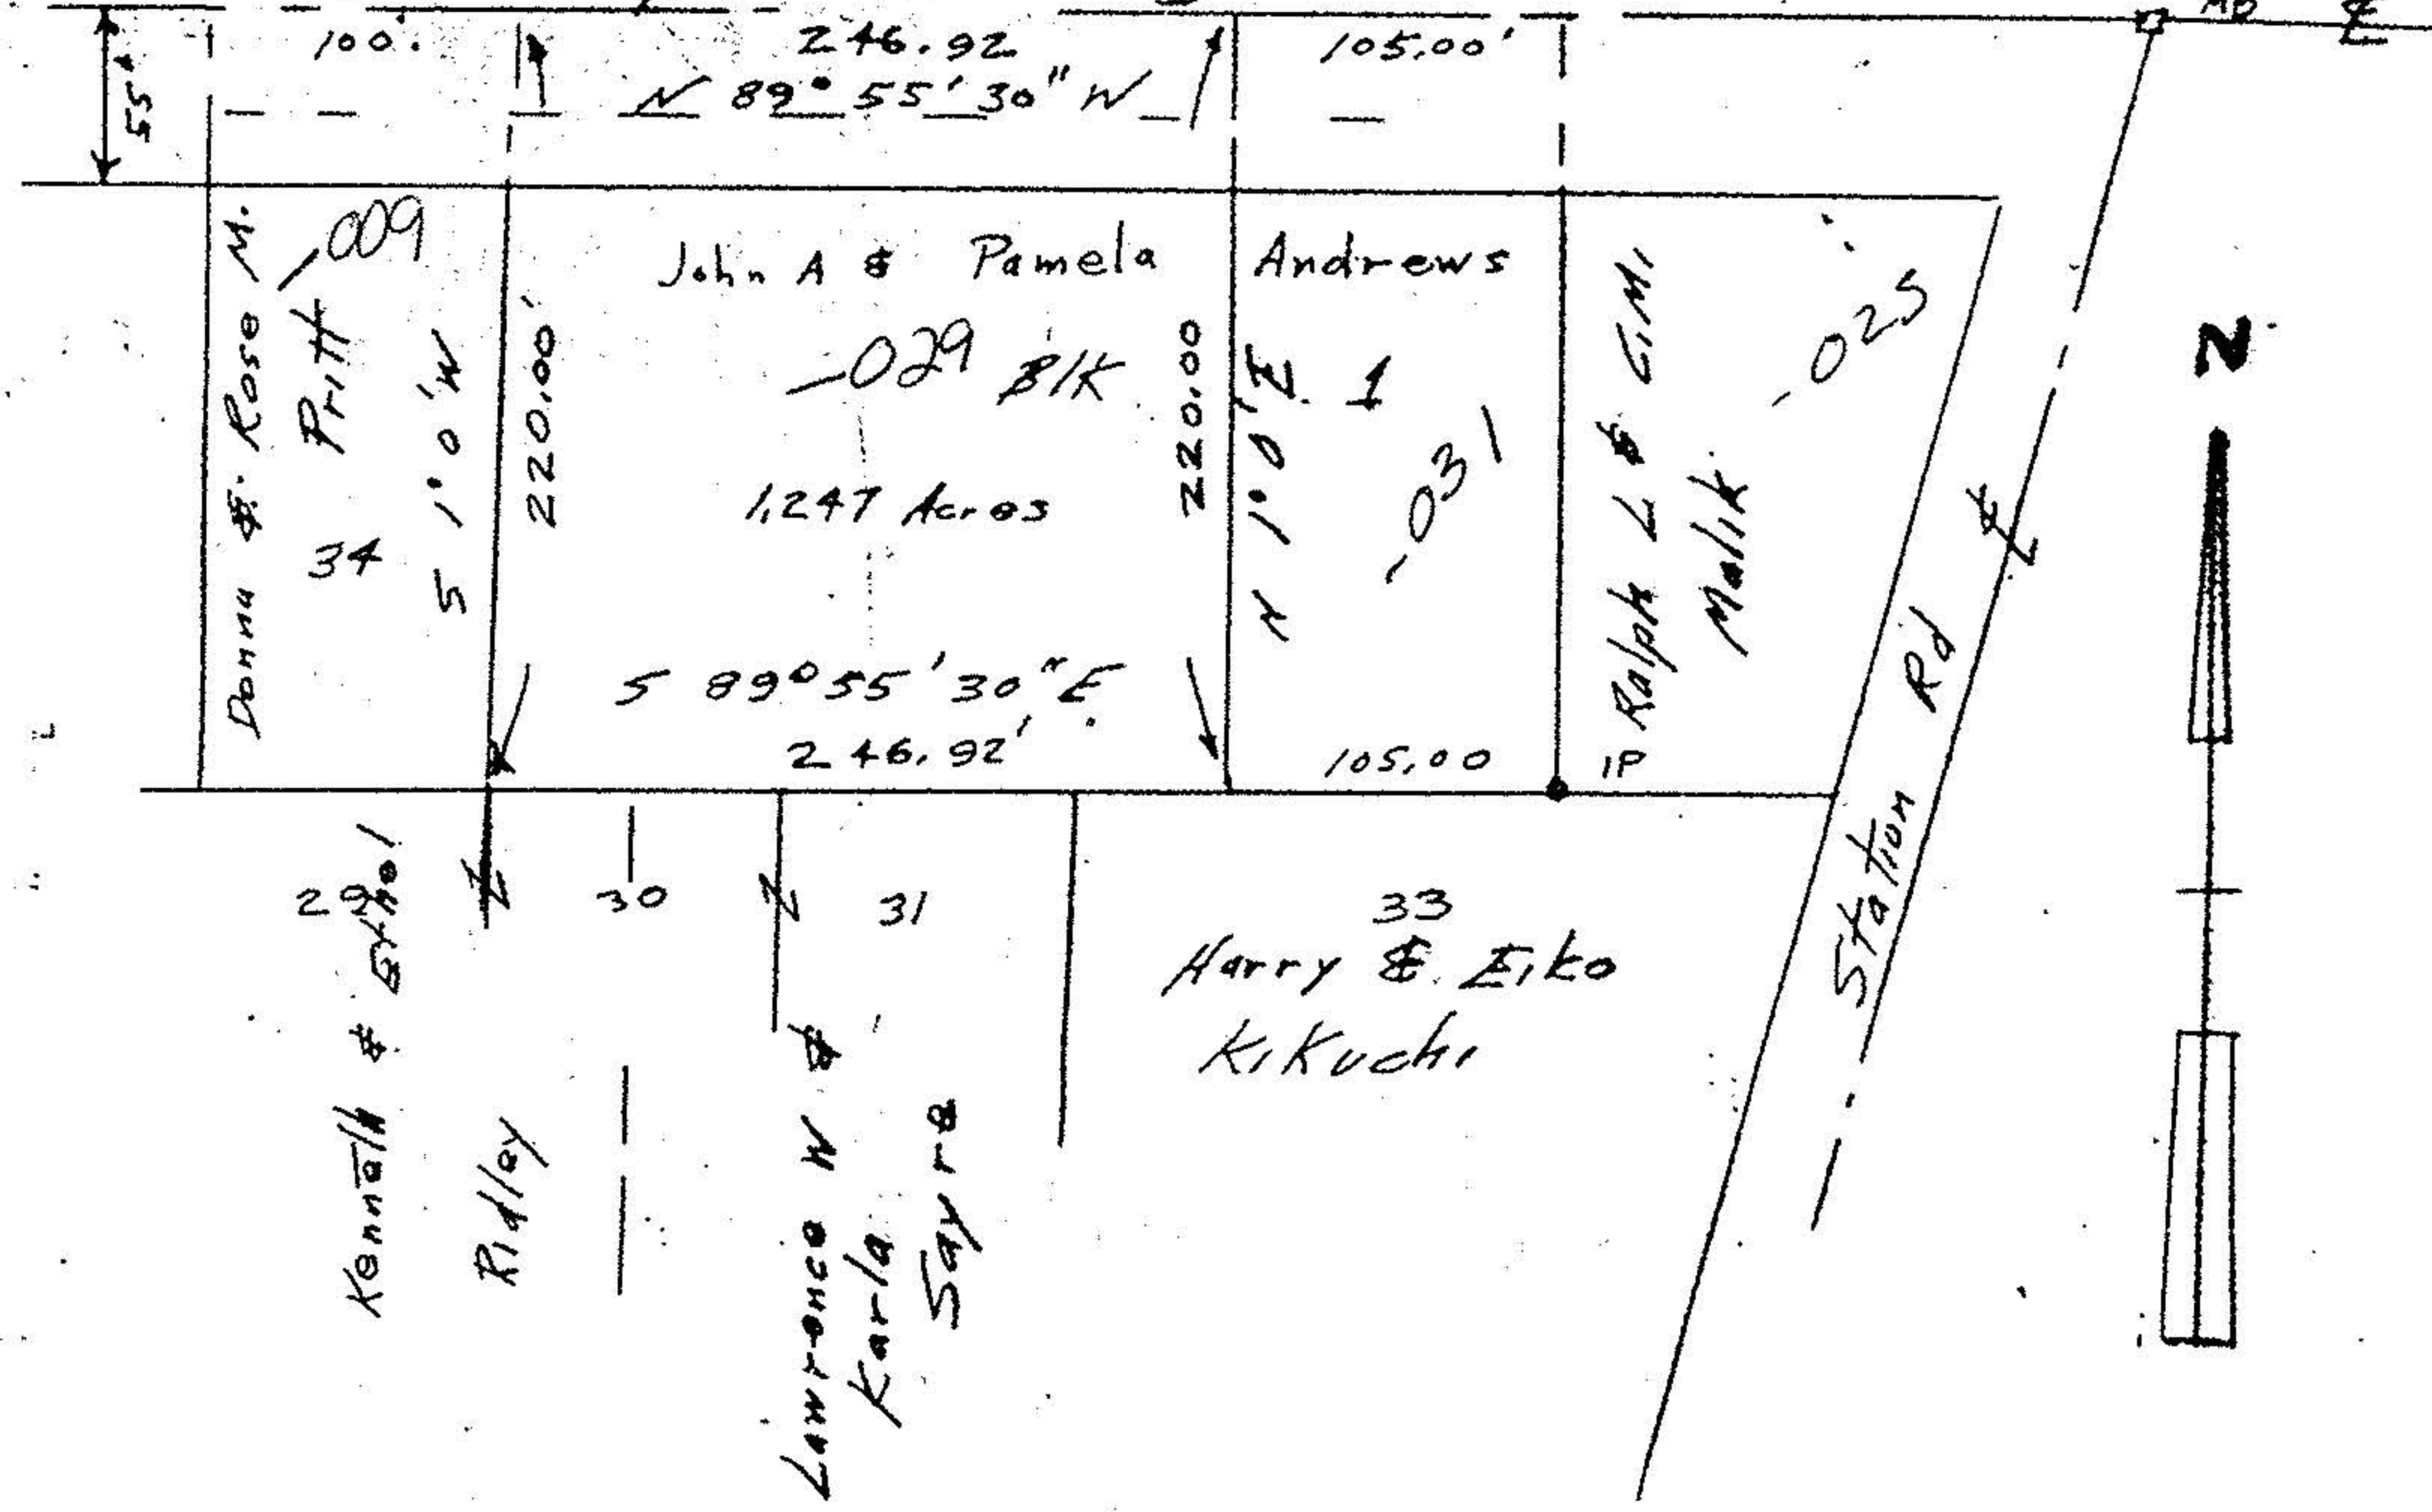

John Poznywal  
Reg Surveyor  
5292

#18044

APPROVED  
LORAIN CO.  
MAP DEPT.

PREPARED FOR JOHN ANDREWS  
Part of BLOCK 1  
Fred Probst Subdivision  
ORIGINAL LOT 75  
COLUMBIA TOWNSHIP  
LORAIN COUNTY, OHIO  
scale: 1" = 100'

DATE 7-26-88

PAGE 12-00-075-A

BY Paul Francis

VOID AFTER # 18044

May 31, 1988