


(A) Jeffrey A Hart
 OR 1293 Pg 725

 Survey for
 Paul Doppelheuer
 Original Lot 83
 Columbia Township
 Lorain County Ohio
 Scale 1" = 200' May 1, 1997

John Pozywak
 Reg Surveyor
 5292

- o iron pins fd
- o iron pins set
- monument boxes

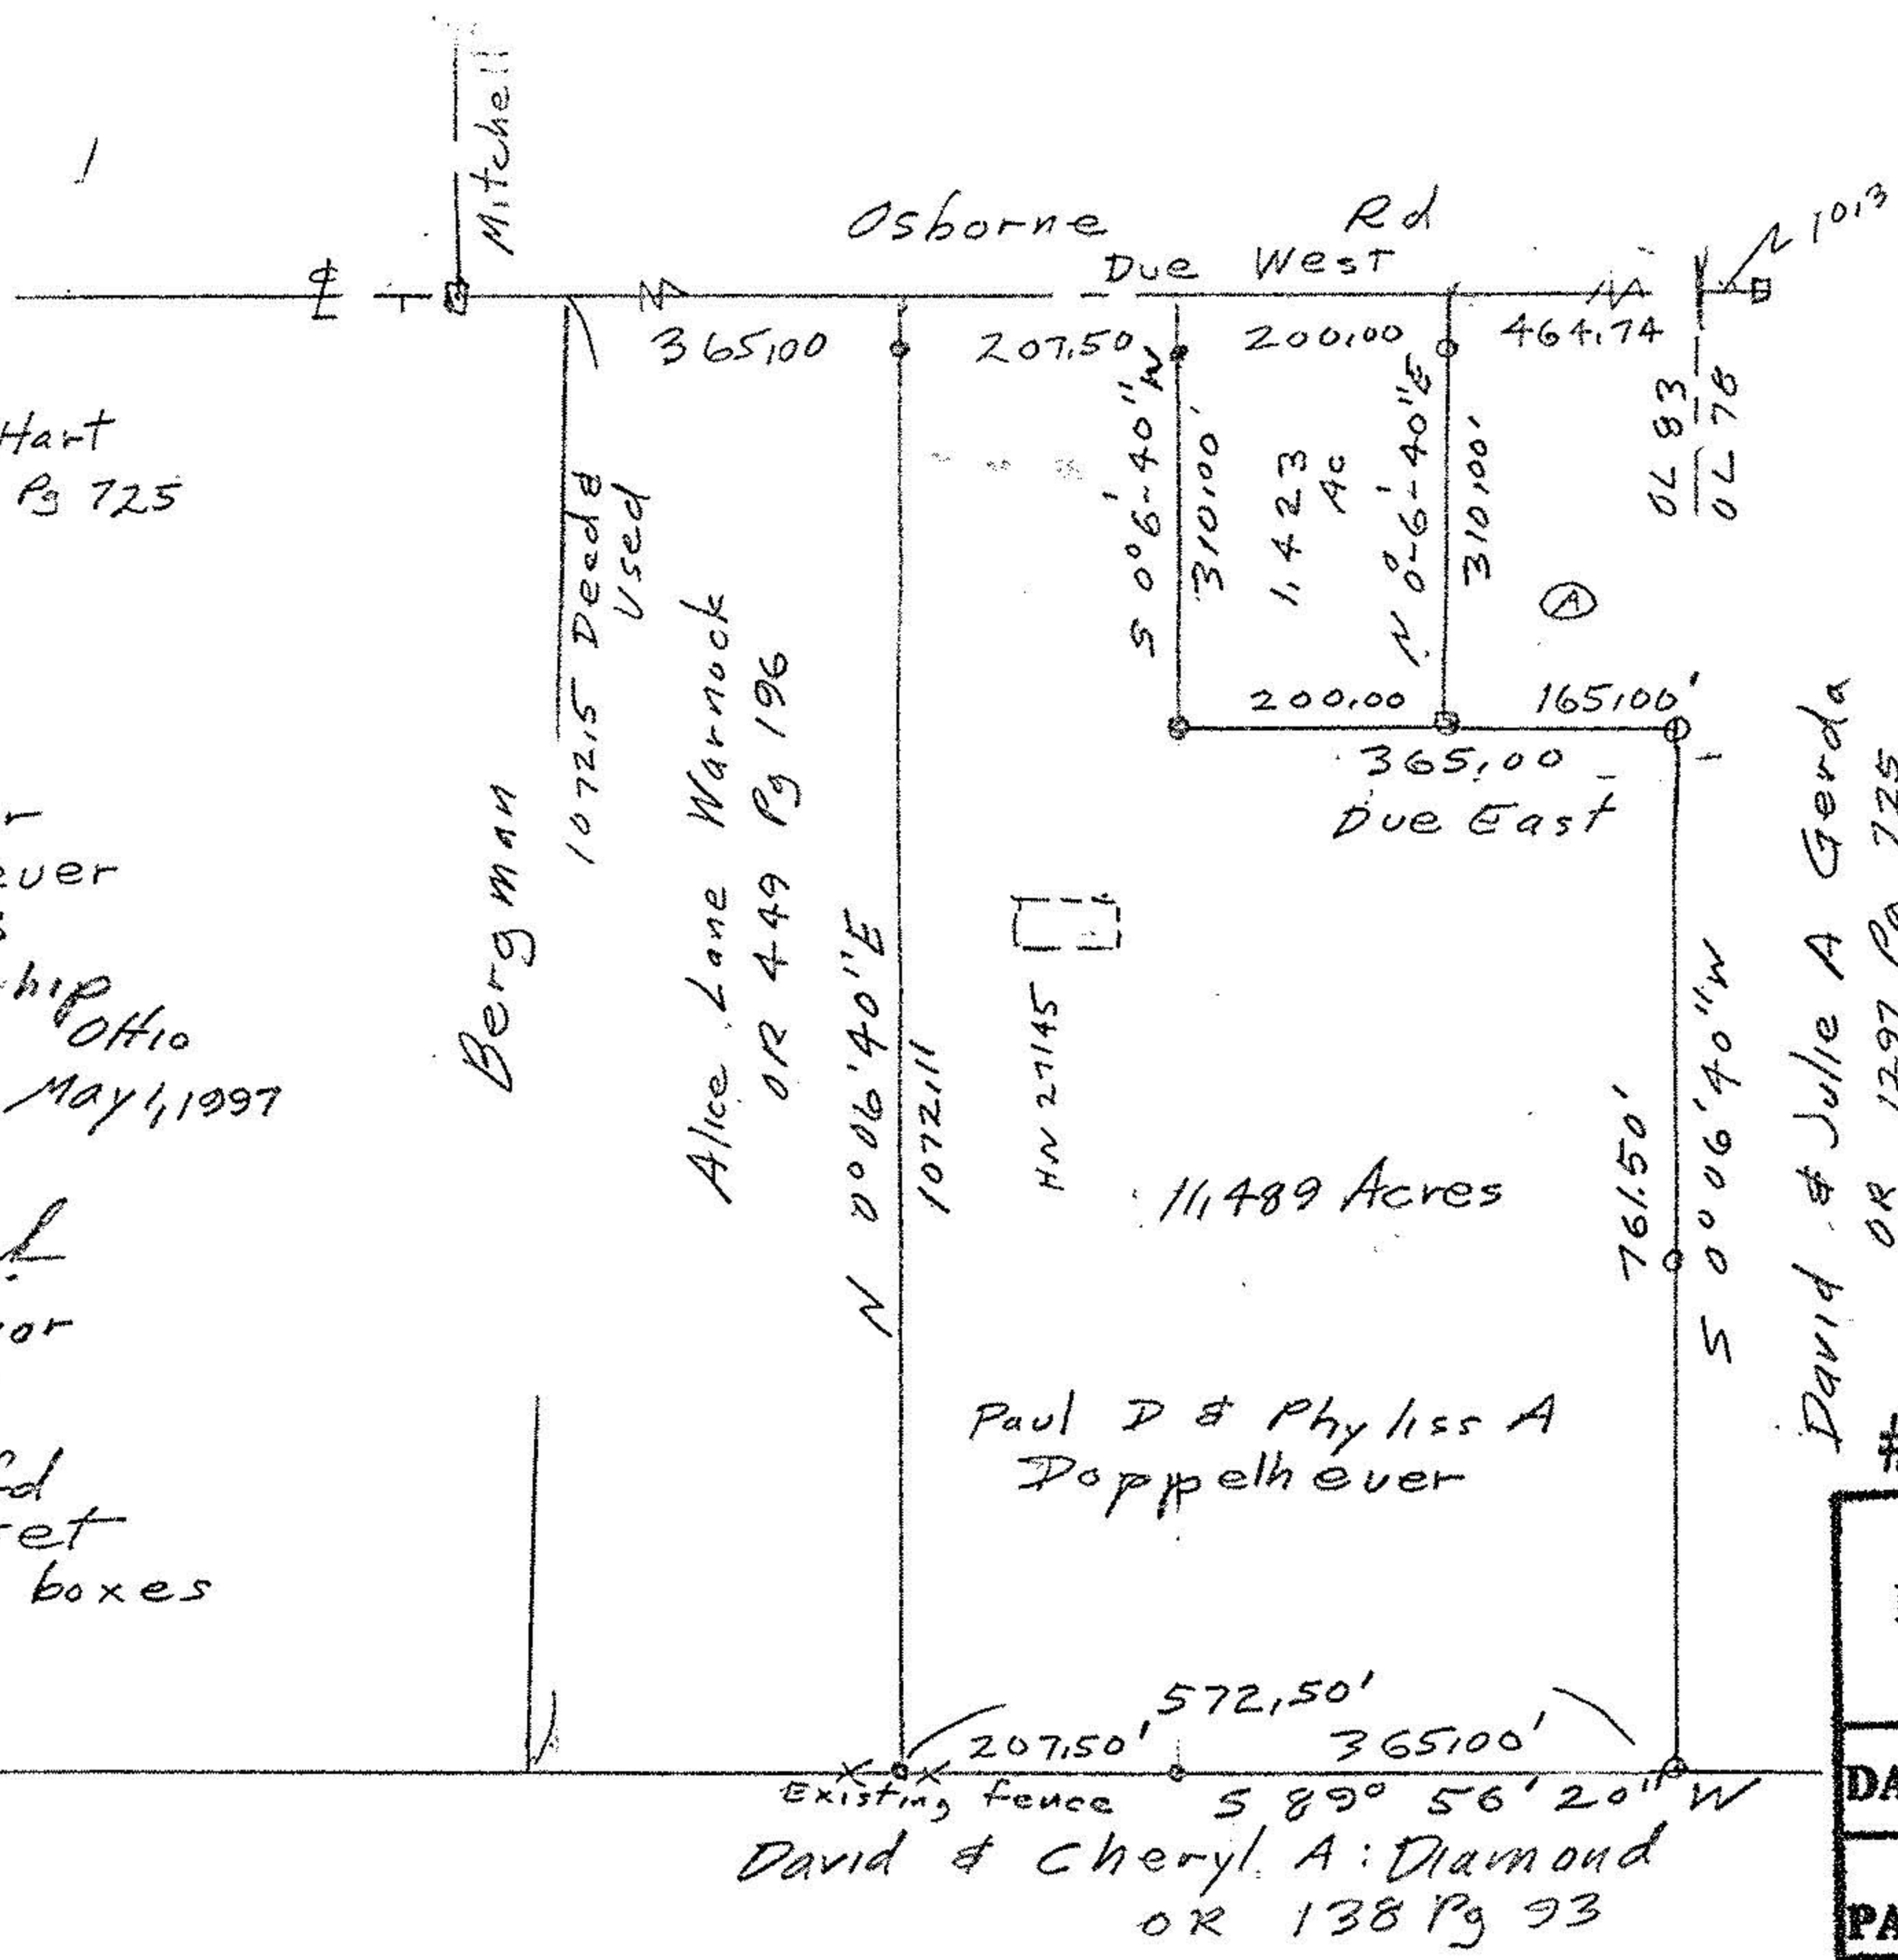

David & Julie A Gerda
 OR 1297 Pg 725



#22289

APPROVED LORAIN CO. MAP DEPT
DATE 10/2/97
PAGE 12-A
BY K.Colbert