


12-00-075-103-021 12-00-075-A

Joseph A. Brassai Feb. 10, 1950 D. Vol. 484 Pg. 242

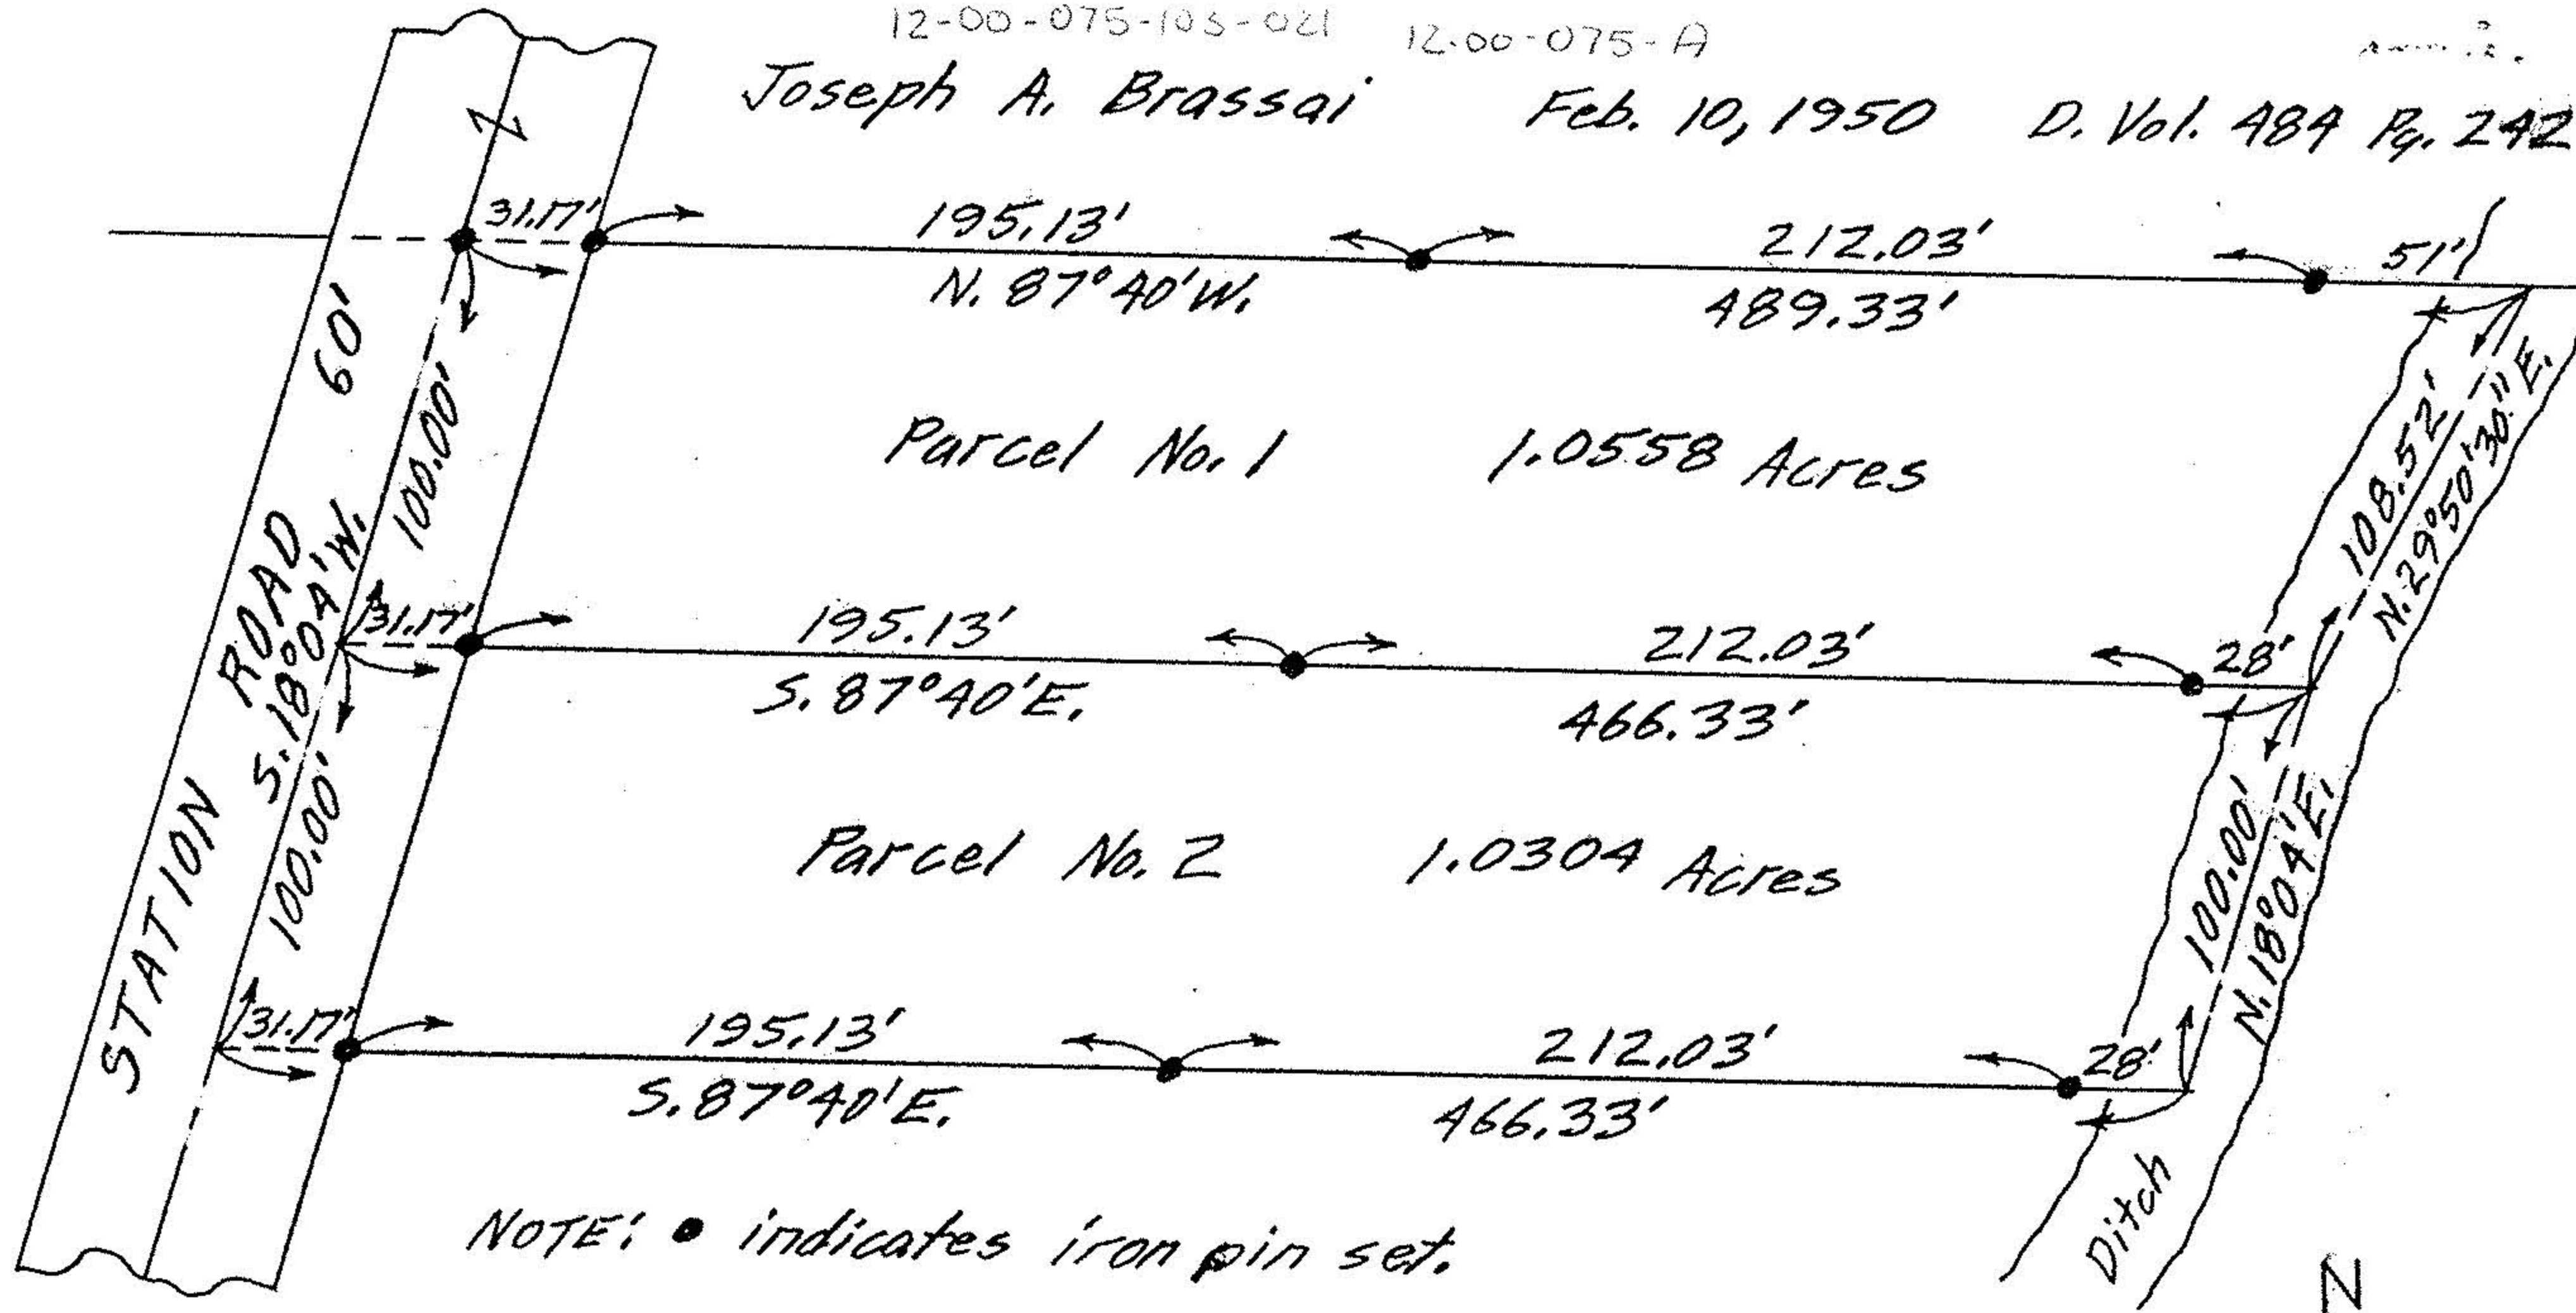

PLAT OF REVISED SURVEY FOR
 RICHARD J. & ADELAIDE RUTH HAENDIGES
 ORIGINAL LOT 75 COLUMBIA TOWNSHIP
 LORAIN COUNTY OHIO
 SCALE: 1"=60' MAY 31-1963
 Gary E. Penfound Reg. Surveyor No. 4457
 REVISION OF PARCELS NOS. 1 & 2 SURVEYED AUGUST 16-1960

