

ANTONIO A. CARLOS M.D.
D.V. 1120 P. 629

FOR THIS AREA SEE SURVEY OF AUG. '73

FRANK & JEAN R. MALACHOWSKI
D.V. 1017 P. 21

VINCENT A. & ANTONETTE P. MASTRO
11-17-77 V. 1192 P. 513


#12030

APPROVED LORAIN CO. MAP DEPT.	
DATE	9-7-78
PAGE	12-E
BY	T. McKain
VOID AFTER	



12-E

12-00-091-000
Lot 91

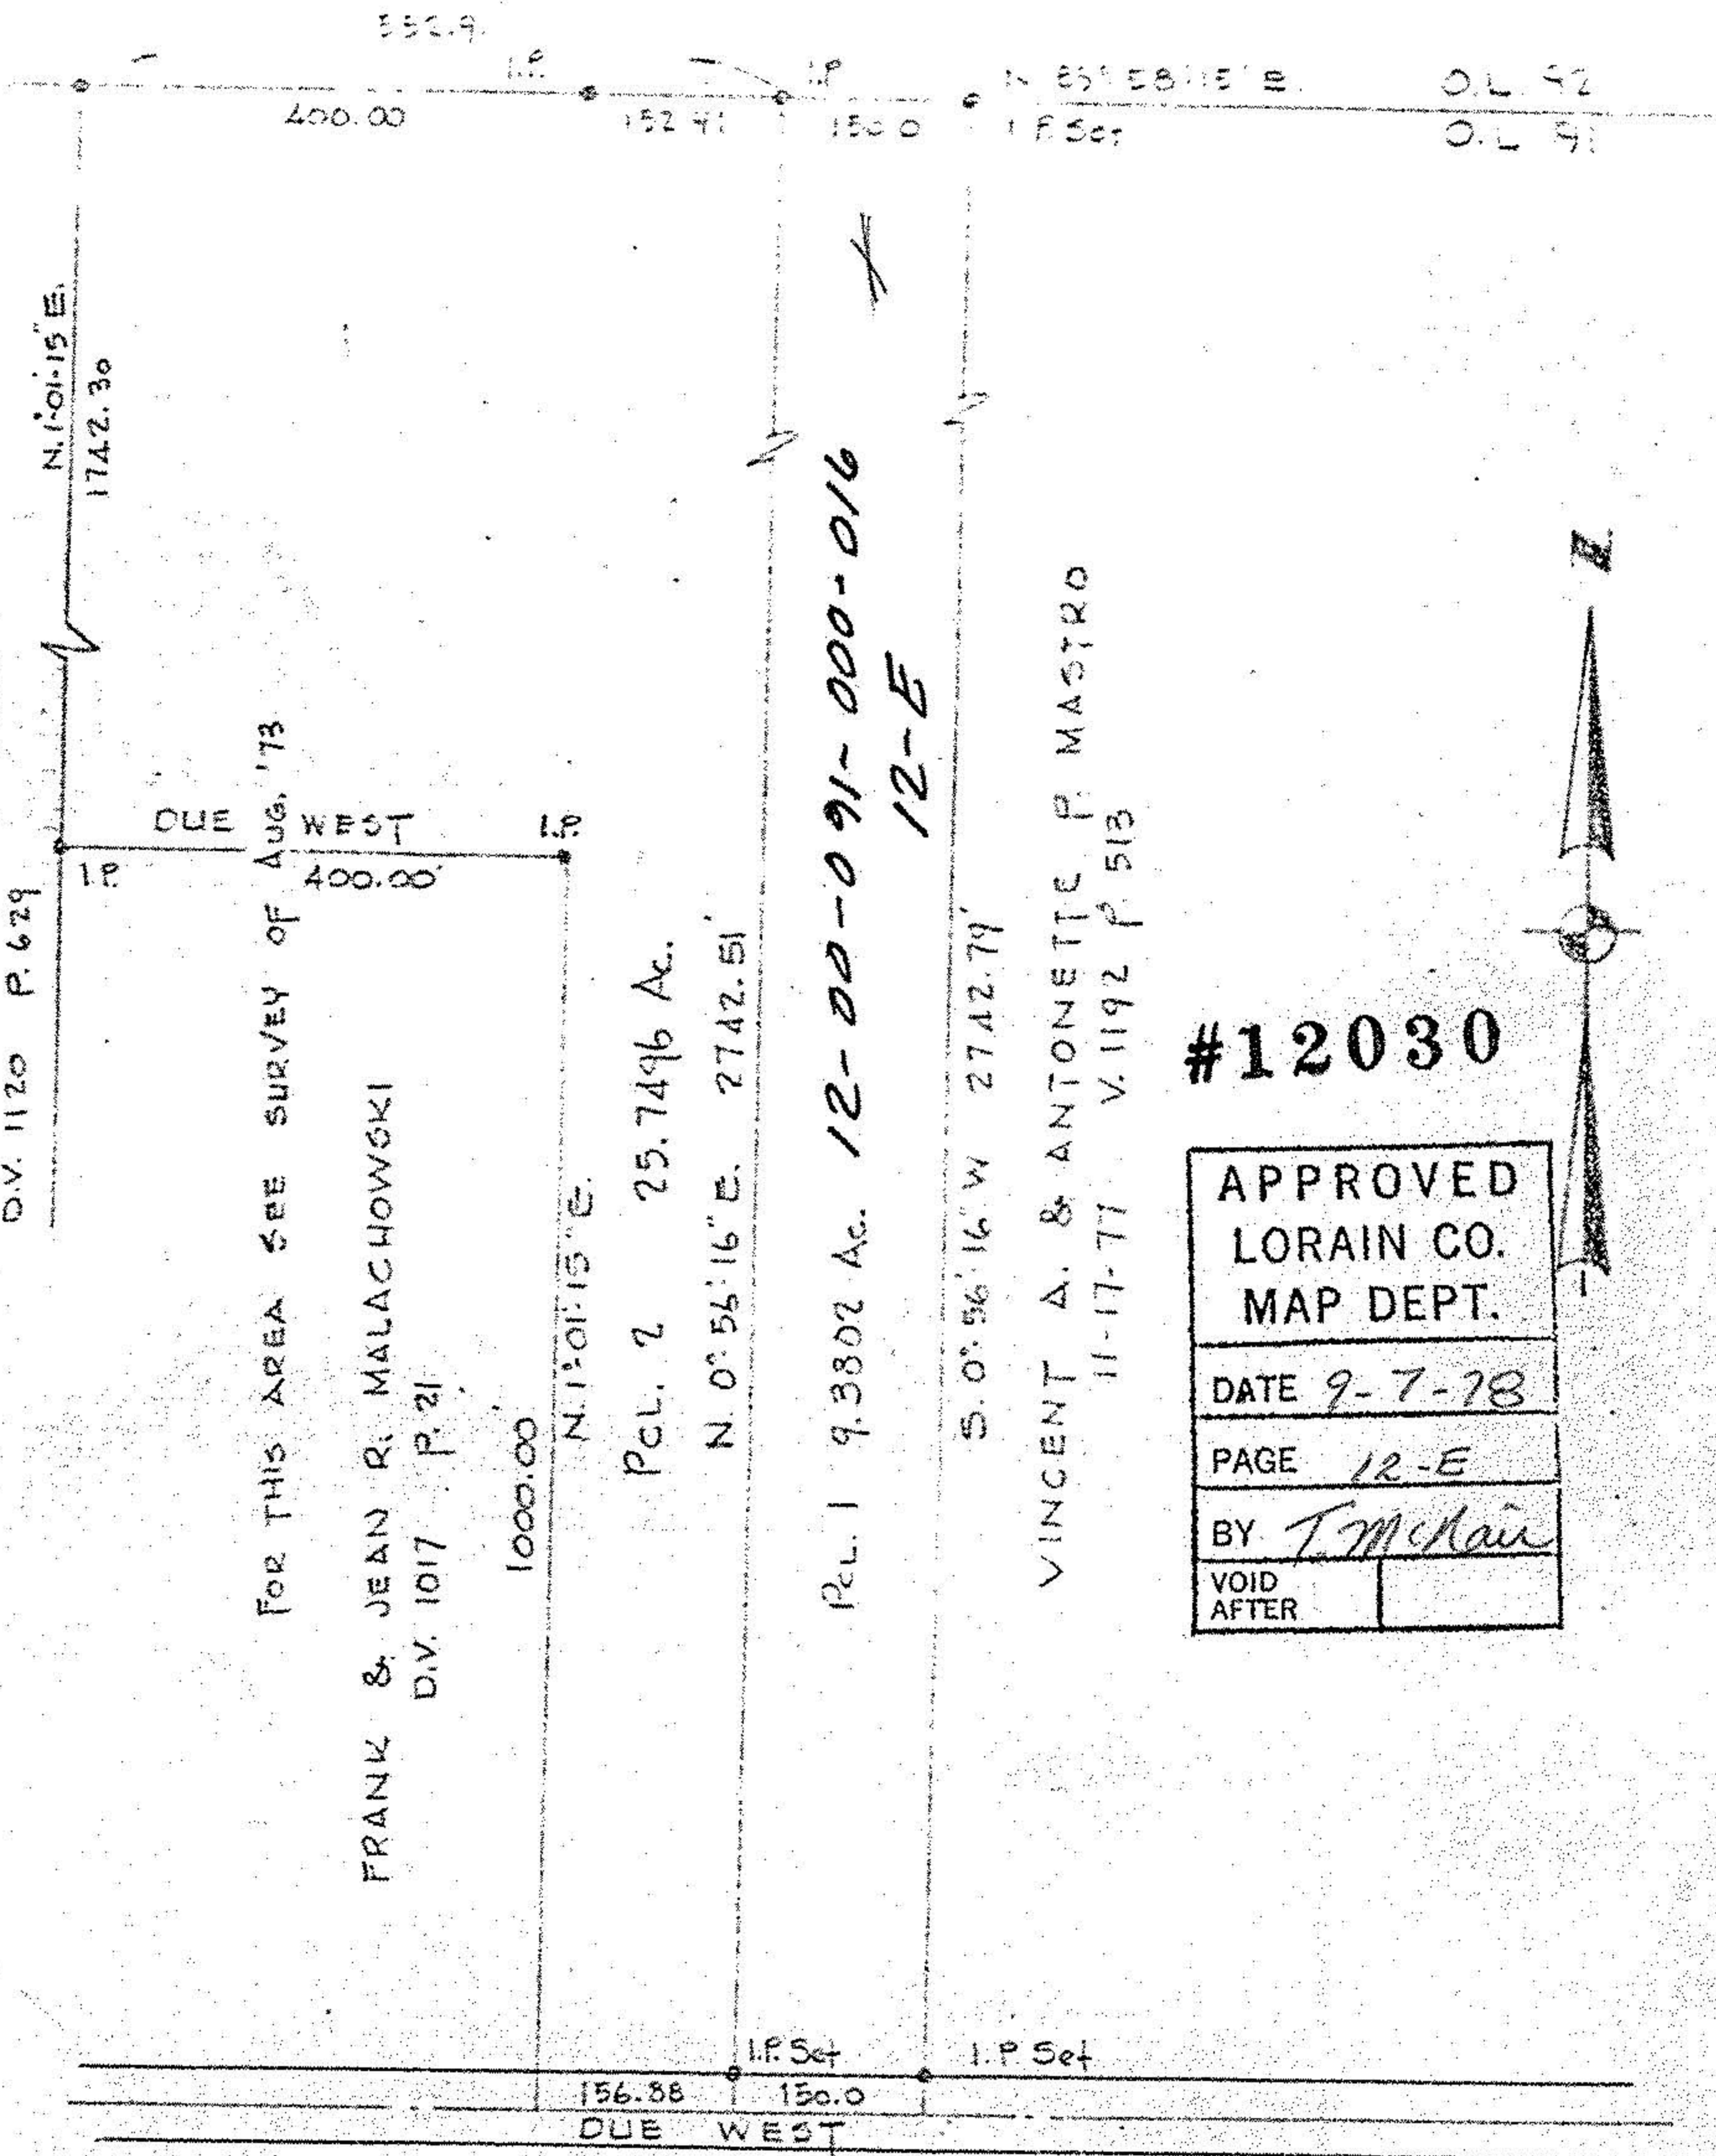

CROCKER RD. 60'

SURVEY FOR

WILLIAM C. FELTON

O.L. 91 COLUMBIA TWP LORAIN CO. OHIO

SCALE 1" = 200'

AUG. 1978

LAUNDON • SIMON • CARL & ASSOC. ENG. & SURVEYORS

Job No 75-777 FB 172-48