



#22707

APPROVED
LORAIN CO.
MAP DEPT.
DATE 12-2-98
PAGE 12-E
BY T. Spick
22707

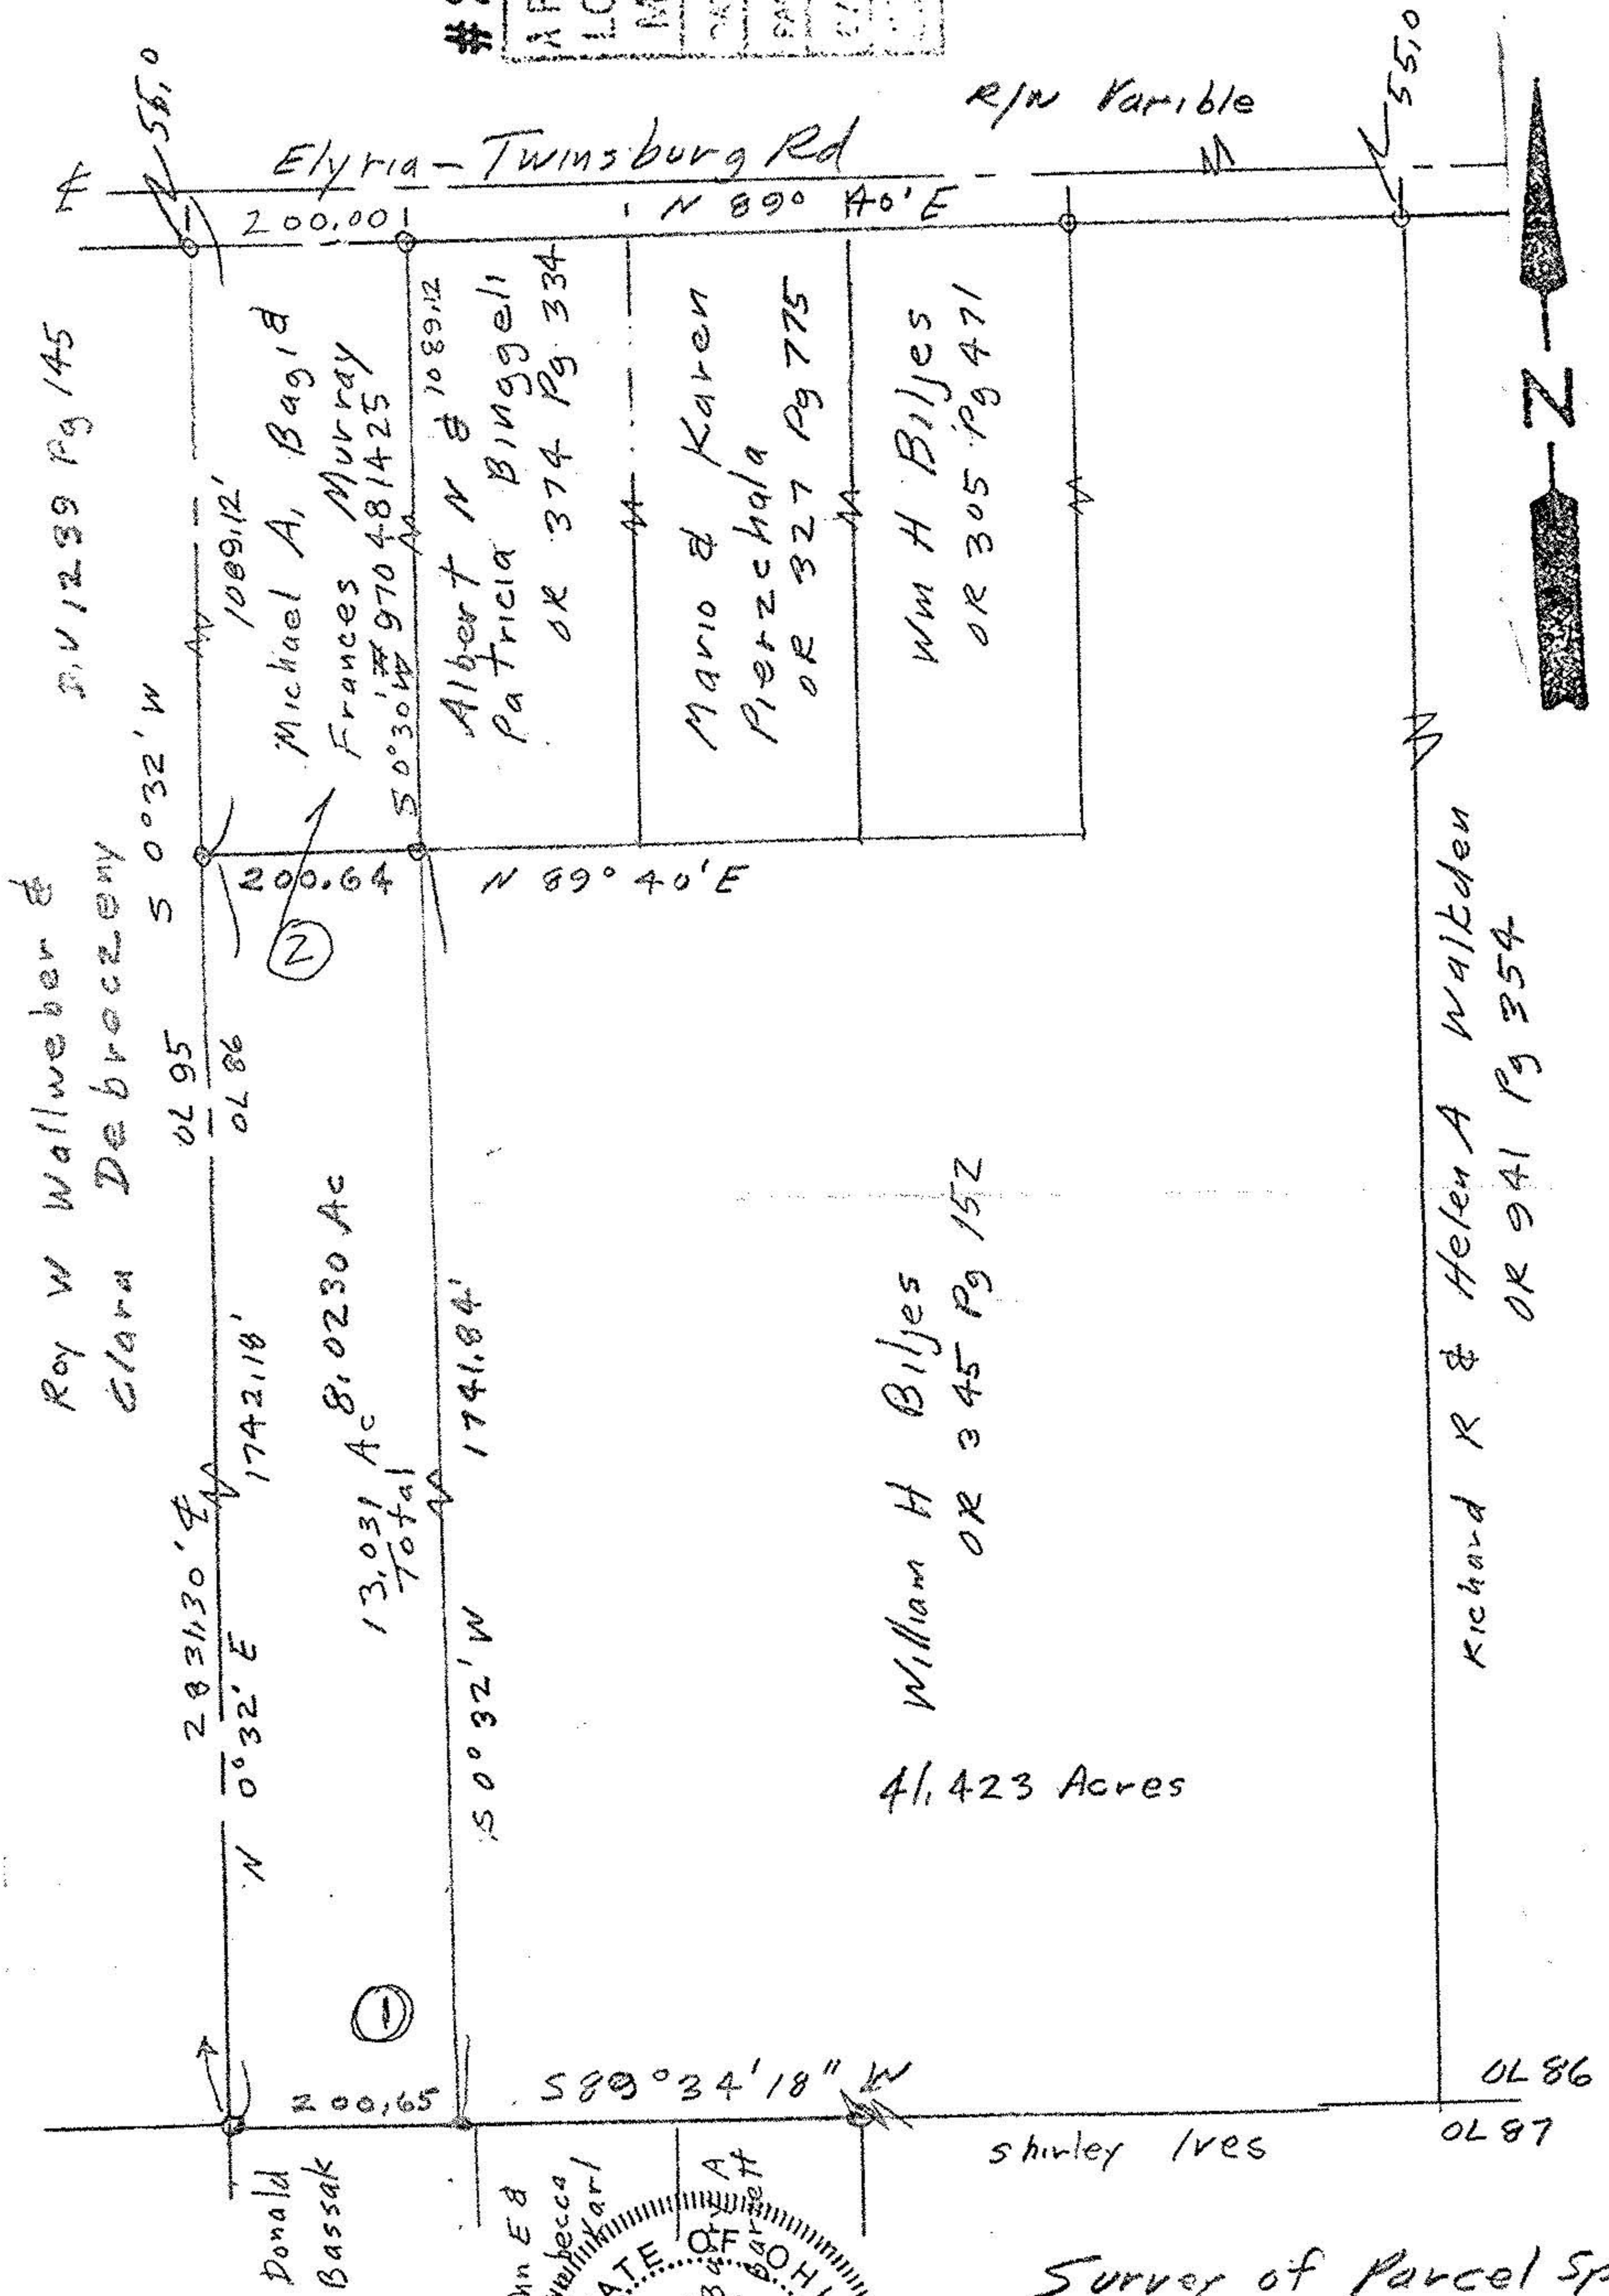

o iron pins fd  
 • iron pins set  
 John Pozywak

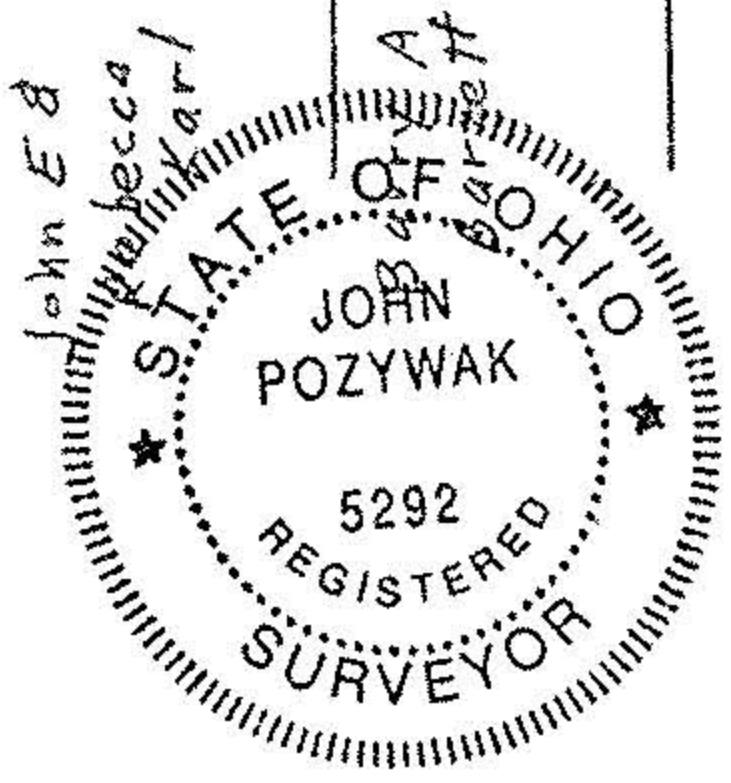

Survey of Parcel Split  
 Original Lot 86  
 Columbia Township  
 Lorain County Ohio  
 Scale 1"=200' Aug 16, 1998

