

• Iron pipes set  
Ref D.Vol 945 Pg 263

John Pozzywak  
Reg Surveyor  
5292

Survey for  
Thomas Johnson  
Part of Original 5  
Tract 9 Camden Township  
Lorain County Ohio  
Scale 1" = 200' July 15, 1990

#19112  
APPROVED  
LORAIN CO.  
MAP DEPT.  
DATE 9-5-90  
PAGE 13-G  
BY Tom Mann  
VOID AFTER 19112



#19112


13-G

13-09-005-000

13-09-005-000

#19374

13-G

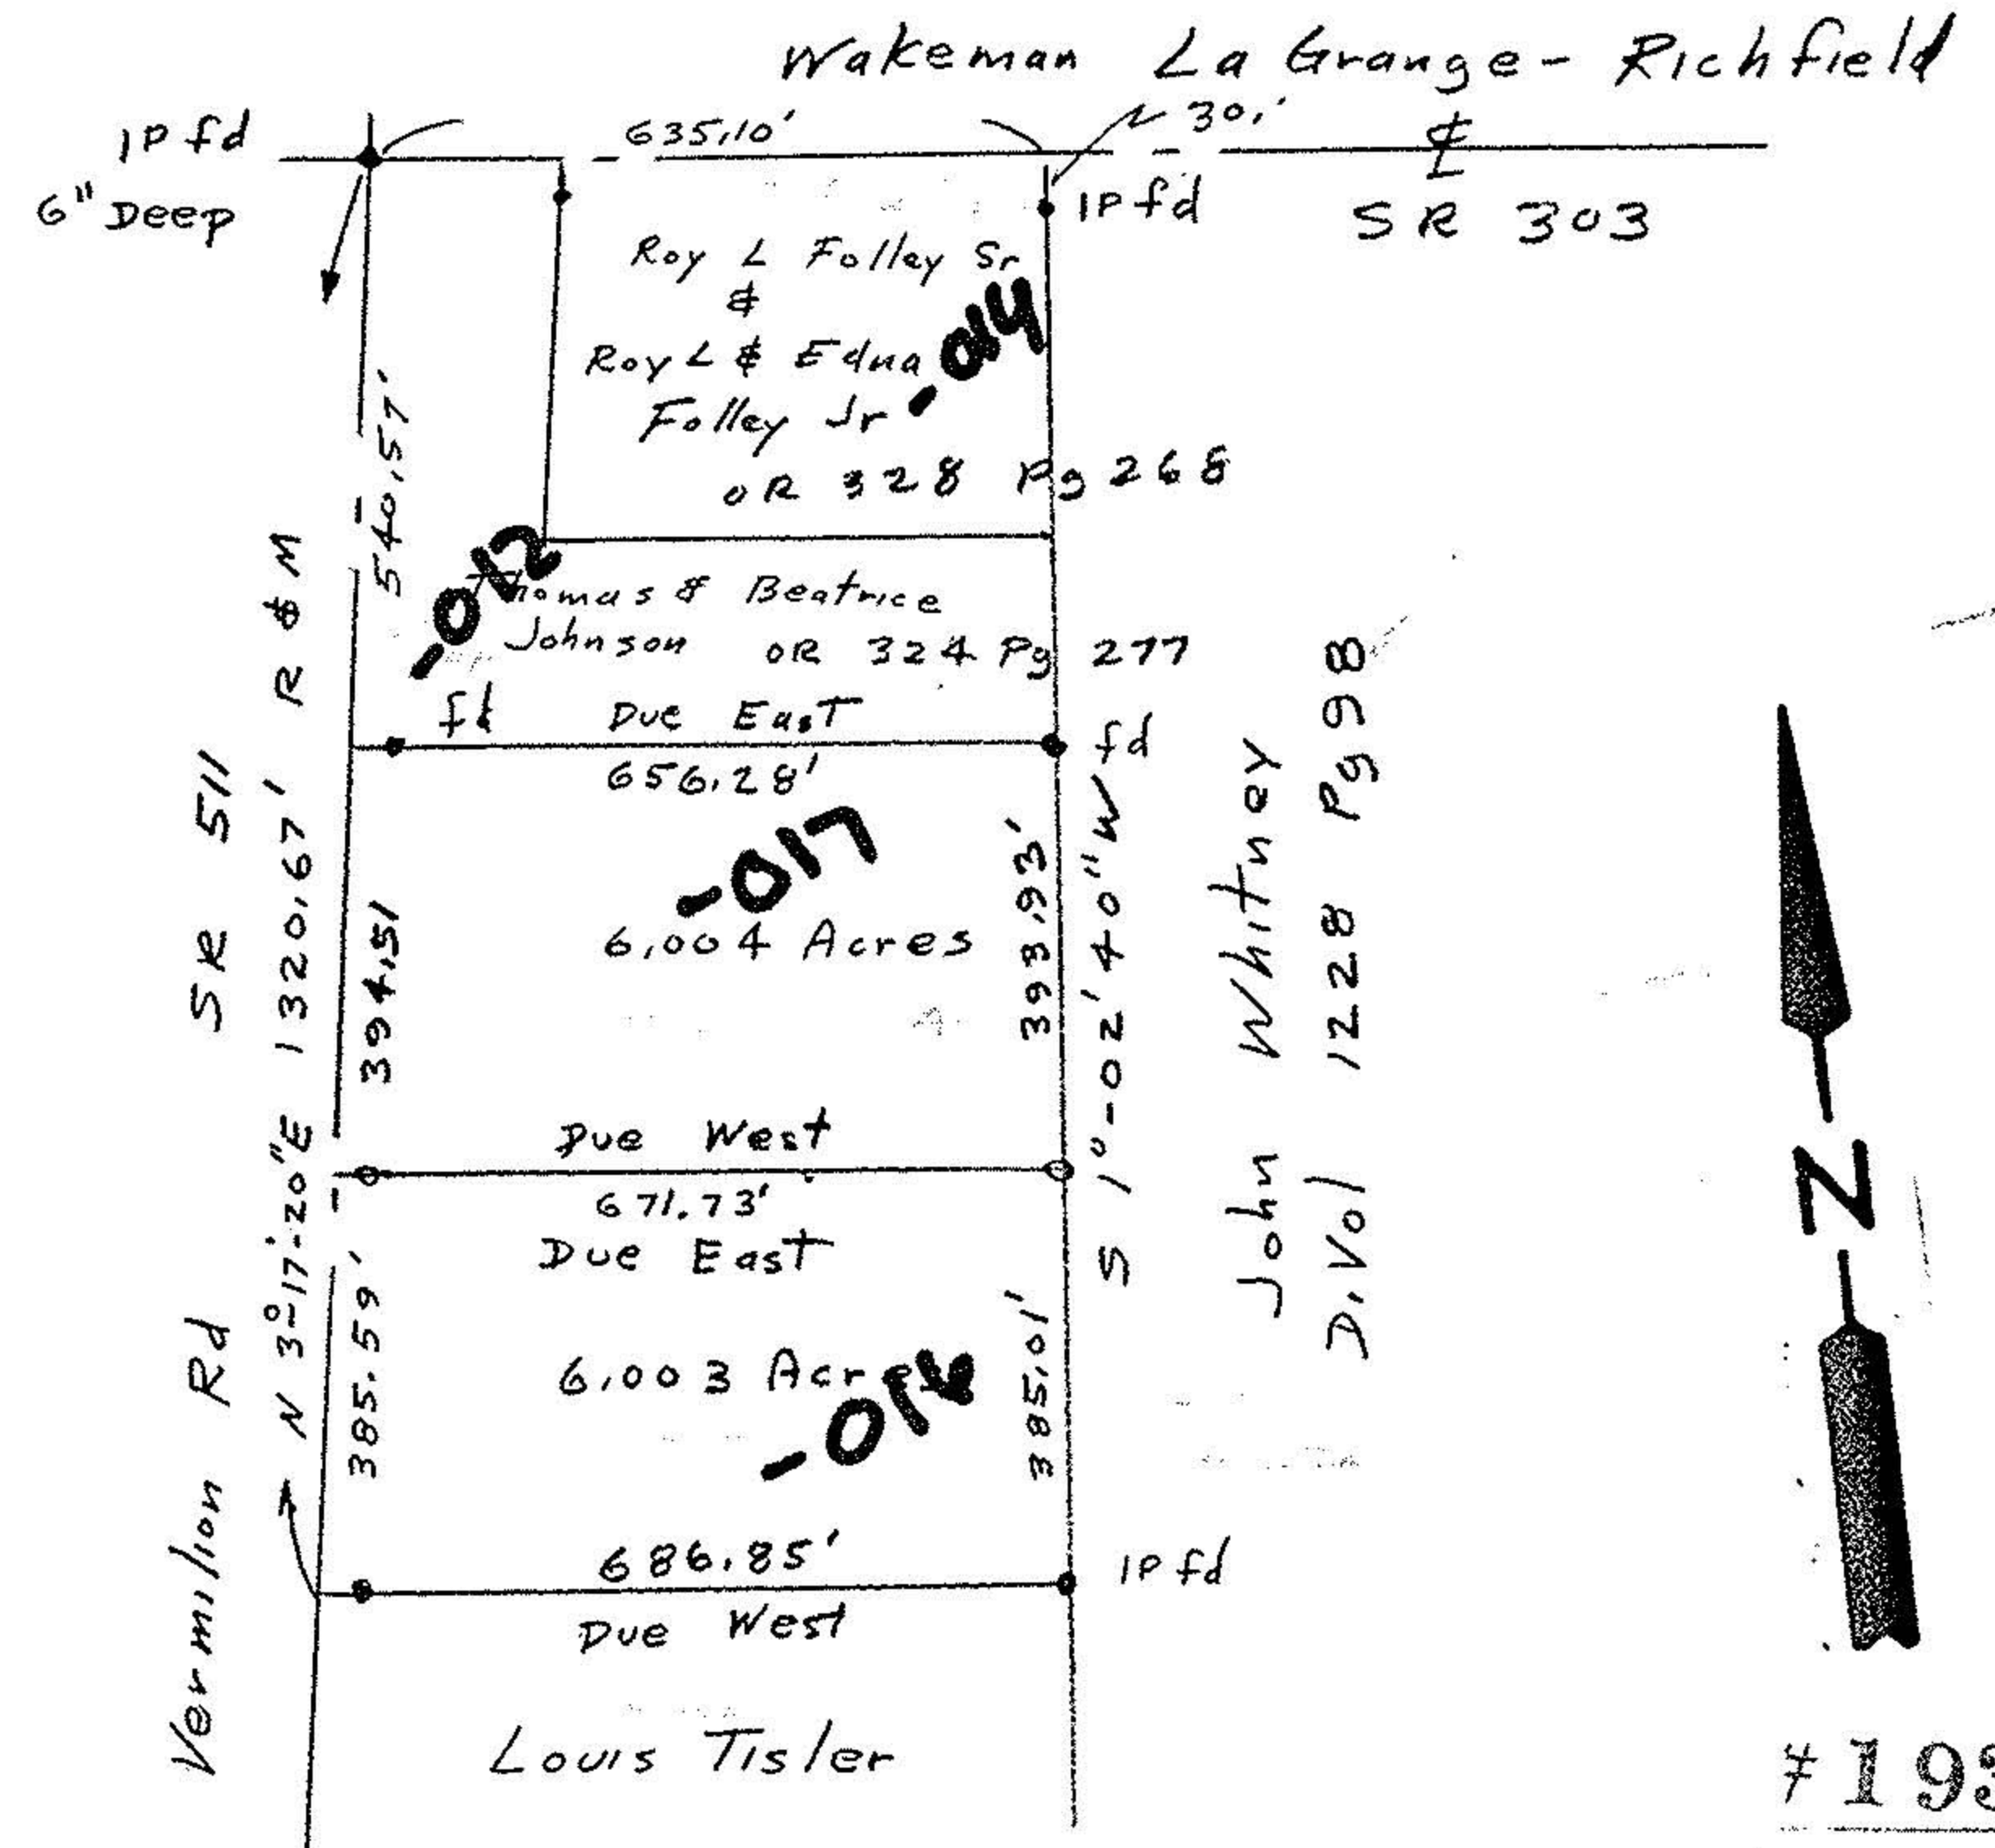

• iron pipes fd  
o iron pipes set 30.05 ft

John Pozzywak  
Reg Surveyor  
5292

Survey for Thomas Johnson  
Part Original Lot 5  
Tract 9 Camden Township  
Lorain County Ohio  
Scale 1" = 300' April 1991

#19374  
APPROVED  
LORAIN CO.  
MAP DEPT.  
DATE 5-21-91  
PAGE 13-G  
BY CAROLYN  
FRANCIS  
VOID AFTER # 19374

