


MAP OF SURVEY OF 1.00 AC. SPLIT
 FOR JOYCE IVES
 CAMDEN TWP. - TRACT 10 - D.L. 28
 10/88 SCALE 1"=100'
 JOHN R. HAMILTON - REG. SURV. #6861

#18268

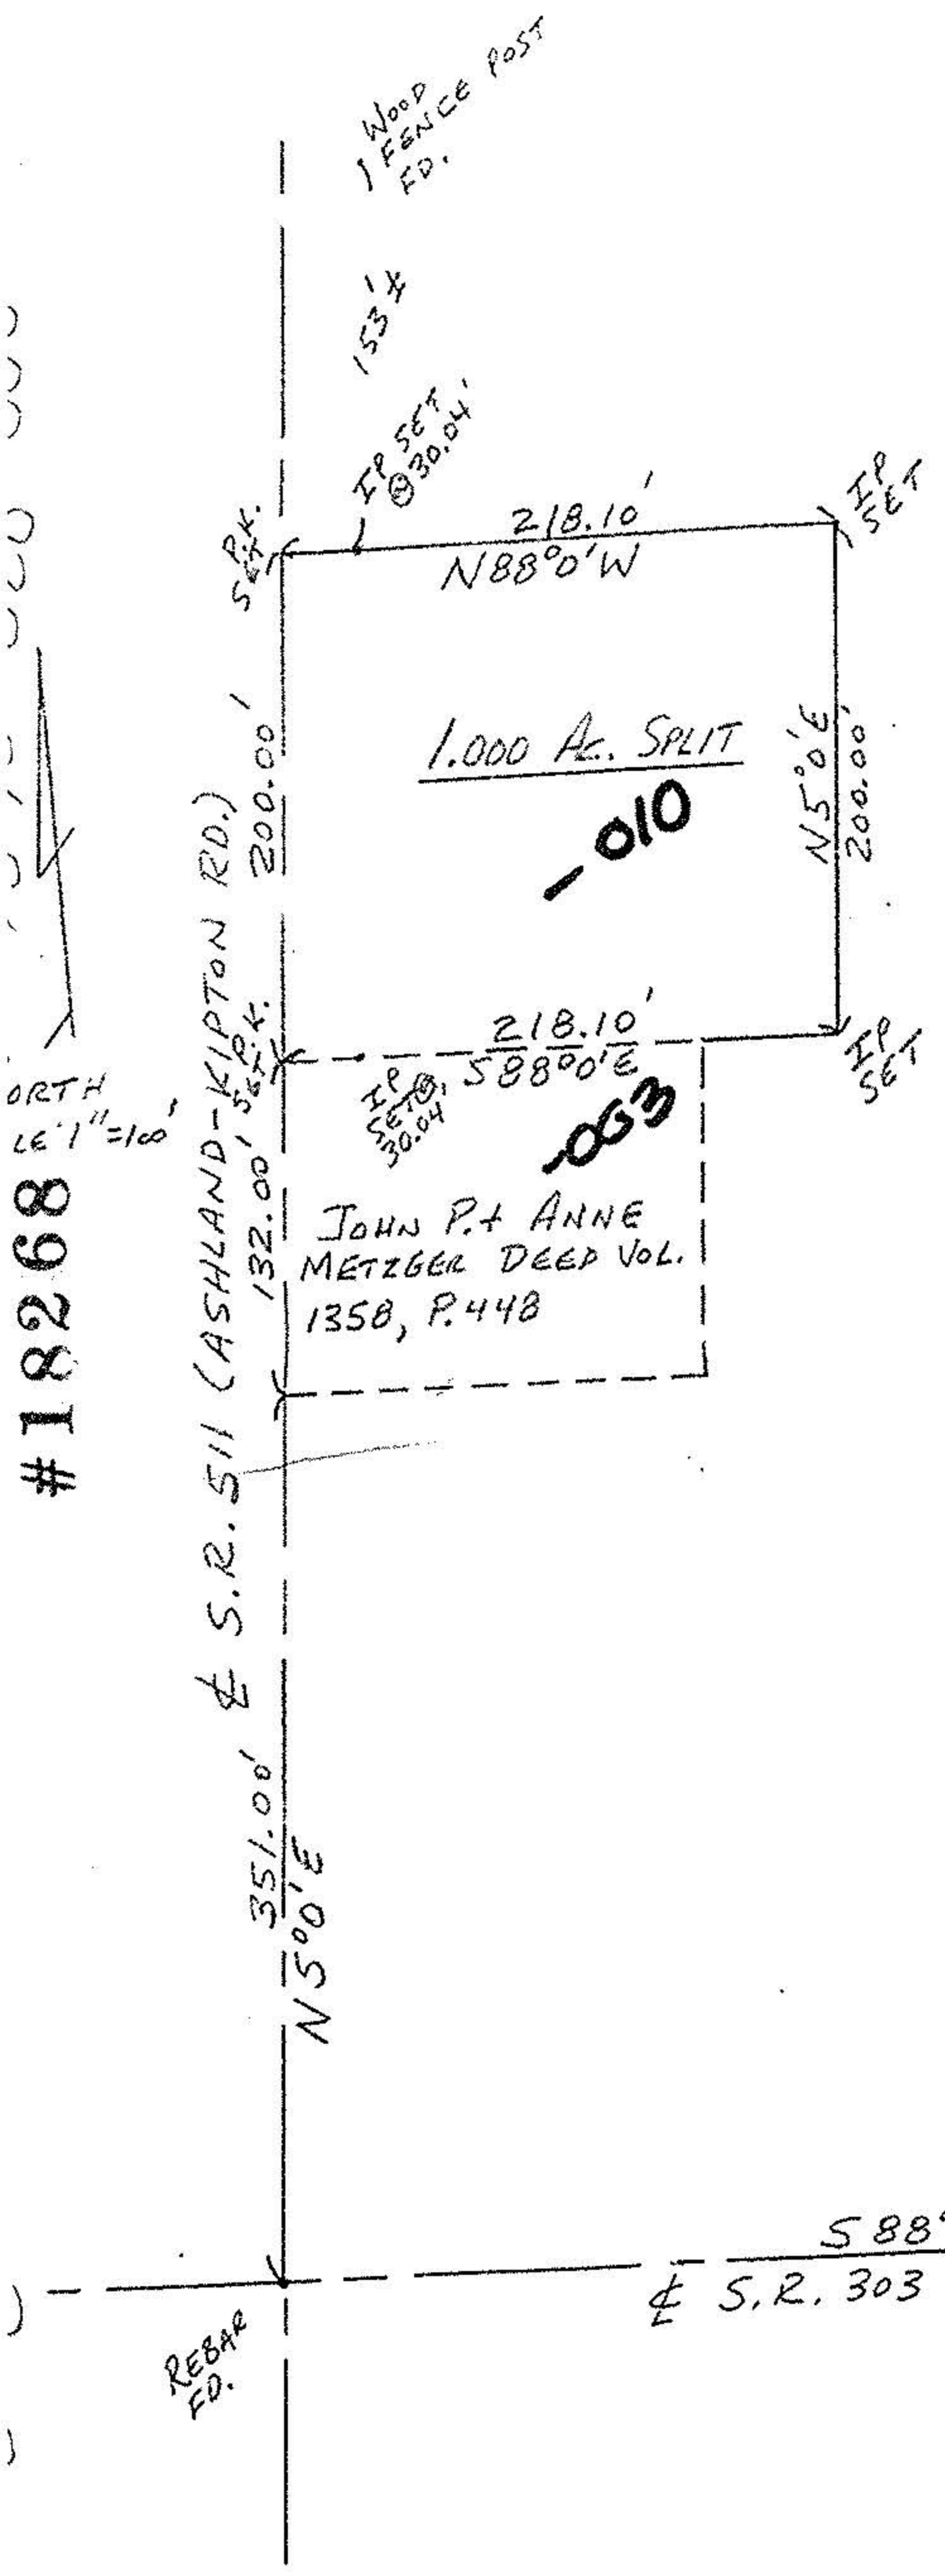

JOYCE IVES
 DEED VOL. 1006 P. 97
 8.00 AC. ORIG.
 7.00 AC. REM.

#18268

APPROVED LORAIN CO. MAP DEPT.	
DATE 12-27-88	
PAGE 13-C	
BY <i>Carol Fimmers</i>	
VOID AFTER	# 18268

