


13-H

A (3) (1) X

13-09-025-000
 PART OF SURVEY OF 4.00 ACRES
 FOR SCOT GRILLS
 D.L. 25 TRACT 9 - CAMDEN TWP.
 JOHN R. HAMILTON - REG. SURV.
 5/11/88 REV. 6/14/88 #6861

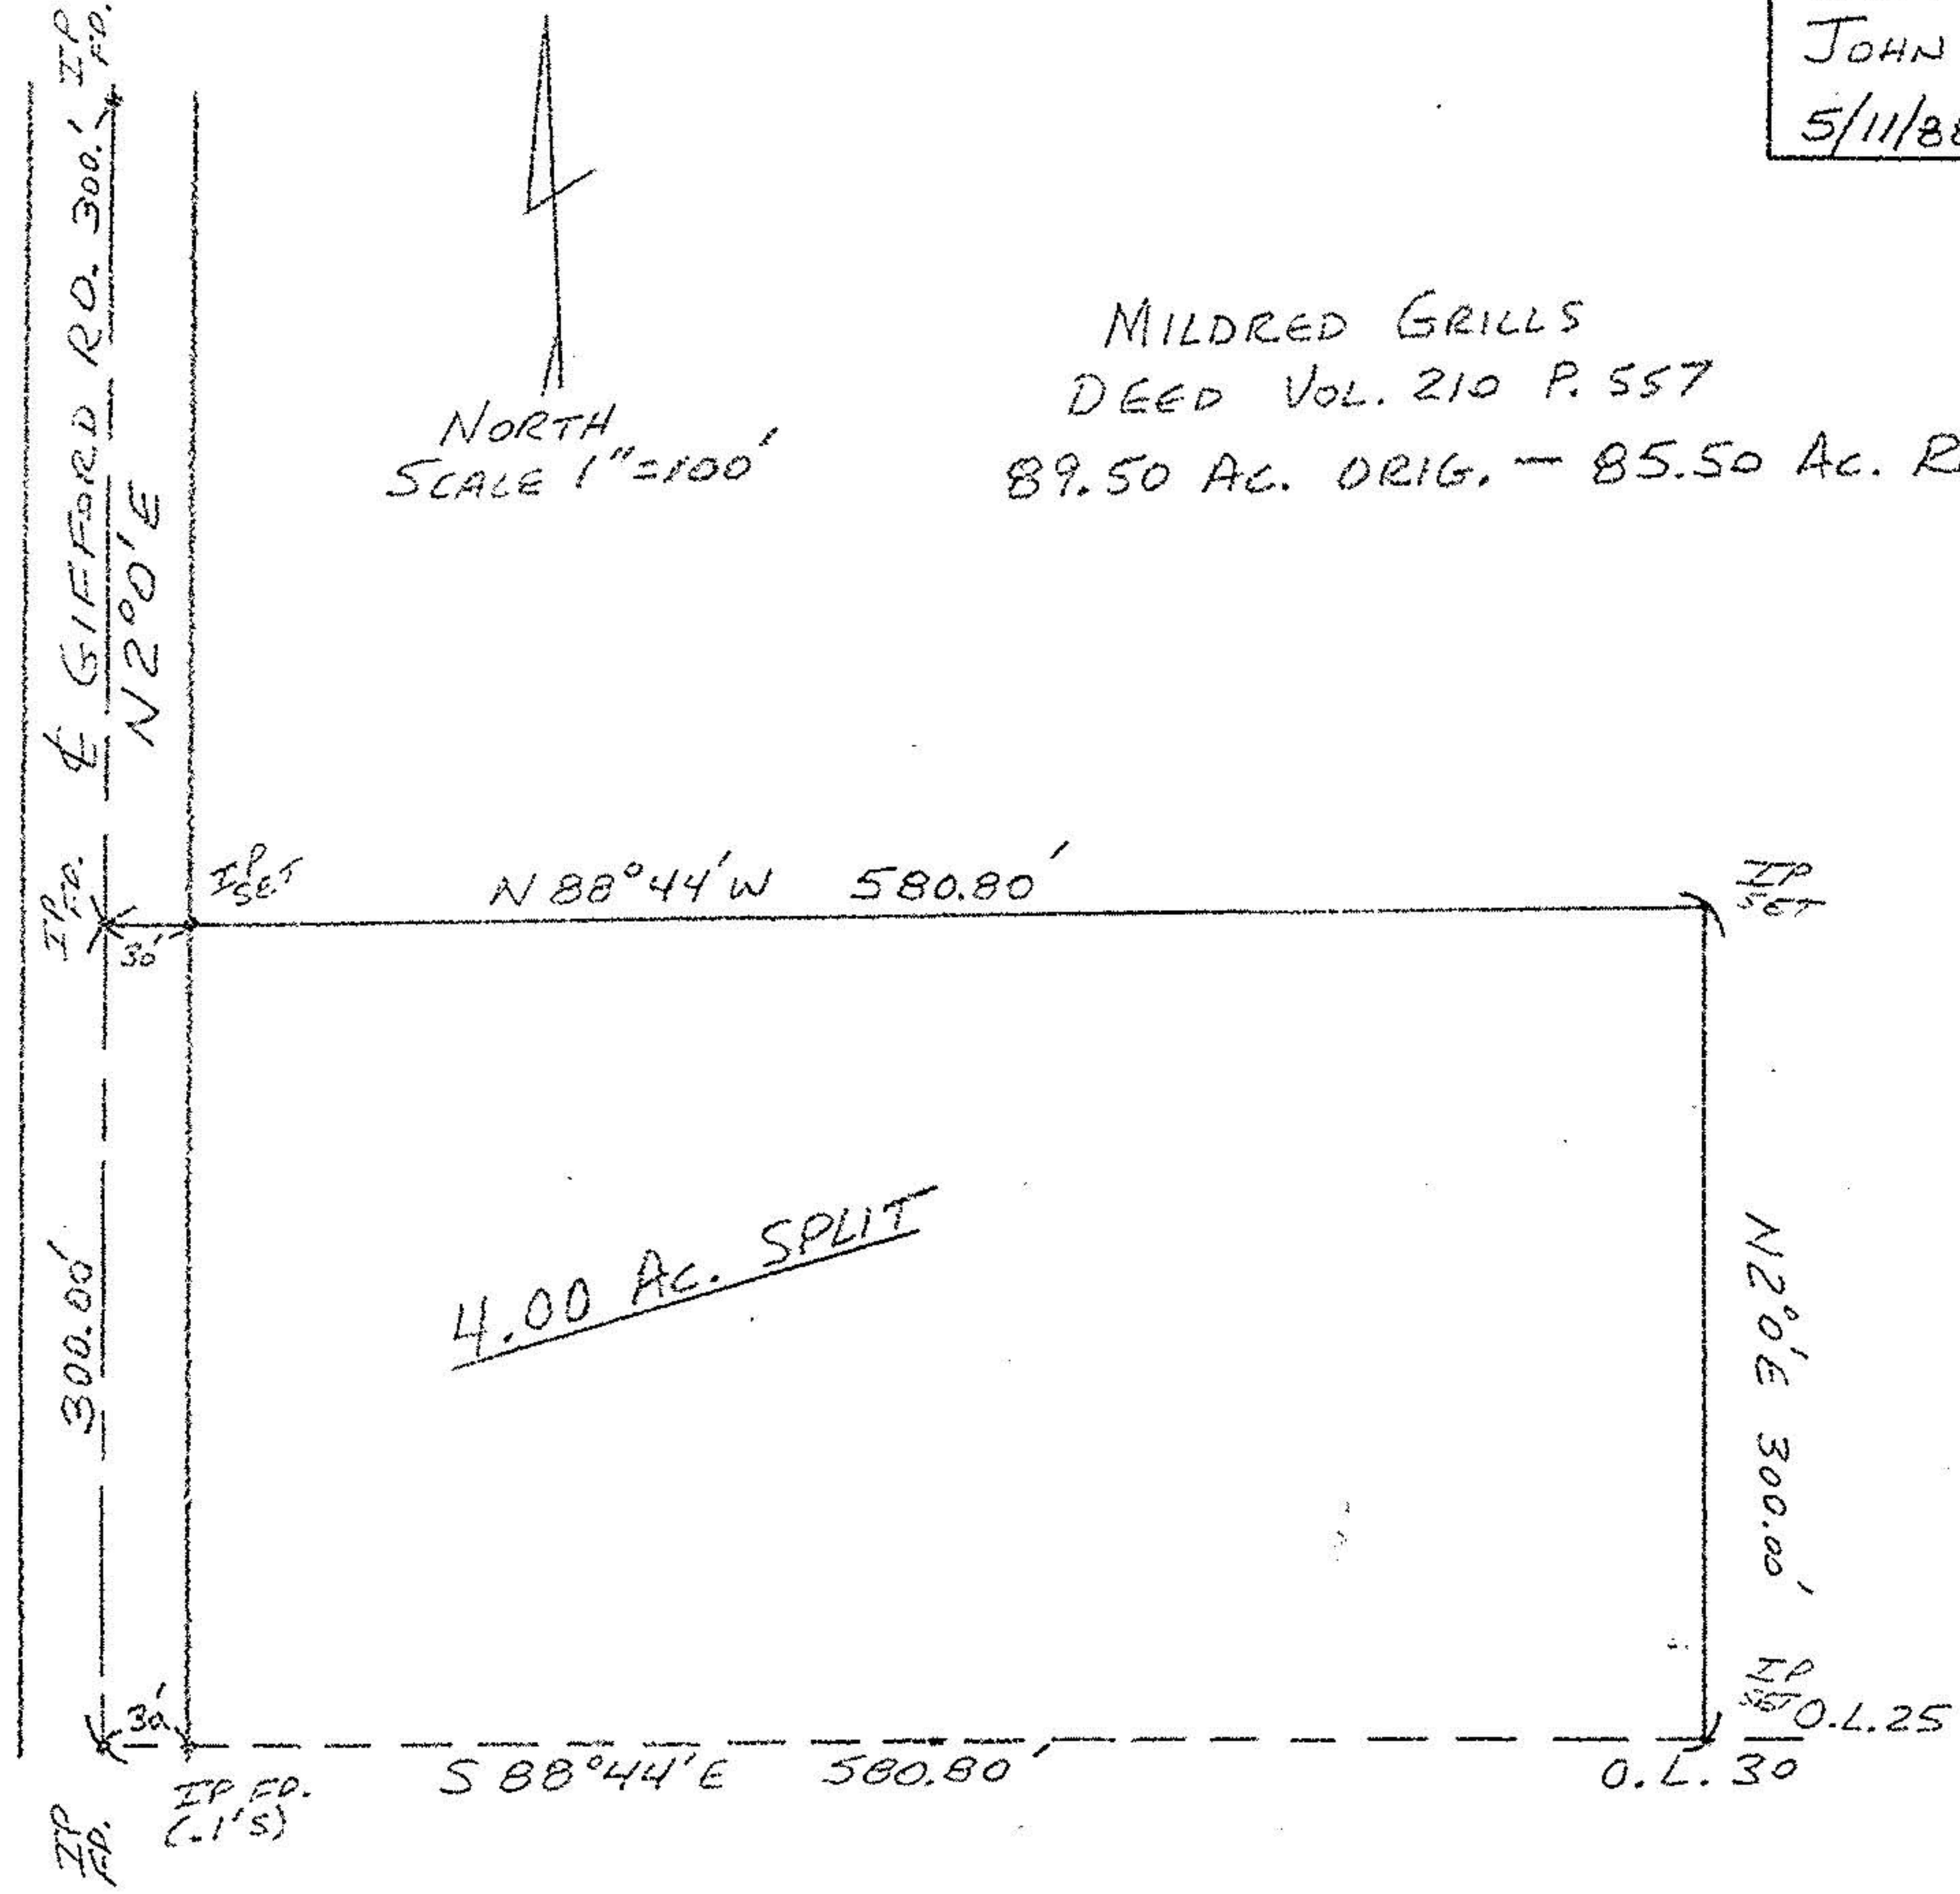

MILDRED GRILLS
 DEED VOL. 210 P. 557
 89.50 AC. ORIG. - 85.50 AC. REM.



18014

APPROVED
 LORAIN CO.
 MAP DEPT.

DATE 6-29-88

PAGE 13-H

BY Carol-Francis

VOID
 AFTER # 18014