


DISTANCES MISSING X

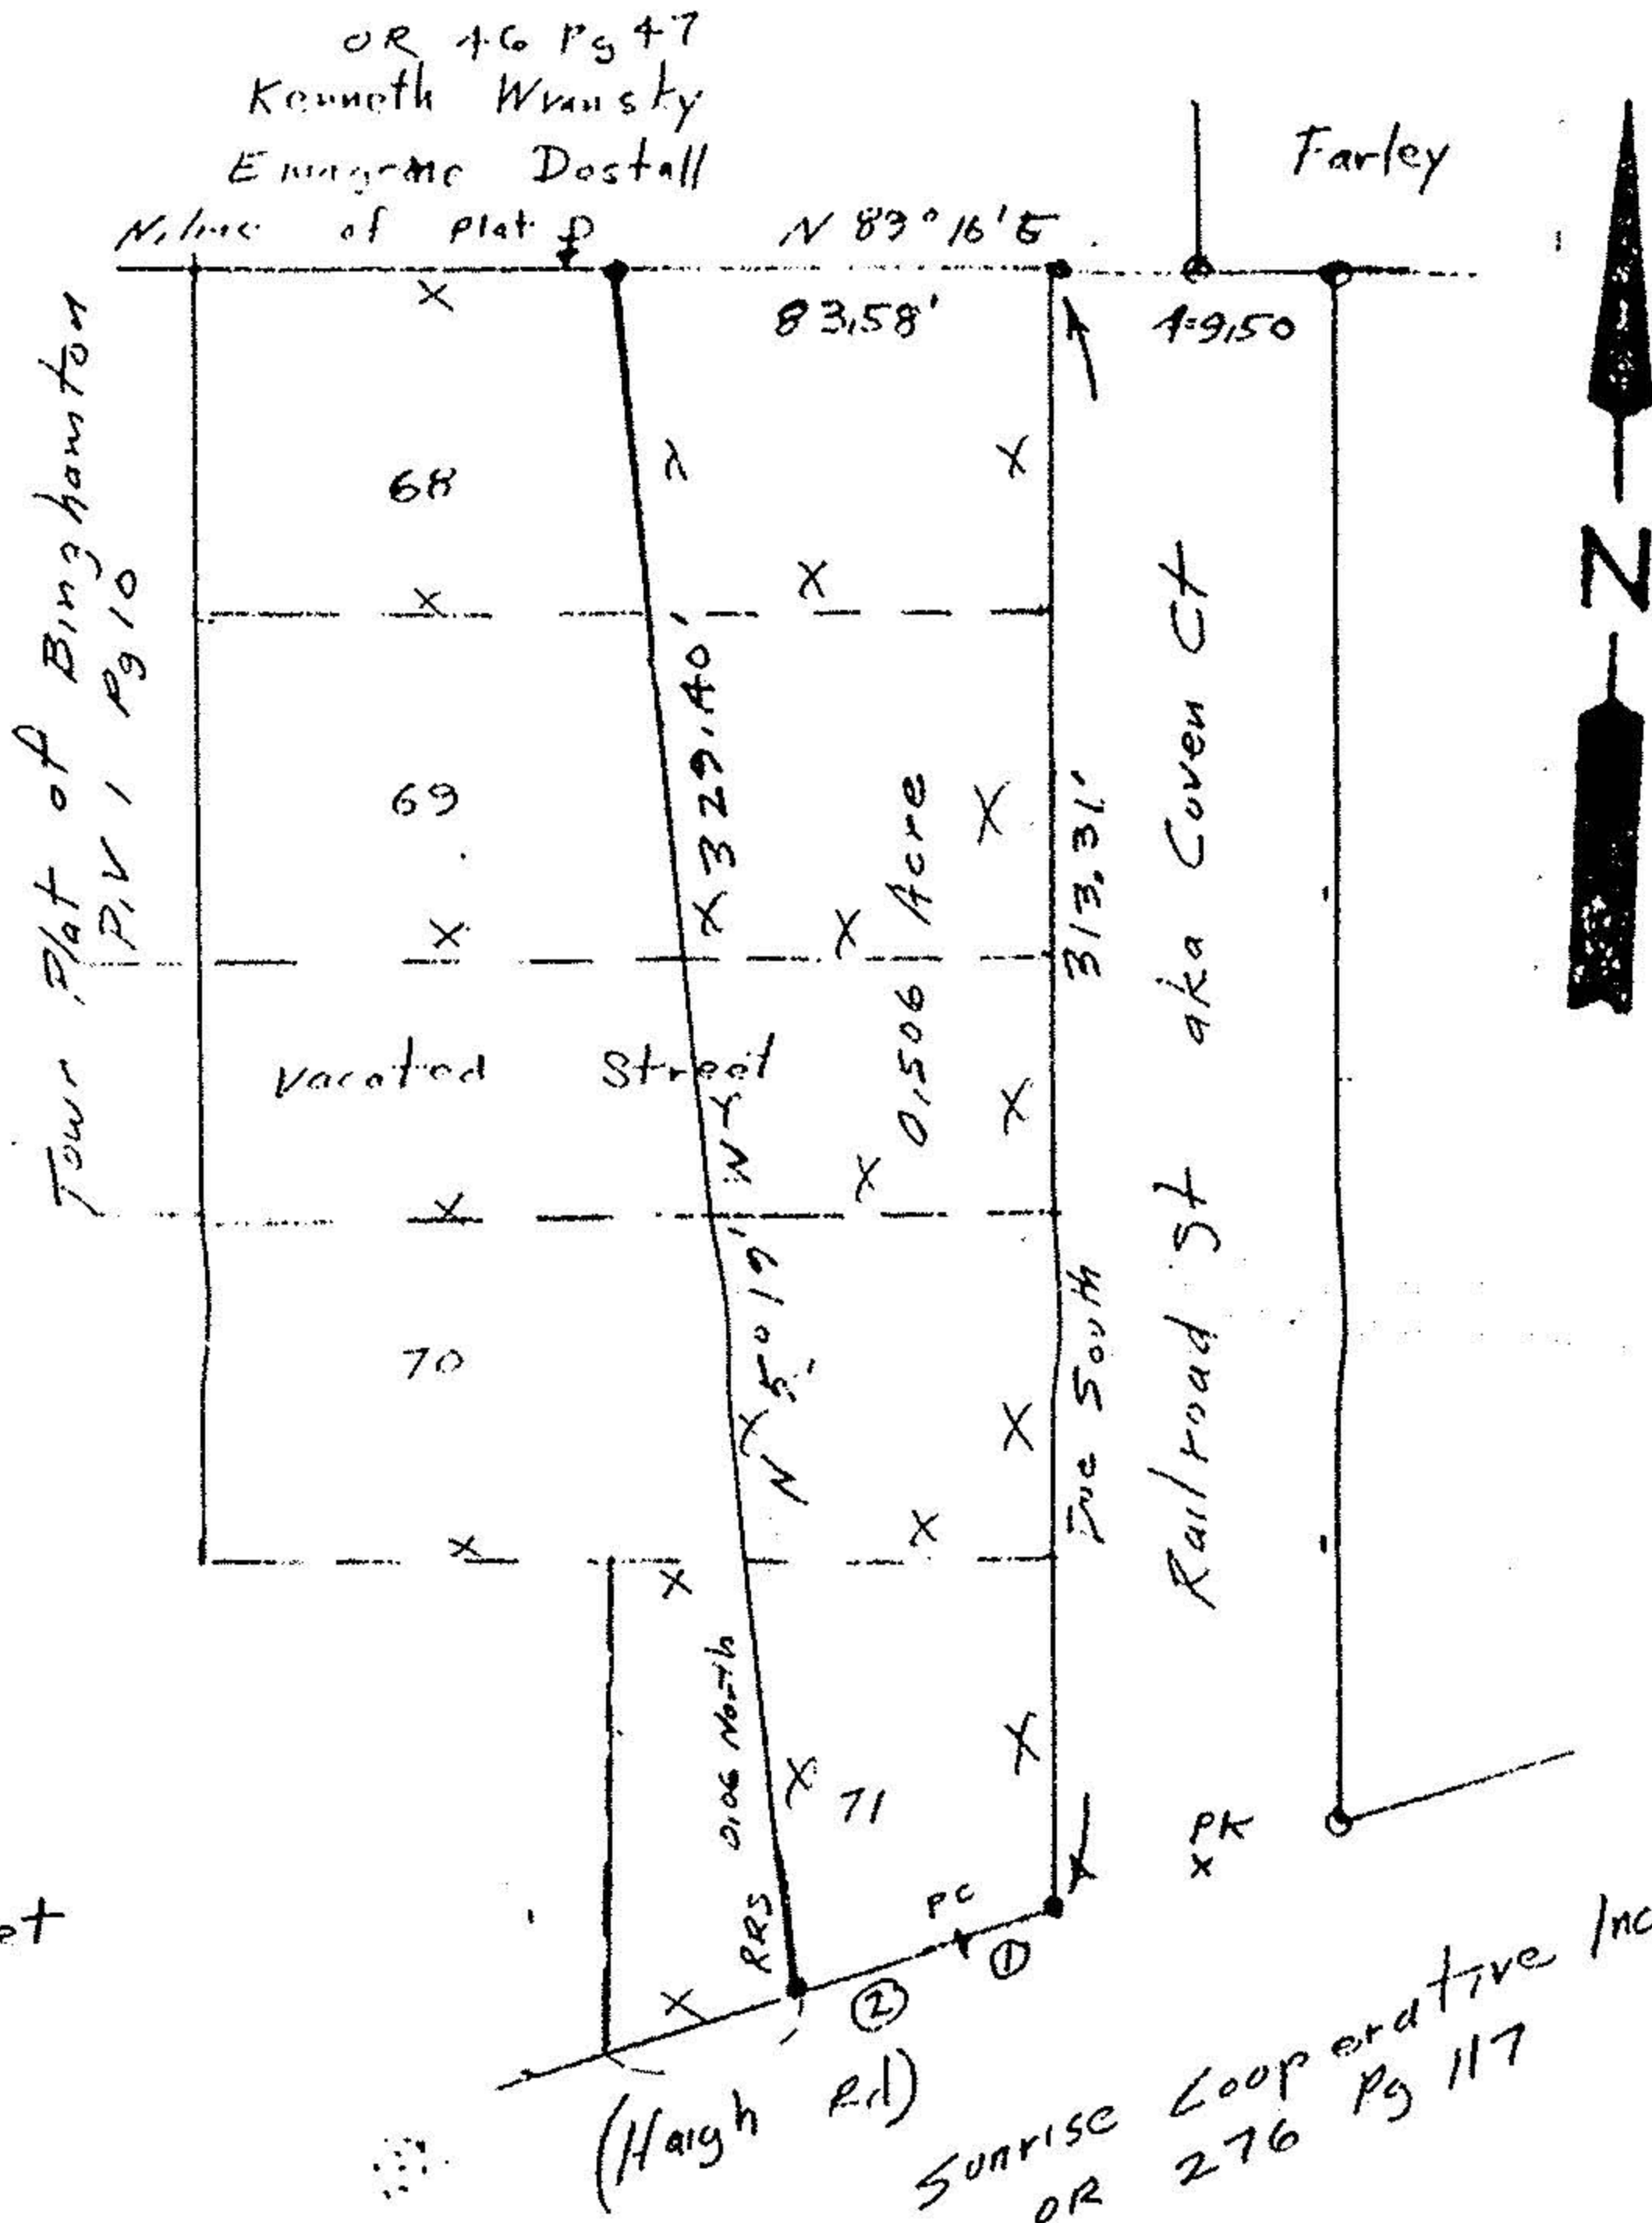


- o iron pipes fd
- iron pipes set
- x PK nail

- ① S 73° 32' W 18.00'
- ② S 73° 26' 34" W CB
Arc 37.24'
Ch 37.24
R = 11,784.35'

John Poznyak
Reg Surveyor
5292

Survey of
Parts of sublots 68, 69, 70, 71
Town Plat Binghamton
P. Vol 1 Pg 10
Tract 11 Original Lot 16
Original Camden Townshp
Lorain County Ohio
Scale 1" = 60' Nov 1992

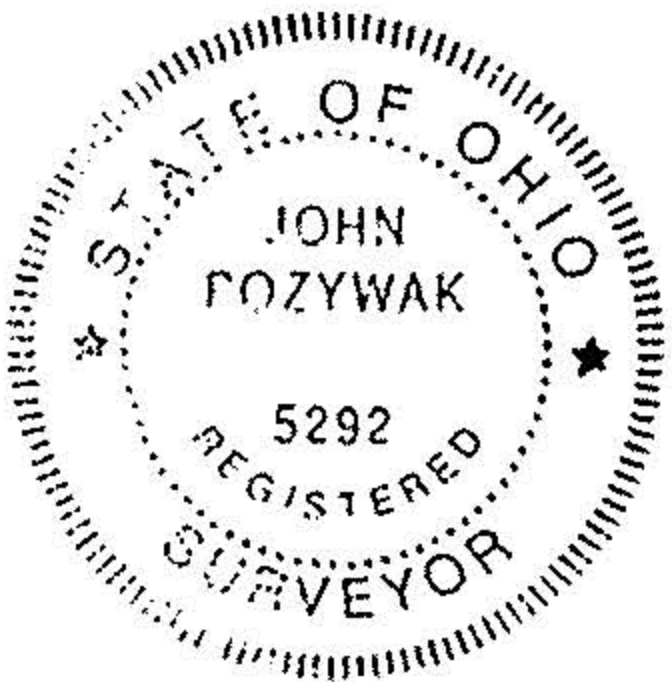

#30505