


13-C

#16822

15-10-112-300

Survey map of part of Lot 12 Tract 10 Camden Twp. Lorain Co. Ohio
 Scale 1" = 300' May 5, 1986
 By Arnold F. Koepp Reg. Surveyor No. 4306

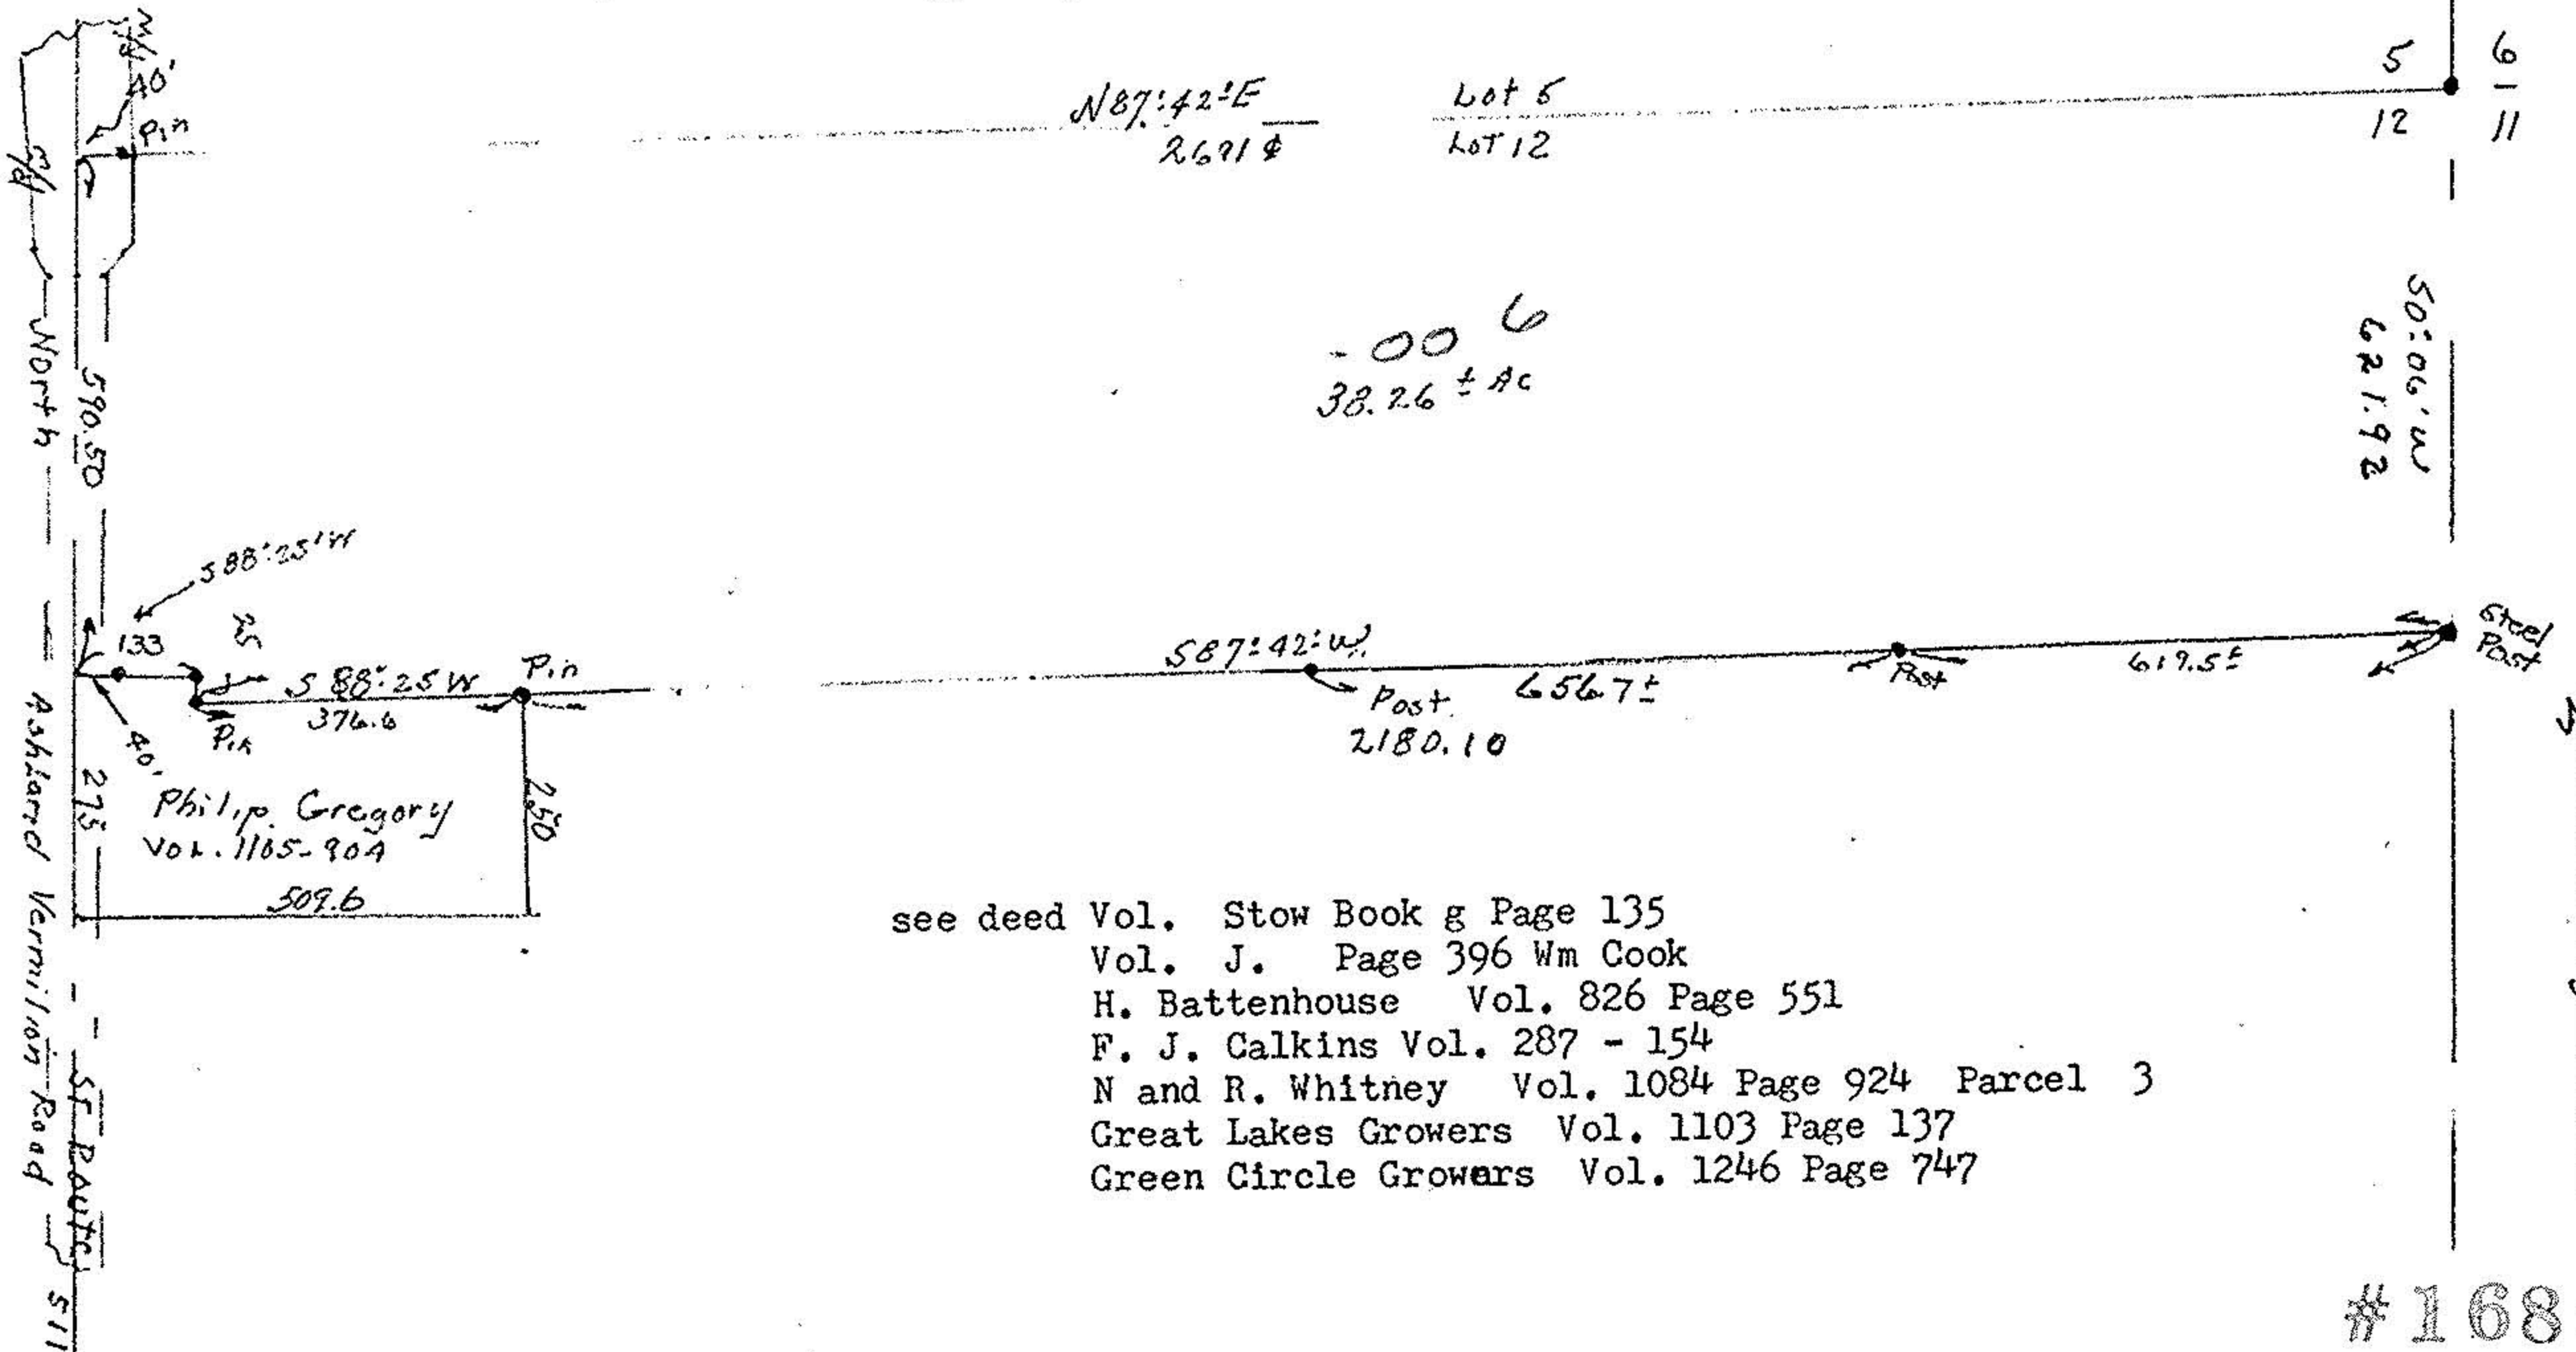

see deed Vol. Stow Book g Page 135
 Vol. J. Page 396 Wm Cook
 H. Battenhouse Vol. 826 Page 551
 F. J. Calkins Vol. 287 - 154
 N and R. Whitney Vol. 1084 Page 924 Parcel 3
 Great Lakes Growers Vol. 1103 Page 137
 Green Circle Growers Vol. 1246 Page 747

#16822

APPROVED LORAIN CO. MAP DEPT.	
DATE	6-30-86
PAGE	13-C
BY	C Francis
VOID AFTER	1899



UNTS