




*Earl H. Hunter*  
*July 21, 1994*

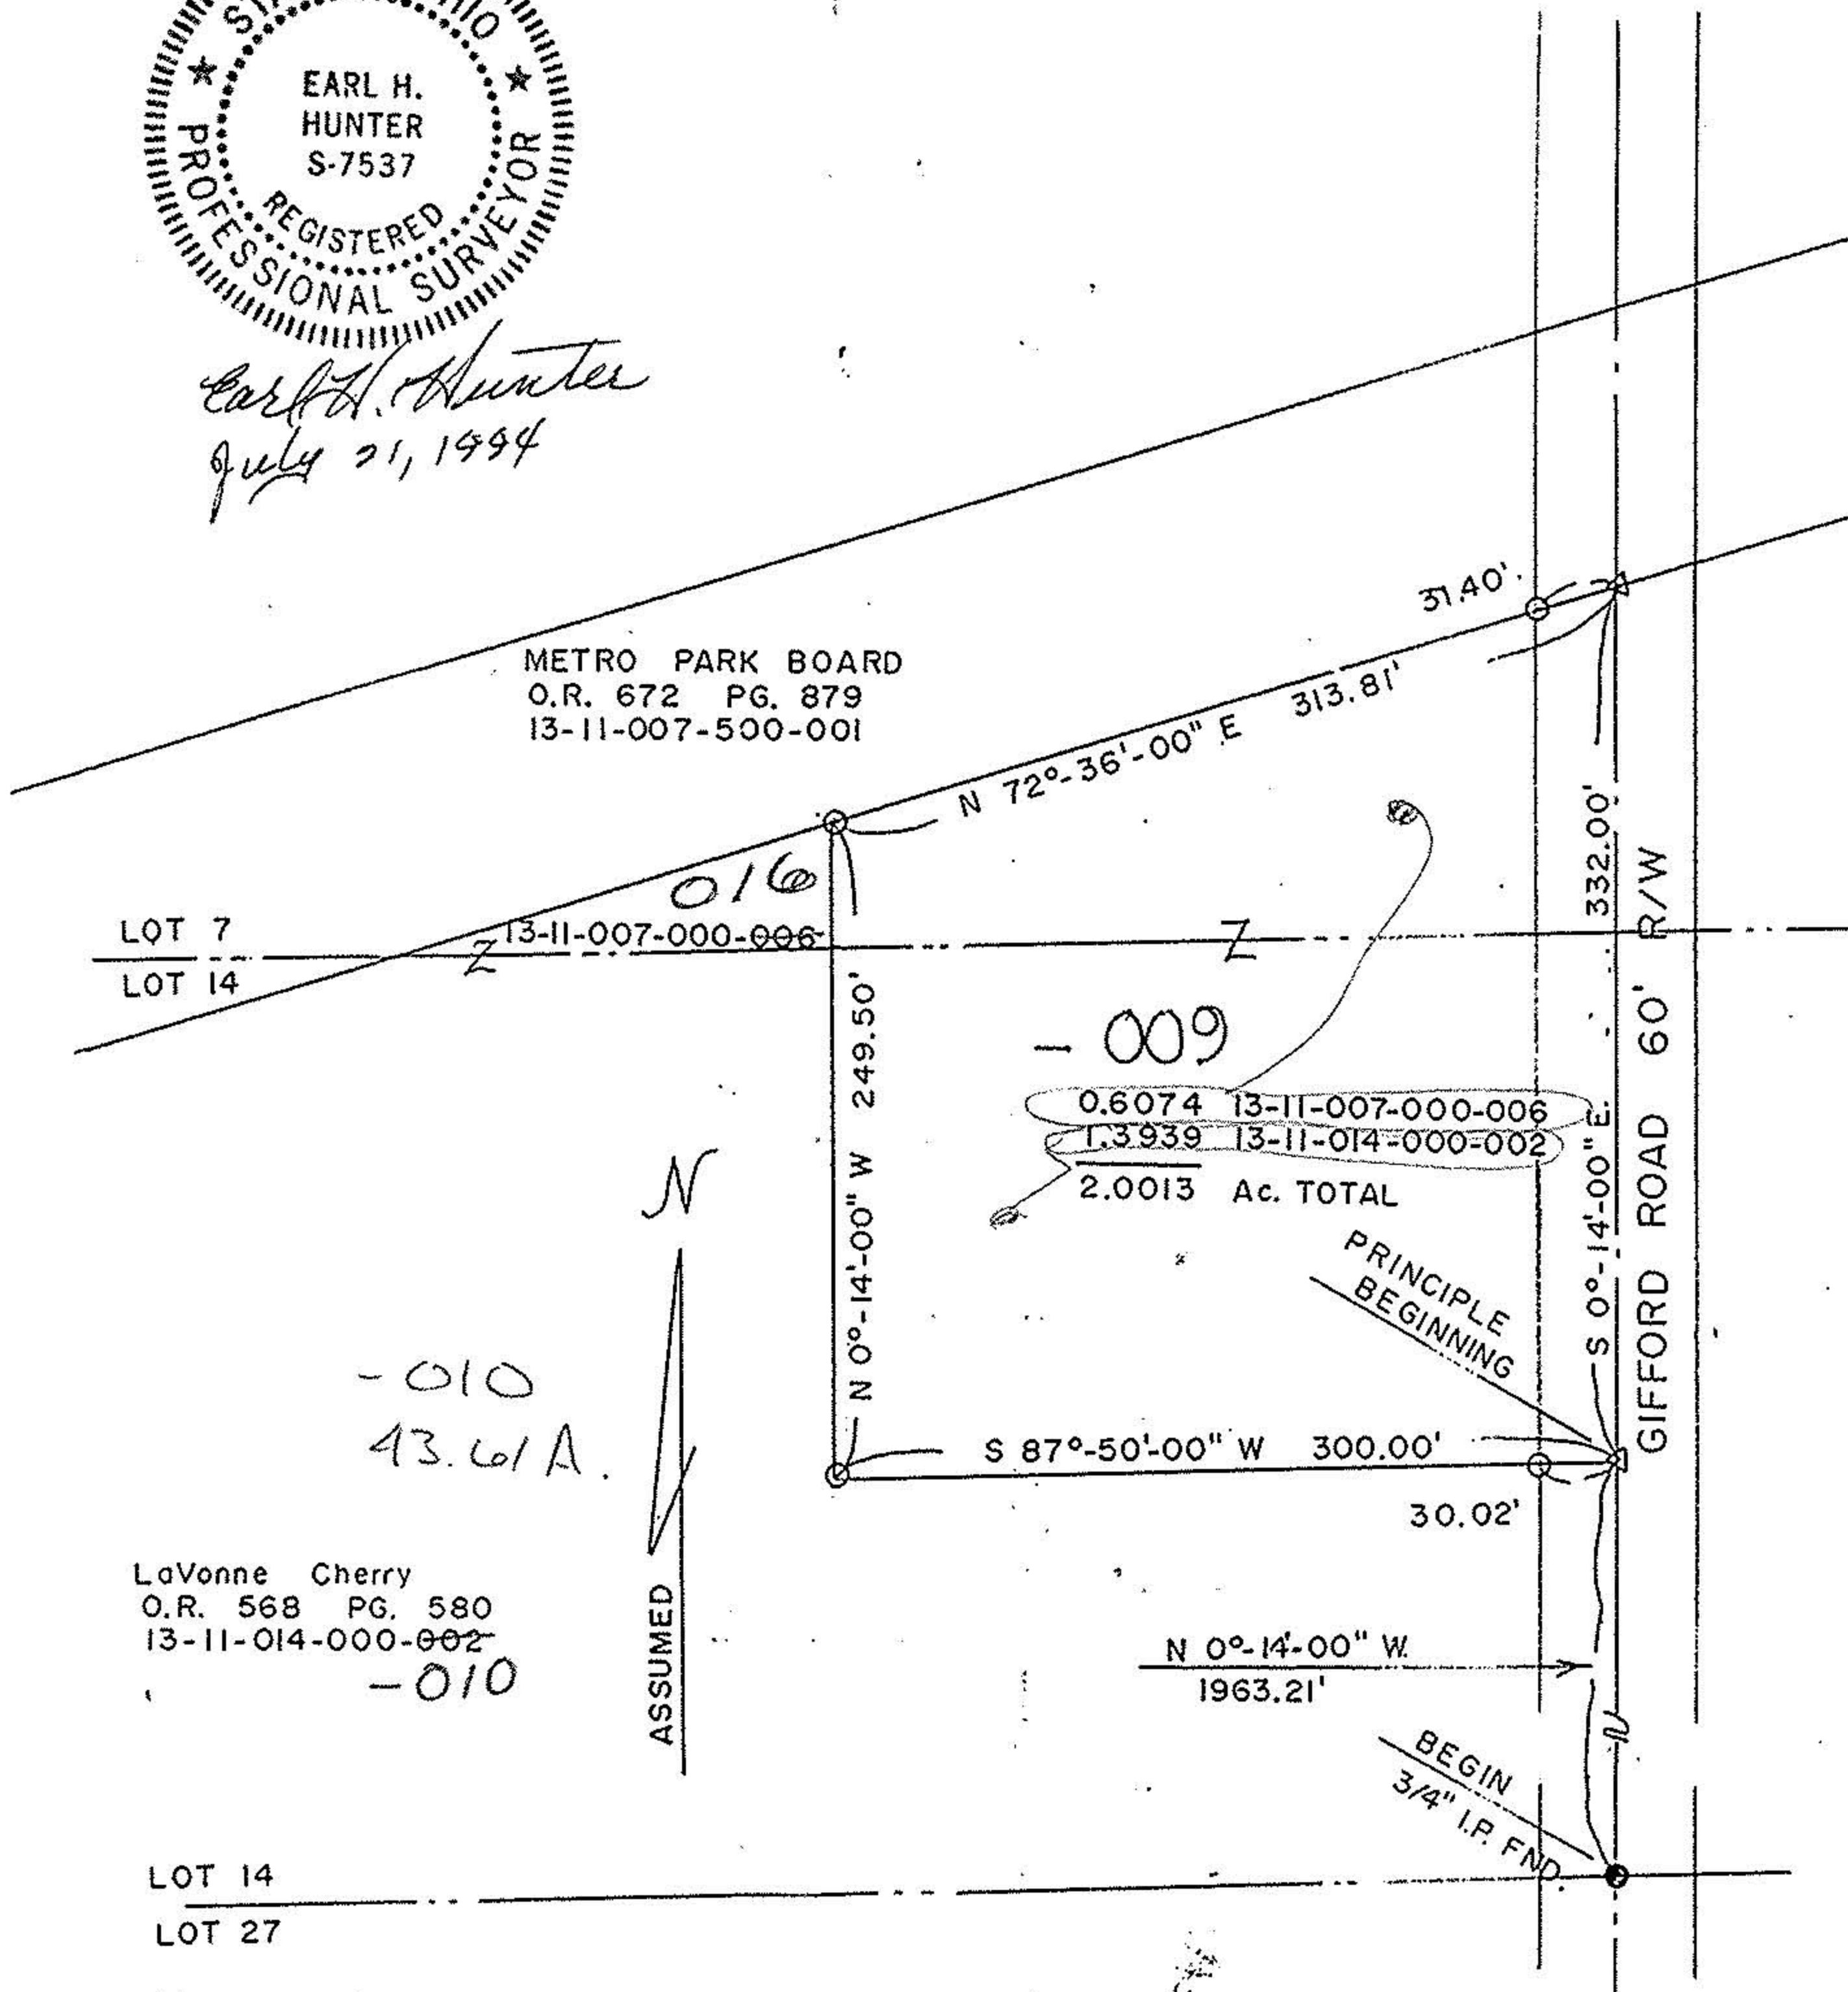

PLAT OF SURVEY FOR  
 MR. DAVID WALKER  
 OF PART OF LANDS OWNED BY  
 MRS. LAVONNE CHERRY

BEING PART OF  
 ORIGINAL LOTS 7 & 14,  
 TRACT 11  
 CAMDEN TOWNSHIP,  
 LORAIN COUNTY,  
 OHIO.



SCALE 1" = 100'

APRIL 25, 1994

20955

APPROVED LORAIN CO. MAP DEPT
DATE 7-21-94
PAGE 13-0
BY CAROLYN FRANCIS
#20955

ALL BEARINGS ARE TO AN ASSUMED  
 MERIDEAN FOR DESCRIPTION.

LEGEND:

- IRON PIN FOUND
- 3/4" DIA. IRON BAR SET
- ▲ SPIKE FOUND
- △ P.K. NAIL SET

EARL H. HUNTER, P.S.  
 1503 SANFORD STREET  
 VERMILION, OHIO 44089  
 (216) 967-2037