


Gloria Davidson
907 - 0073

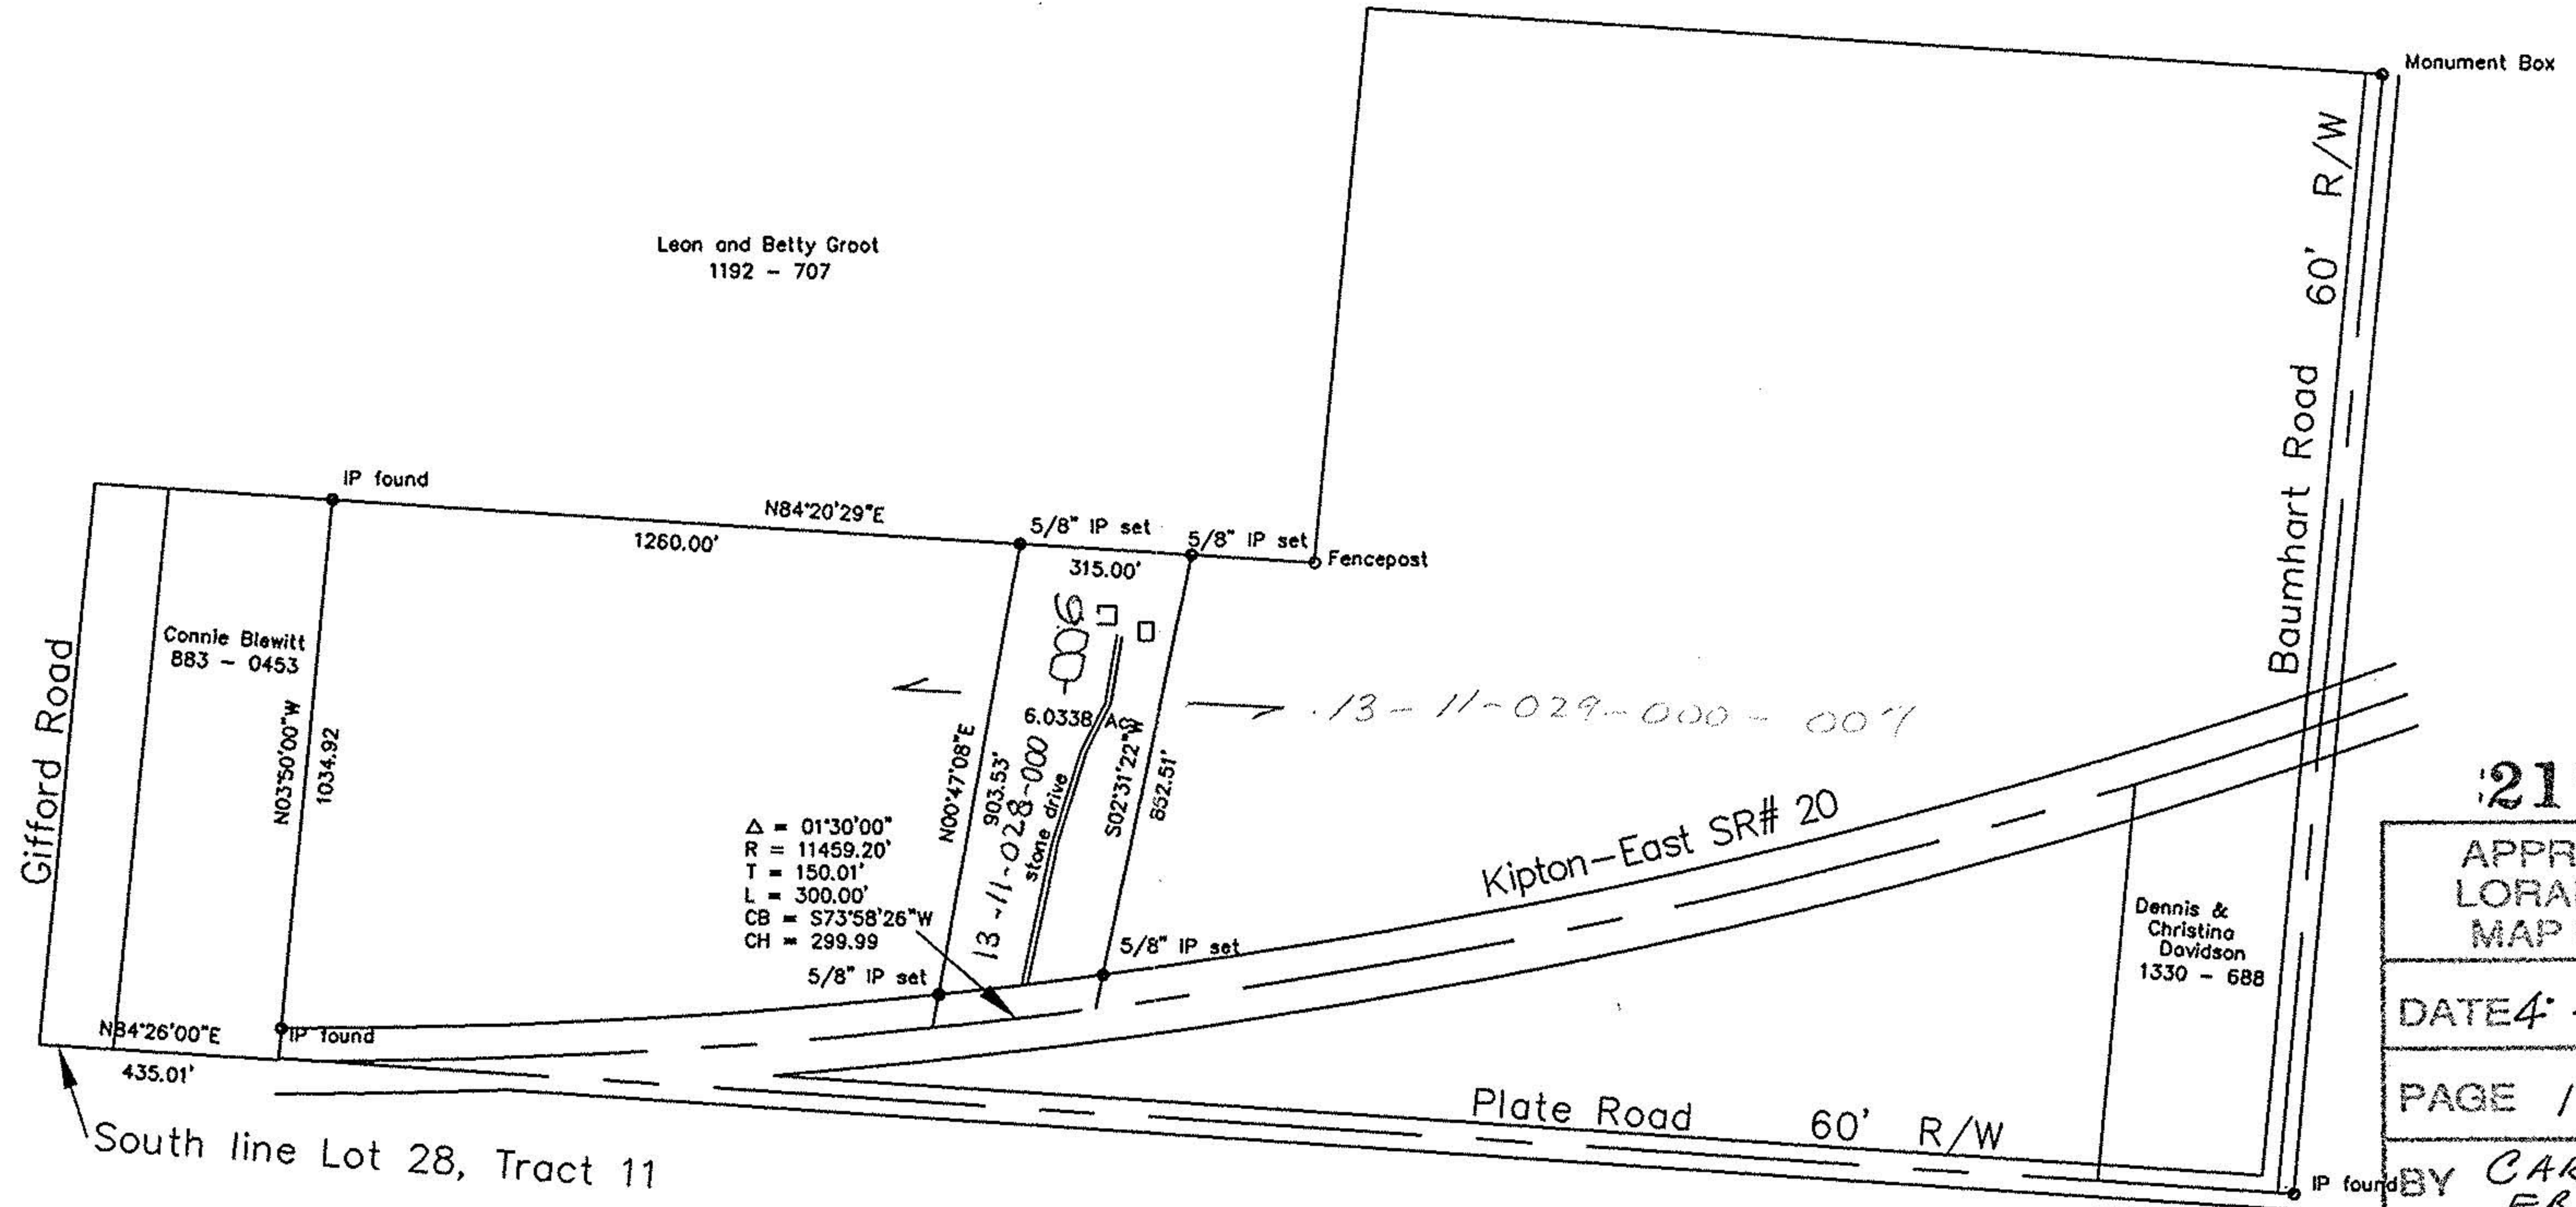

21741



APPROVED
LORAIN CO.
MAP DEPT

DATE: 4-18-96

PAGE 13-D

BY CAROLYN
FRANCIS

21741

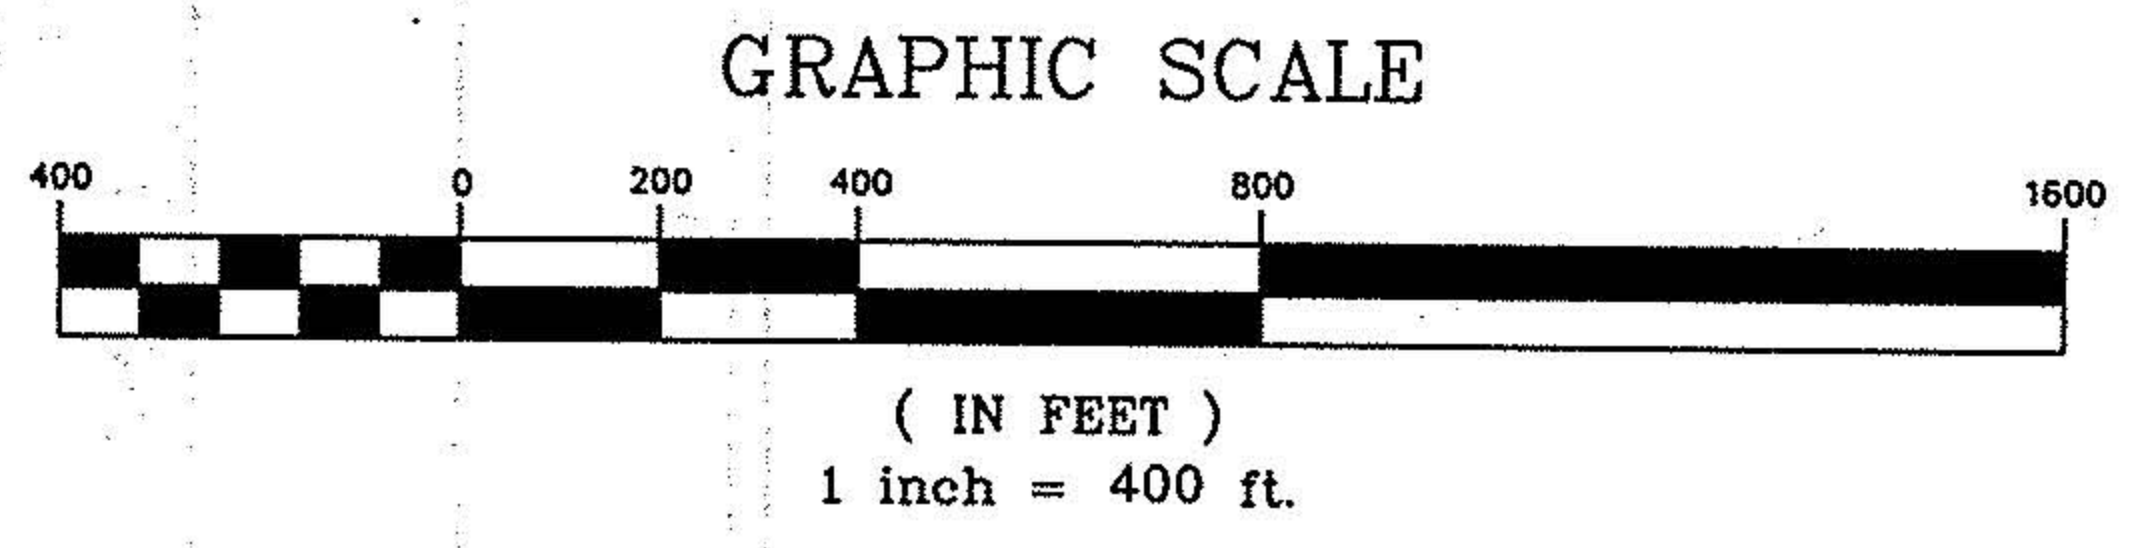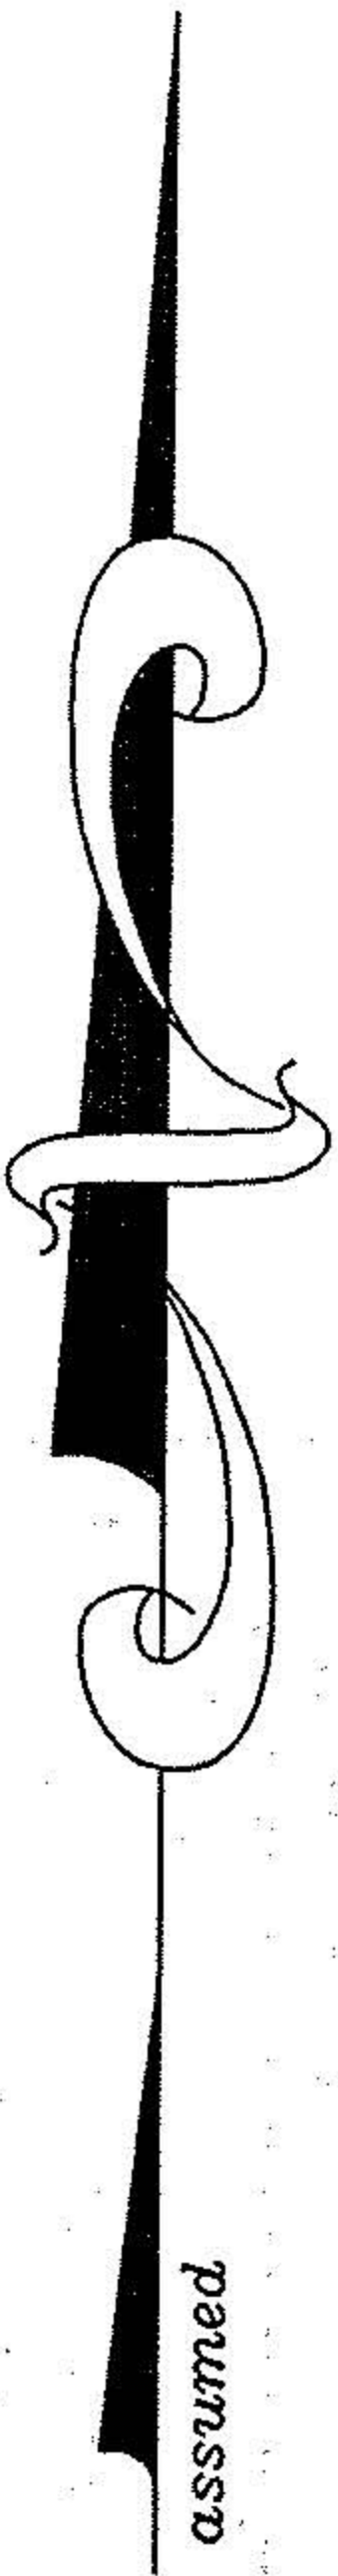

Carl Feick
Carl M. Feick P.S. 7035

FEICK SURVEYORS
224 East Water Street, Sandusky, Ohio 44870, 419-625-3241

DRAWN BY: CMF DATE: 10/12/95

JOB NO.: 54737 SHEET 1 OF 1

Plat of Survey

Chuck Davidson

49300 Rt. 20 West
Tract 11, Lots 28 & 29
Camden Twp., Lorain Co. Ohio