



LAUNDON . SIMON . CAHL & ASSOC. INC.  
CONSULTING ENGINEERS & SURVEYORS  
219 COURT ST. ELYRIA, OHIO 44035

SURVEY FOR:


ANDREW S. & LINDA BISKUP

Orig. Lot 3	City of	Date APRIL '86 Scale 1"=100'
Orig. Sec	Village of	Dwn. by R.G.S. Chkd. by
Tract 8	County of LORAIN	Job No. 86-1466 F.B.
Township of CAMDEN	State of OHIO	Printed APR 7 1986

13-08-003-000

16682

13-F  
0.43  
T 8

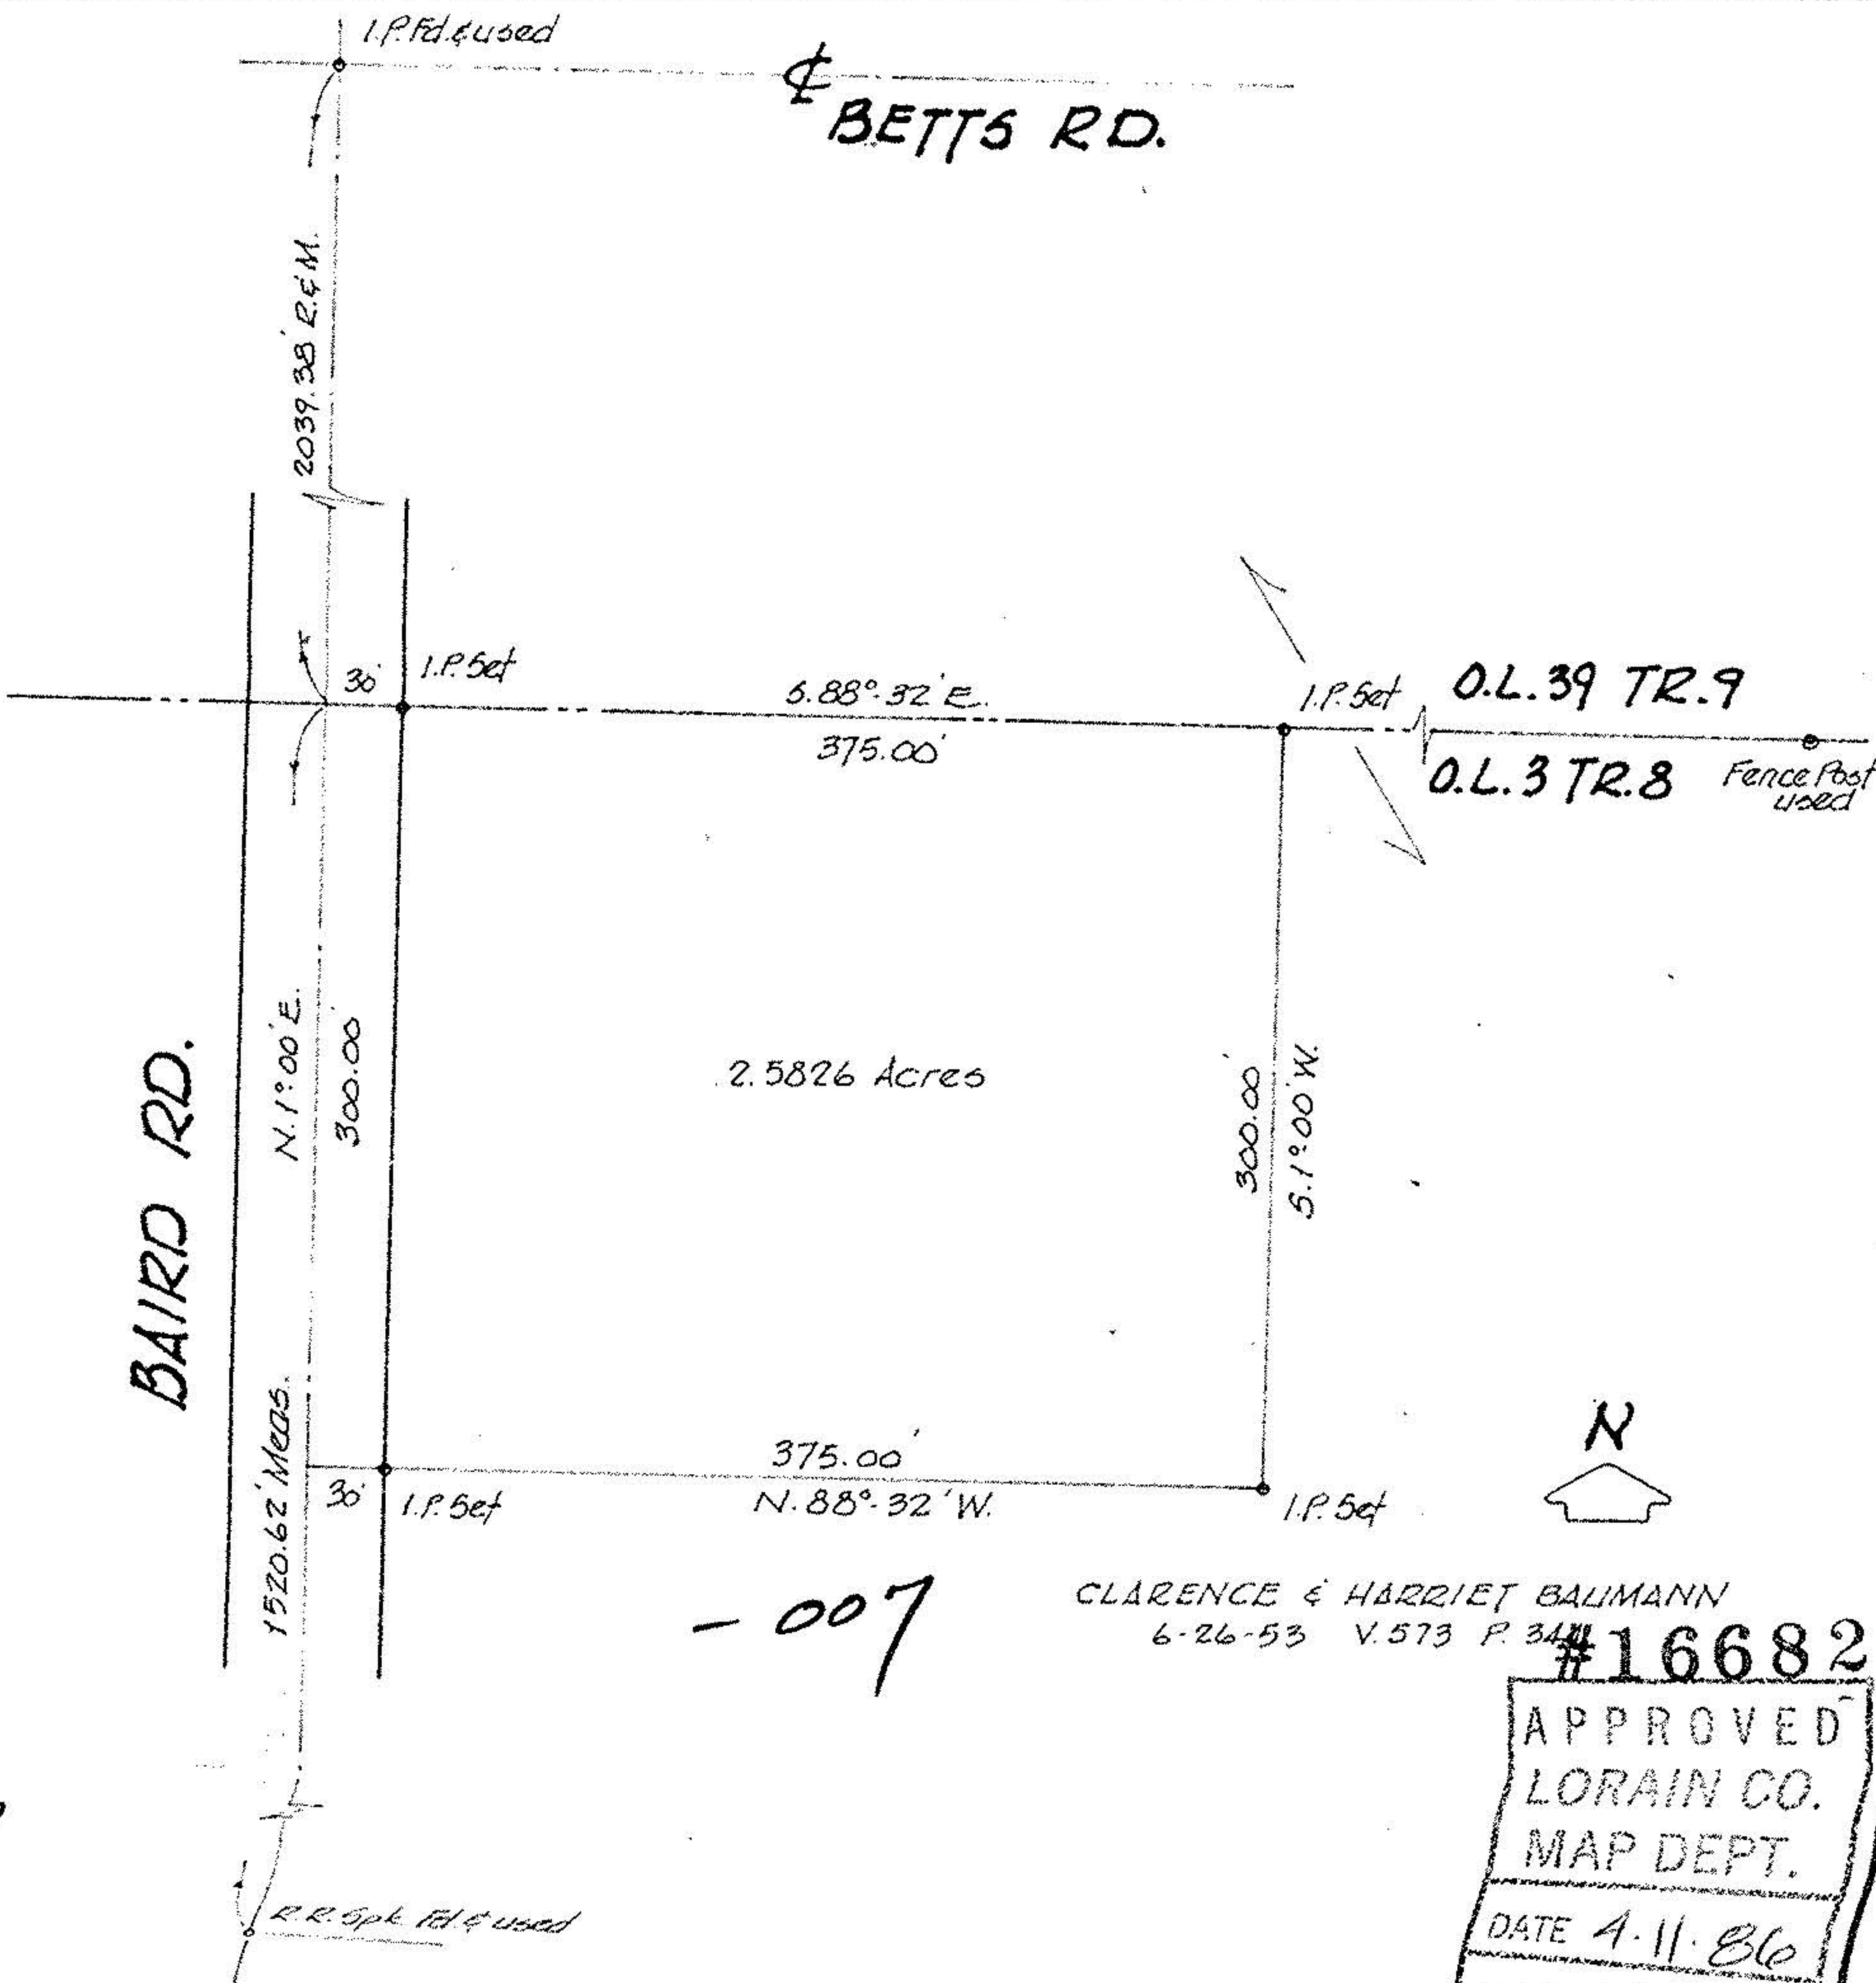

CLARENCE & HARRIET BALMANN  
6-26-53 V. 573 P. 34 #16682

APPROVED  
LORAIN CO.  
MAP DEPT.  
DATE 4-11-86  
PAGE 13-F  
BY T. McMain  
VOID  
AFTER