


WILLIAM B. BARTON
 Reg. Land Surveyor No. 4438
 188 PARKWOOD AVENUE
 AVON LAKE, OHIO 44012
 TELEPHONE (216) 933-6662

James L. & Marian E. Woodrum
 D.V. 1183 Pg. 747 -012

Tract No. 9 - D.L. 13

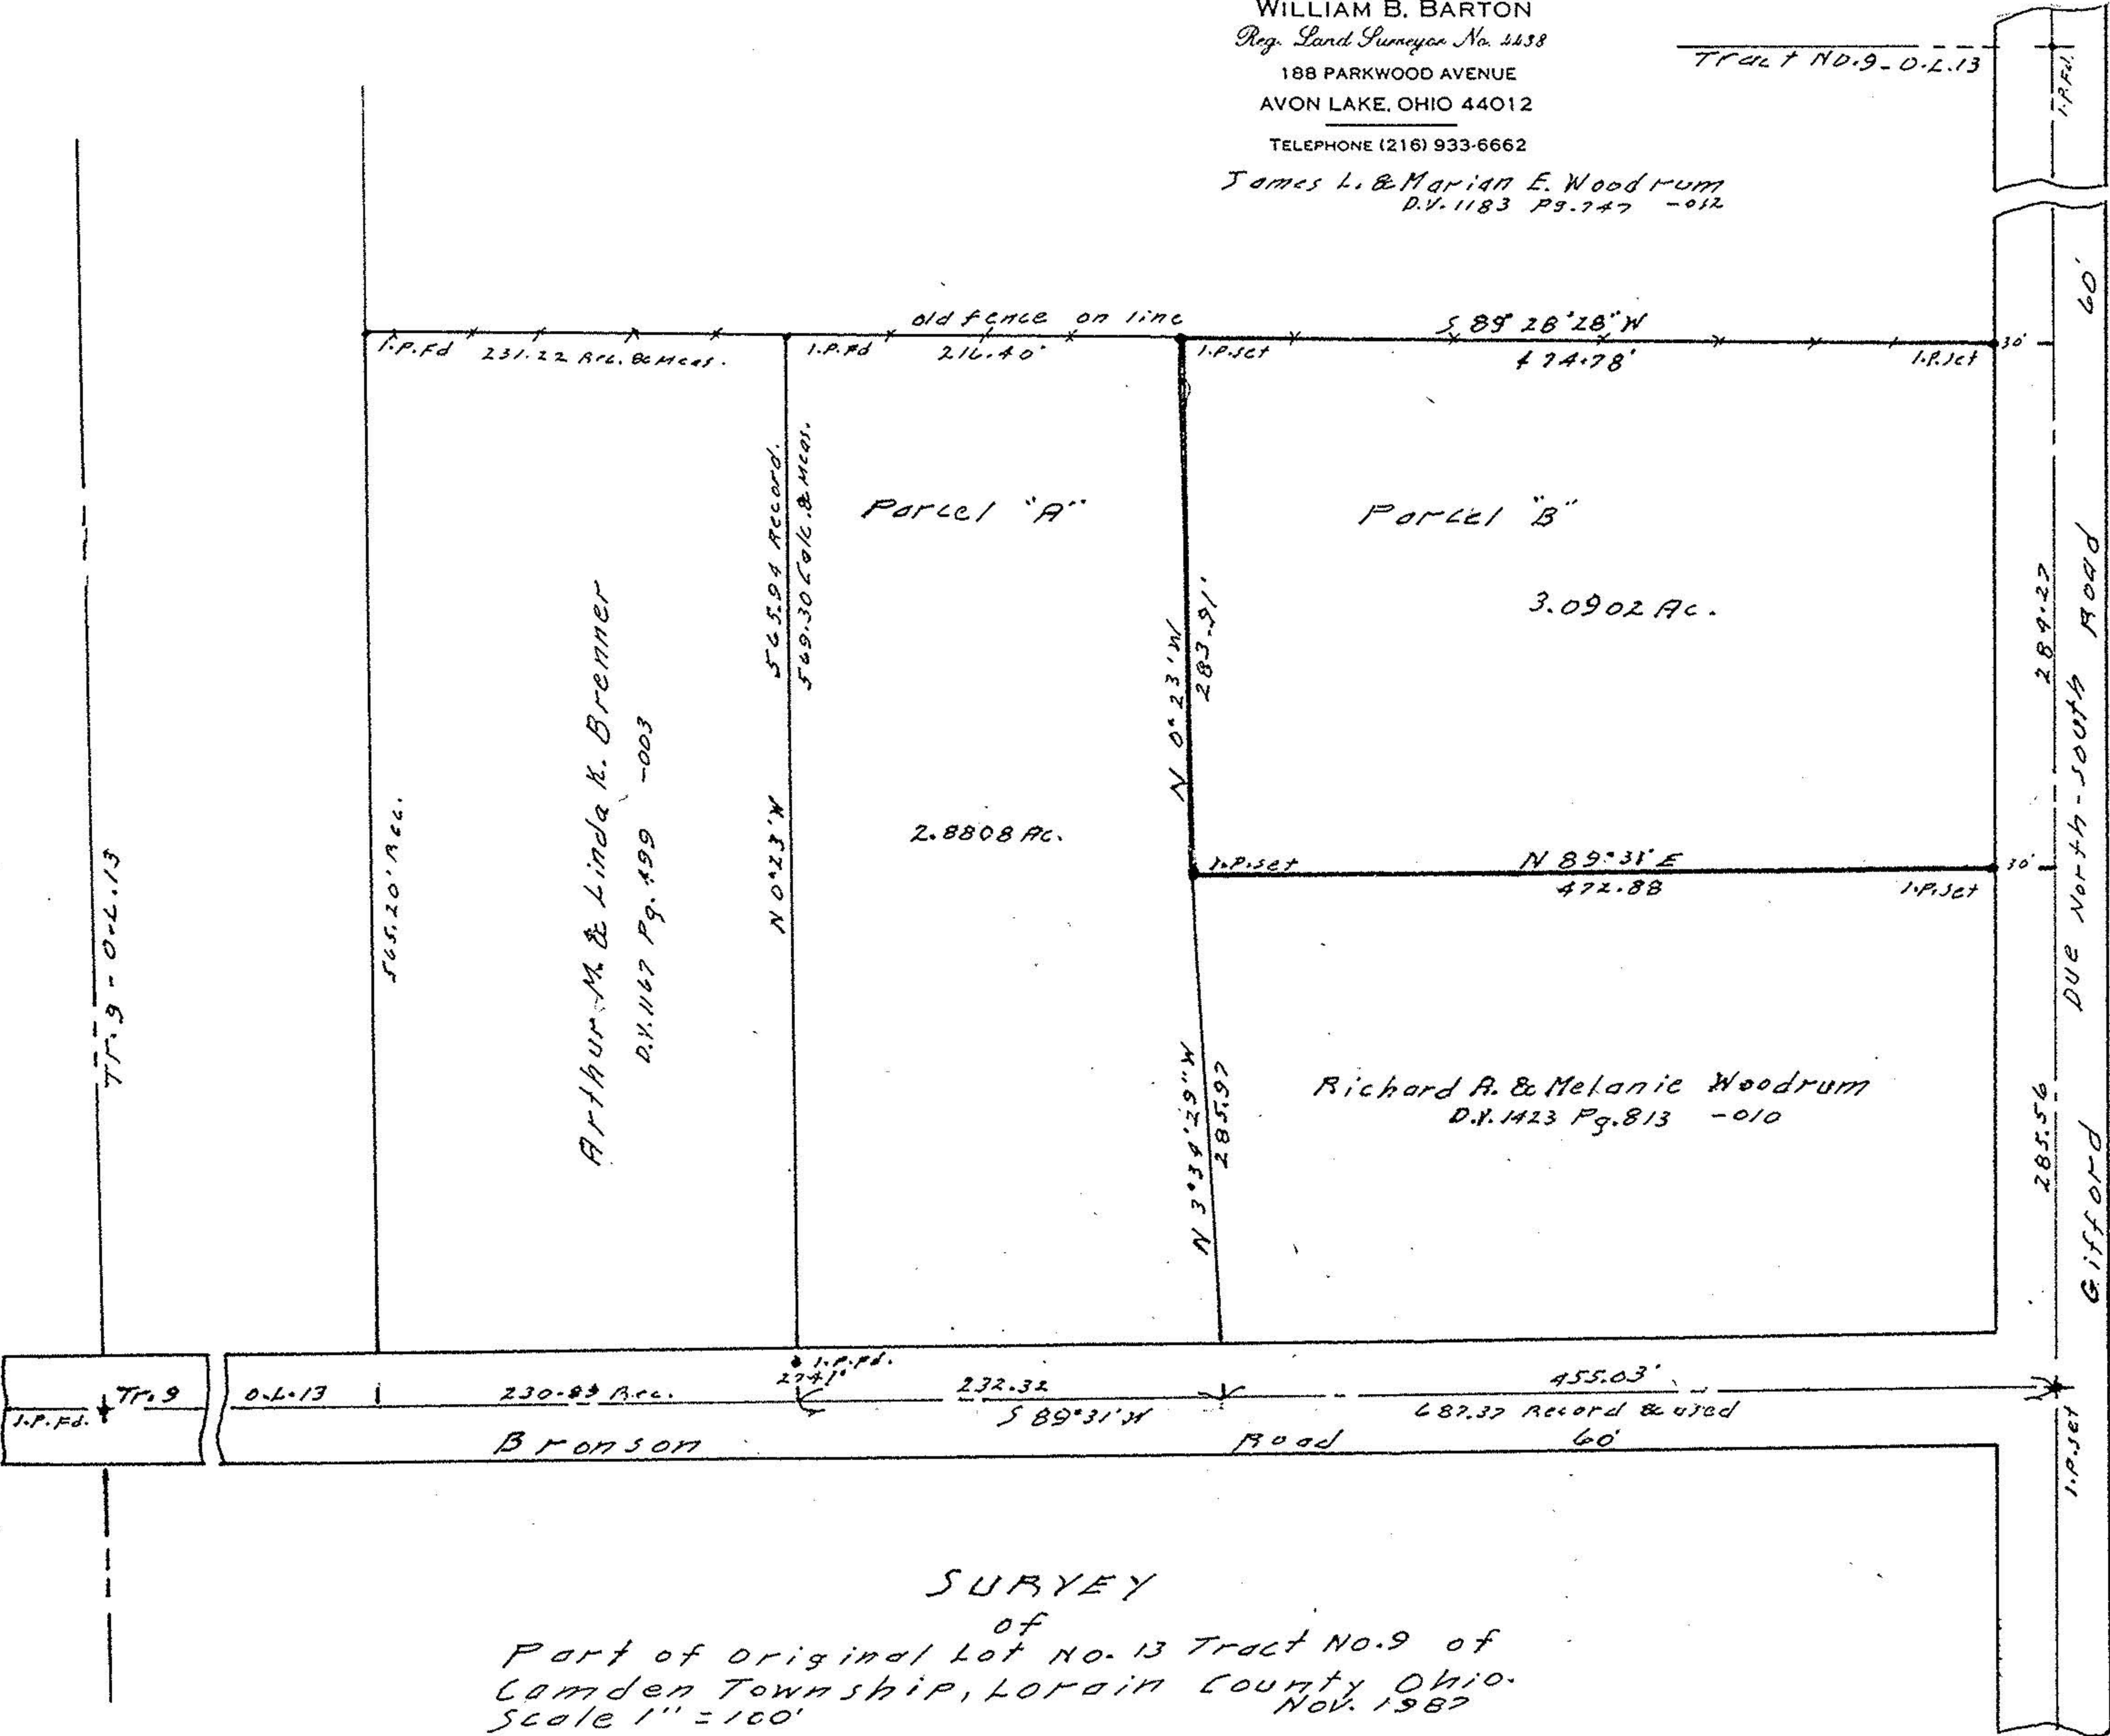

Survey made for Benjamin E. & Joyce Marie Bradner.
 D.V. 1069 Pg. 575 13-009-013-000-011

17801


APPROVED
 LORAIN CO.
 MAP DEPT.

DATE 12-16-87

PAGE 13-G

BY Carol

VOID AFTER 17801

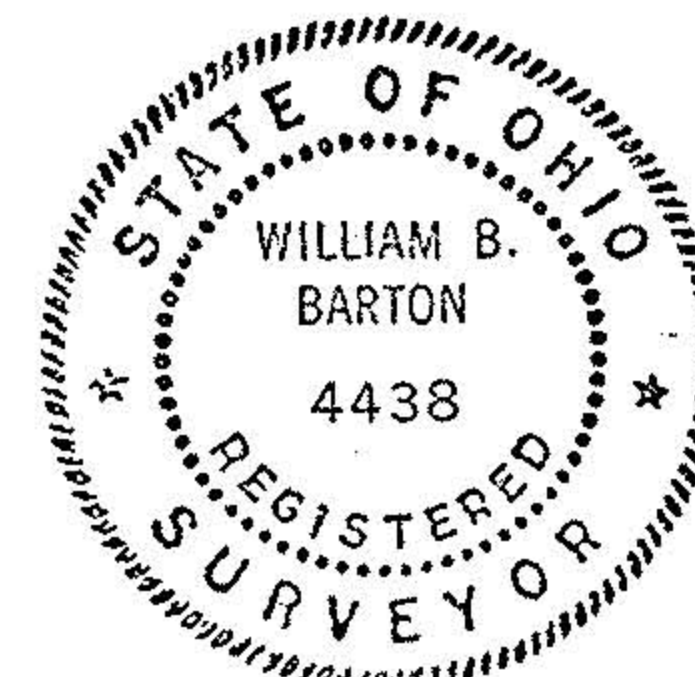

SURVEY
 of
 Part of Original Lot No. 13 Tract No. 9 of
 Camden Township, Lorain County Ohio.
 Scale 1" = 100'