


20473

APPROVED	
LORAIN CO.	
MAP DEPT.	
DATE 8-3-93	
PAGE 13	F
BY CAROLYN FRANCIS	
VOID AFTER POST #	20473

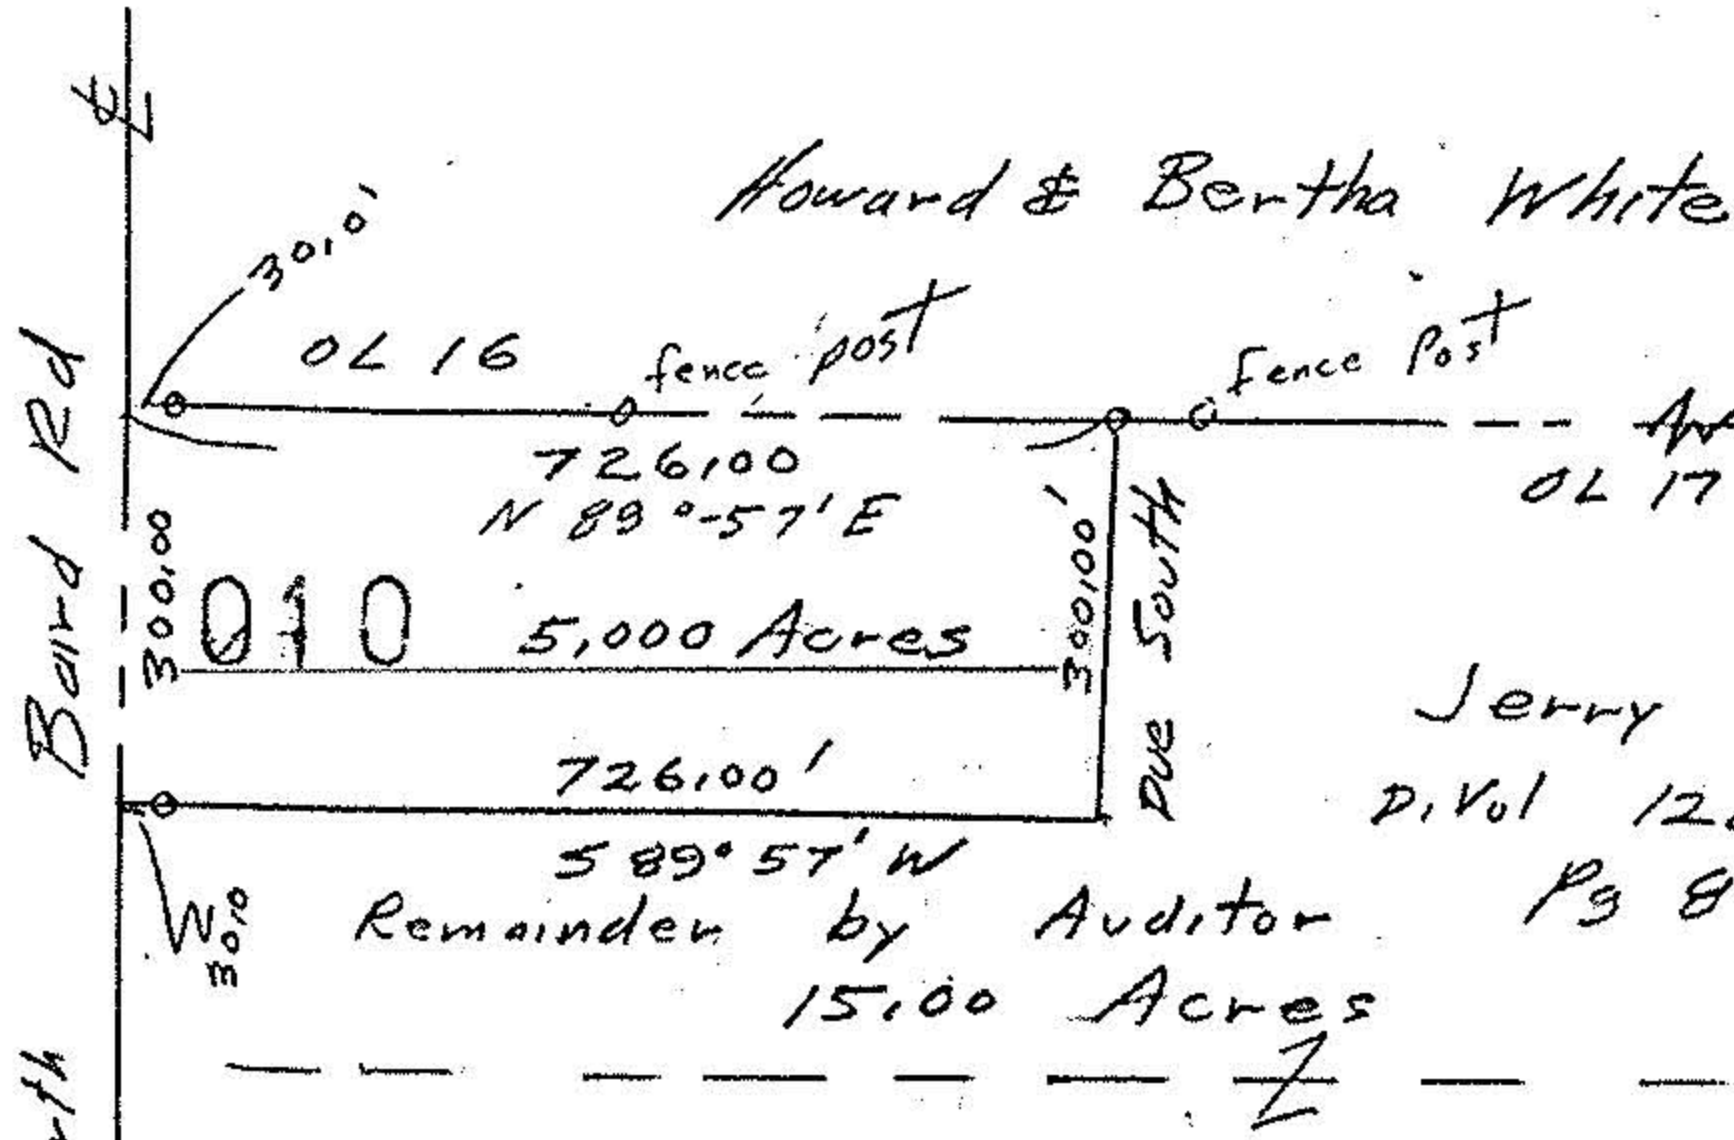

b.b. NO.

PAGE

SELL

DATE

John Poznywak  
Reg. Surveyor  
52192  
JOHN POZYWAK  
5292  
REGISTERED  
SURVEYOR

2002

Randy Messier SR  
OR 452 Pg 819

Dwight A & Elaine Holt  
OR 194 Pg

Survey of Parcel Split  
for  
Jerry L Anderson

- o iron pipes set
- iron pipes fd

ORIGINAL LOT 21 Tr 9 DATE June 15, 1993

TOWNSHIP Camden SCALE 1" = 300'

CITY OF \_\_\_\_\_ FIELD BOOK N/A

COUNTY OF Lorain DRAWN BY J. Poz

STATE OF OHIO CHECKED BY J. Poz

W. O. \_\_\_\_\_ FILE NO. 13-09-021-000-001

