
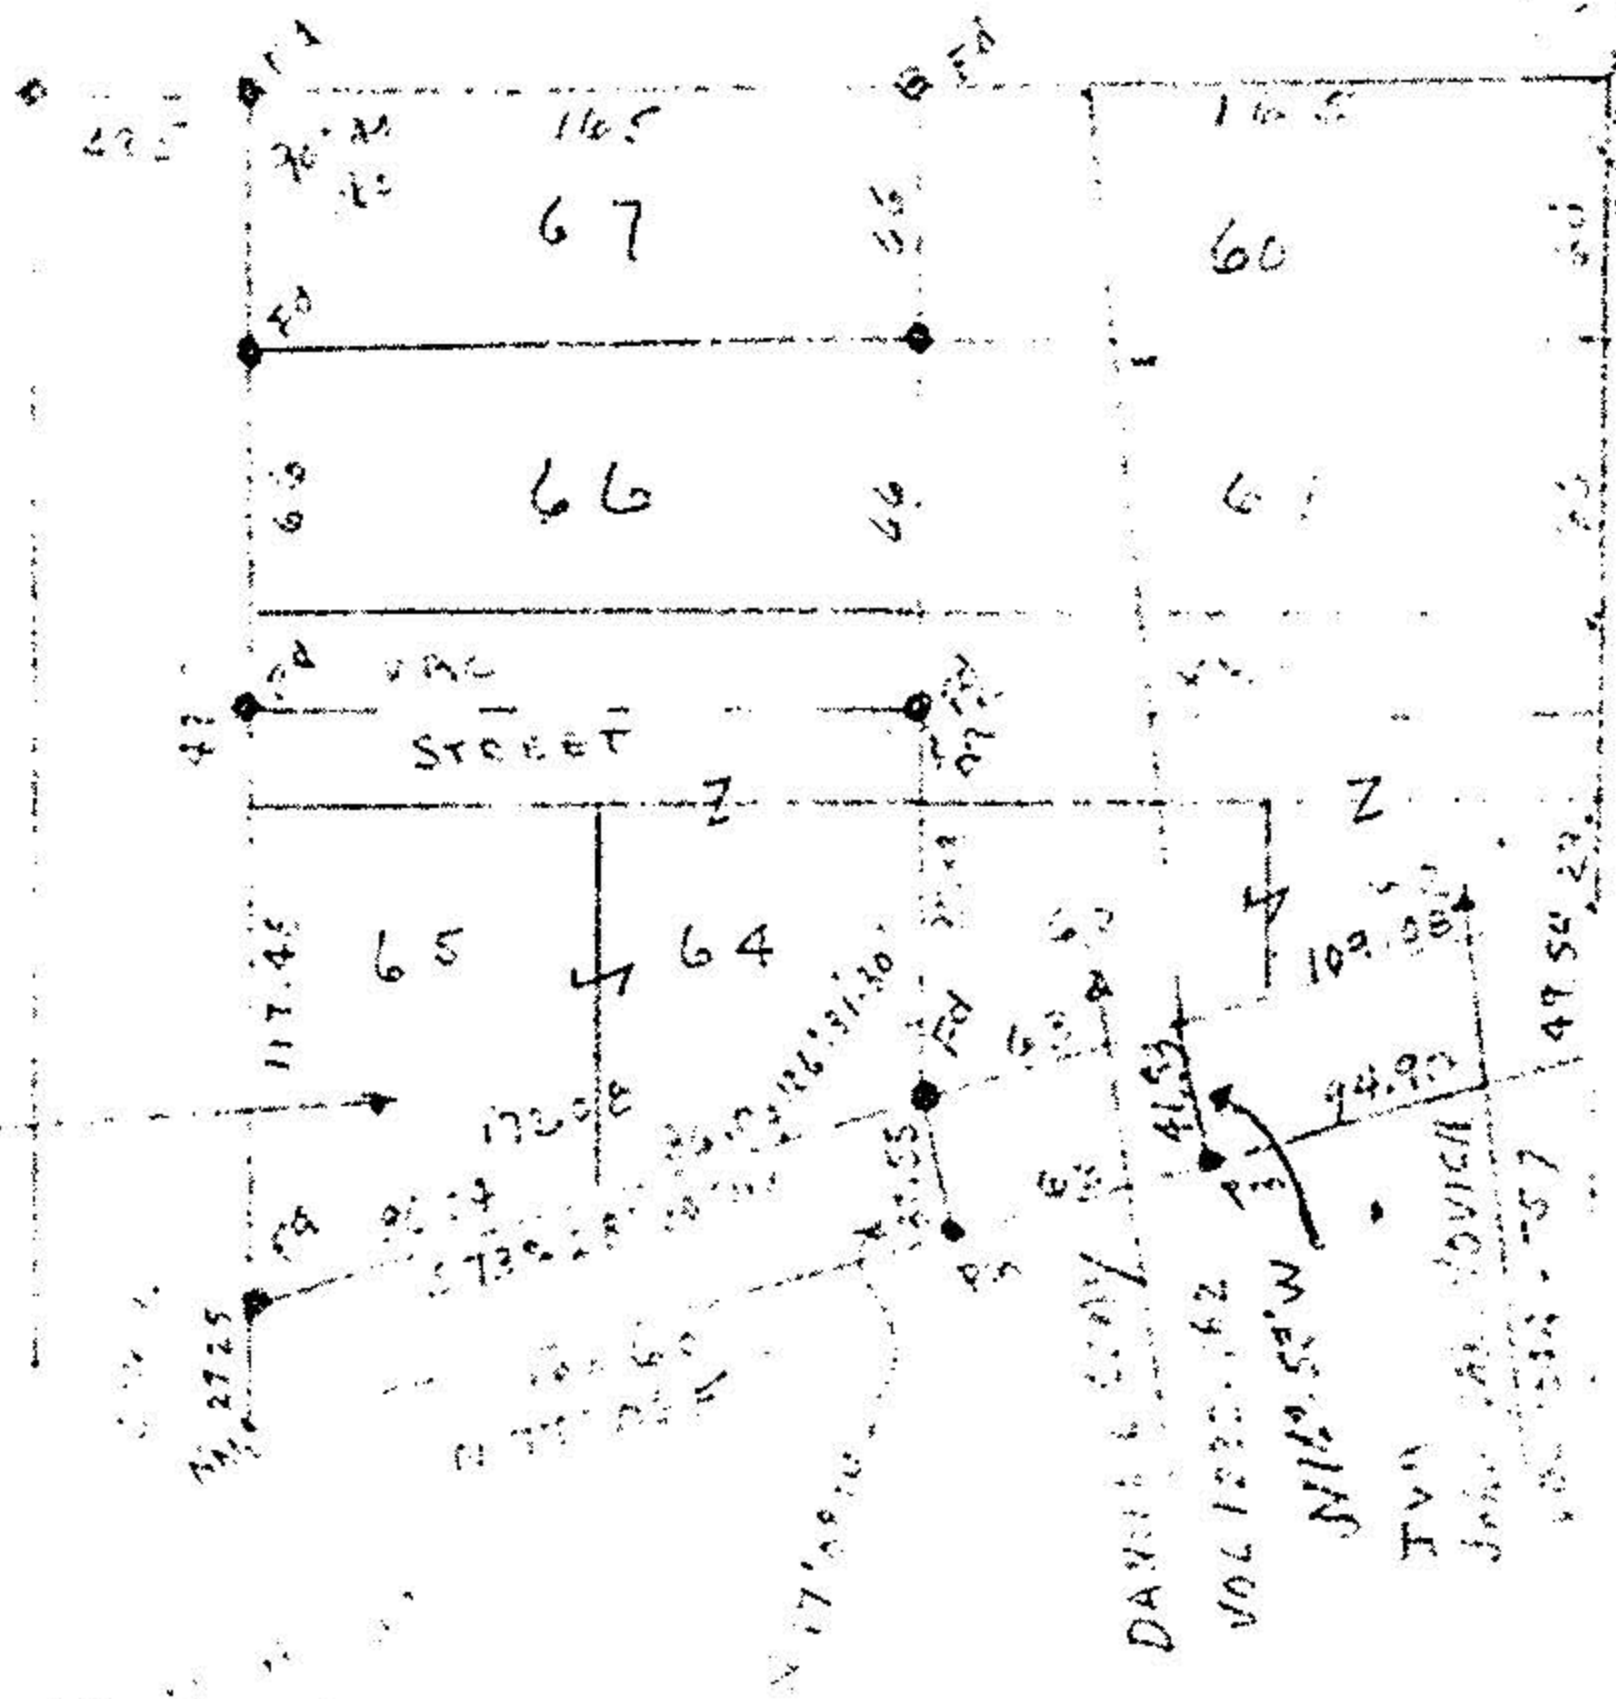


Map of Part of Lot 16 Tract 11 Village of Kipton, Twp. of Camden
 County of Lorain and State of Ohio
 Scale 1" = 100' Nov. 20, 1981
 By Arnold F. Koepp Reg. Surveyor

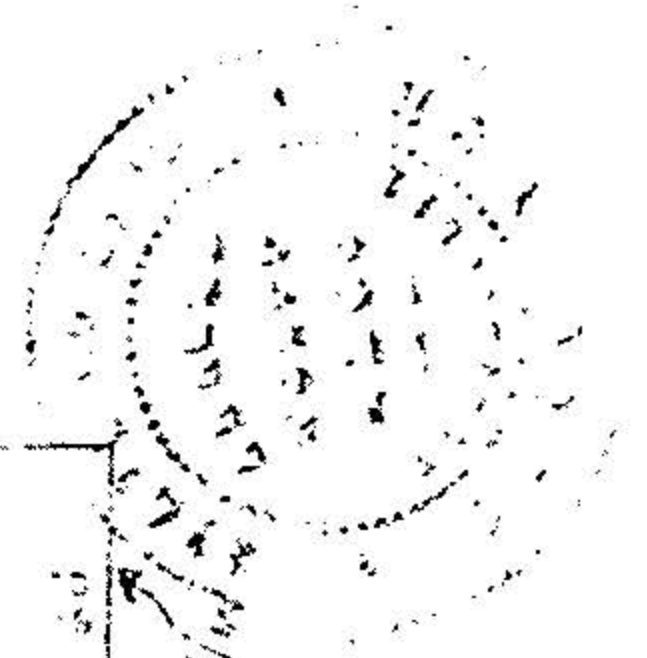

STATE OF OHIO

Part of Lot 16
 Tract 11 Village of Kipton
 Twp. of Camden

KIP TWP. E. 1/2 Sec. 11
 Vol. 13-11-016

#14641

APPROVED LORAIN CO. MAP DEPT.	
DATE	4-15-82
PAGE	13-11-016
BY	T. M. Main
VOID AFTER	