


NOTE: • indicates iron pin set
unless otherwise designated.

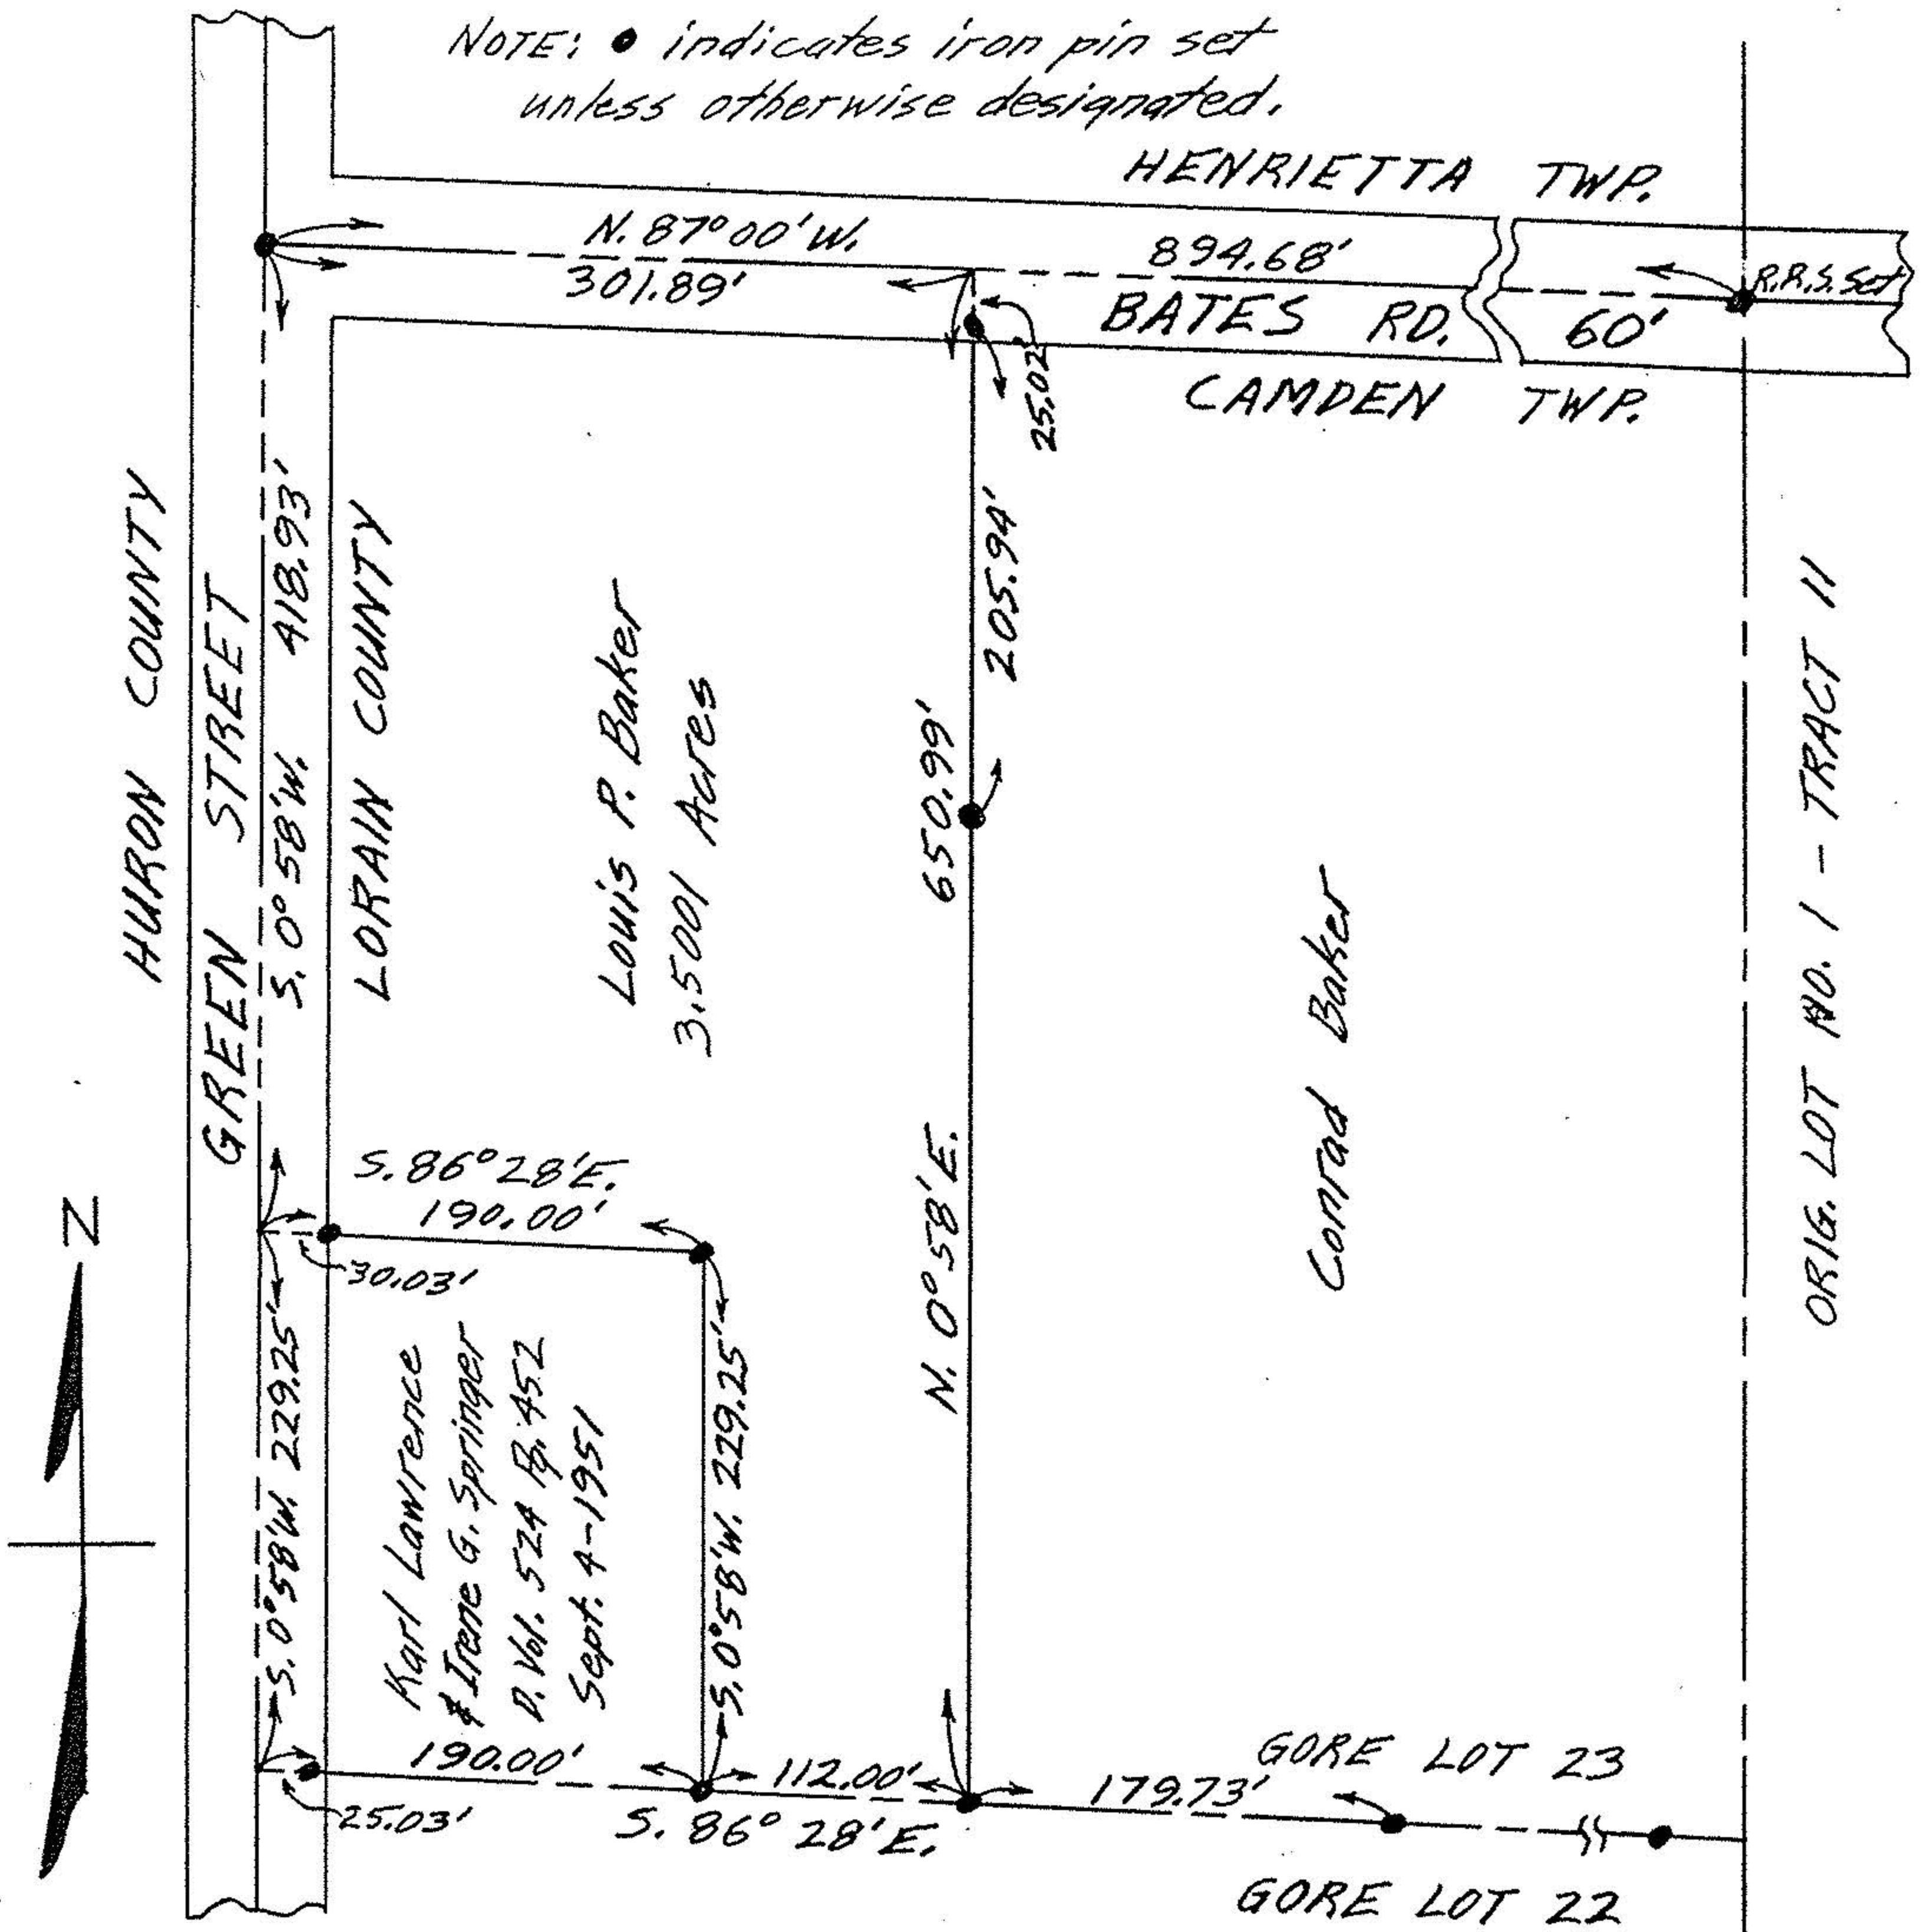

ORIG. LOT NO. 1 - TRACT 11

MAP OF SURVEY FOR CONRAD BAKER
CAMDEN TOWNSHIP