

14-E 19047 14-00-11-000




LAUNDON . SIMON . CAHL & ASSOC. INC.
CONSULTING ENGINEERS & SURVEYORS
219 COURT ST. ELYRIA, OHIO 44035

SURVEY FOR:

BRILL VIEW FARMS INC.

Orig. Lot 111	City of	Date APR. 18, '89 Scale 1"=100'
Orig. Sec	Village of	Dwn. by R.G.S. Chkd. by C.J.
Tract	County of LORAIN	Job No. 89-1808 B F.B.
Township of PITTSFIELD	State of OHIO	Printed

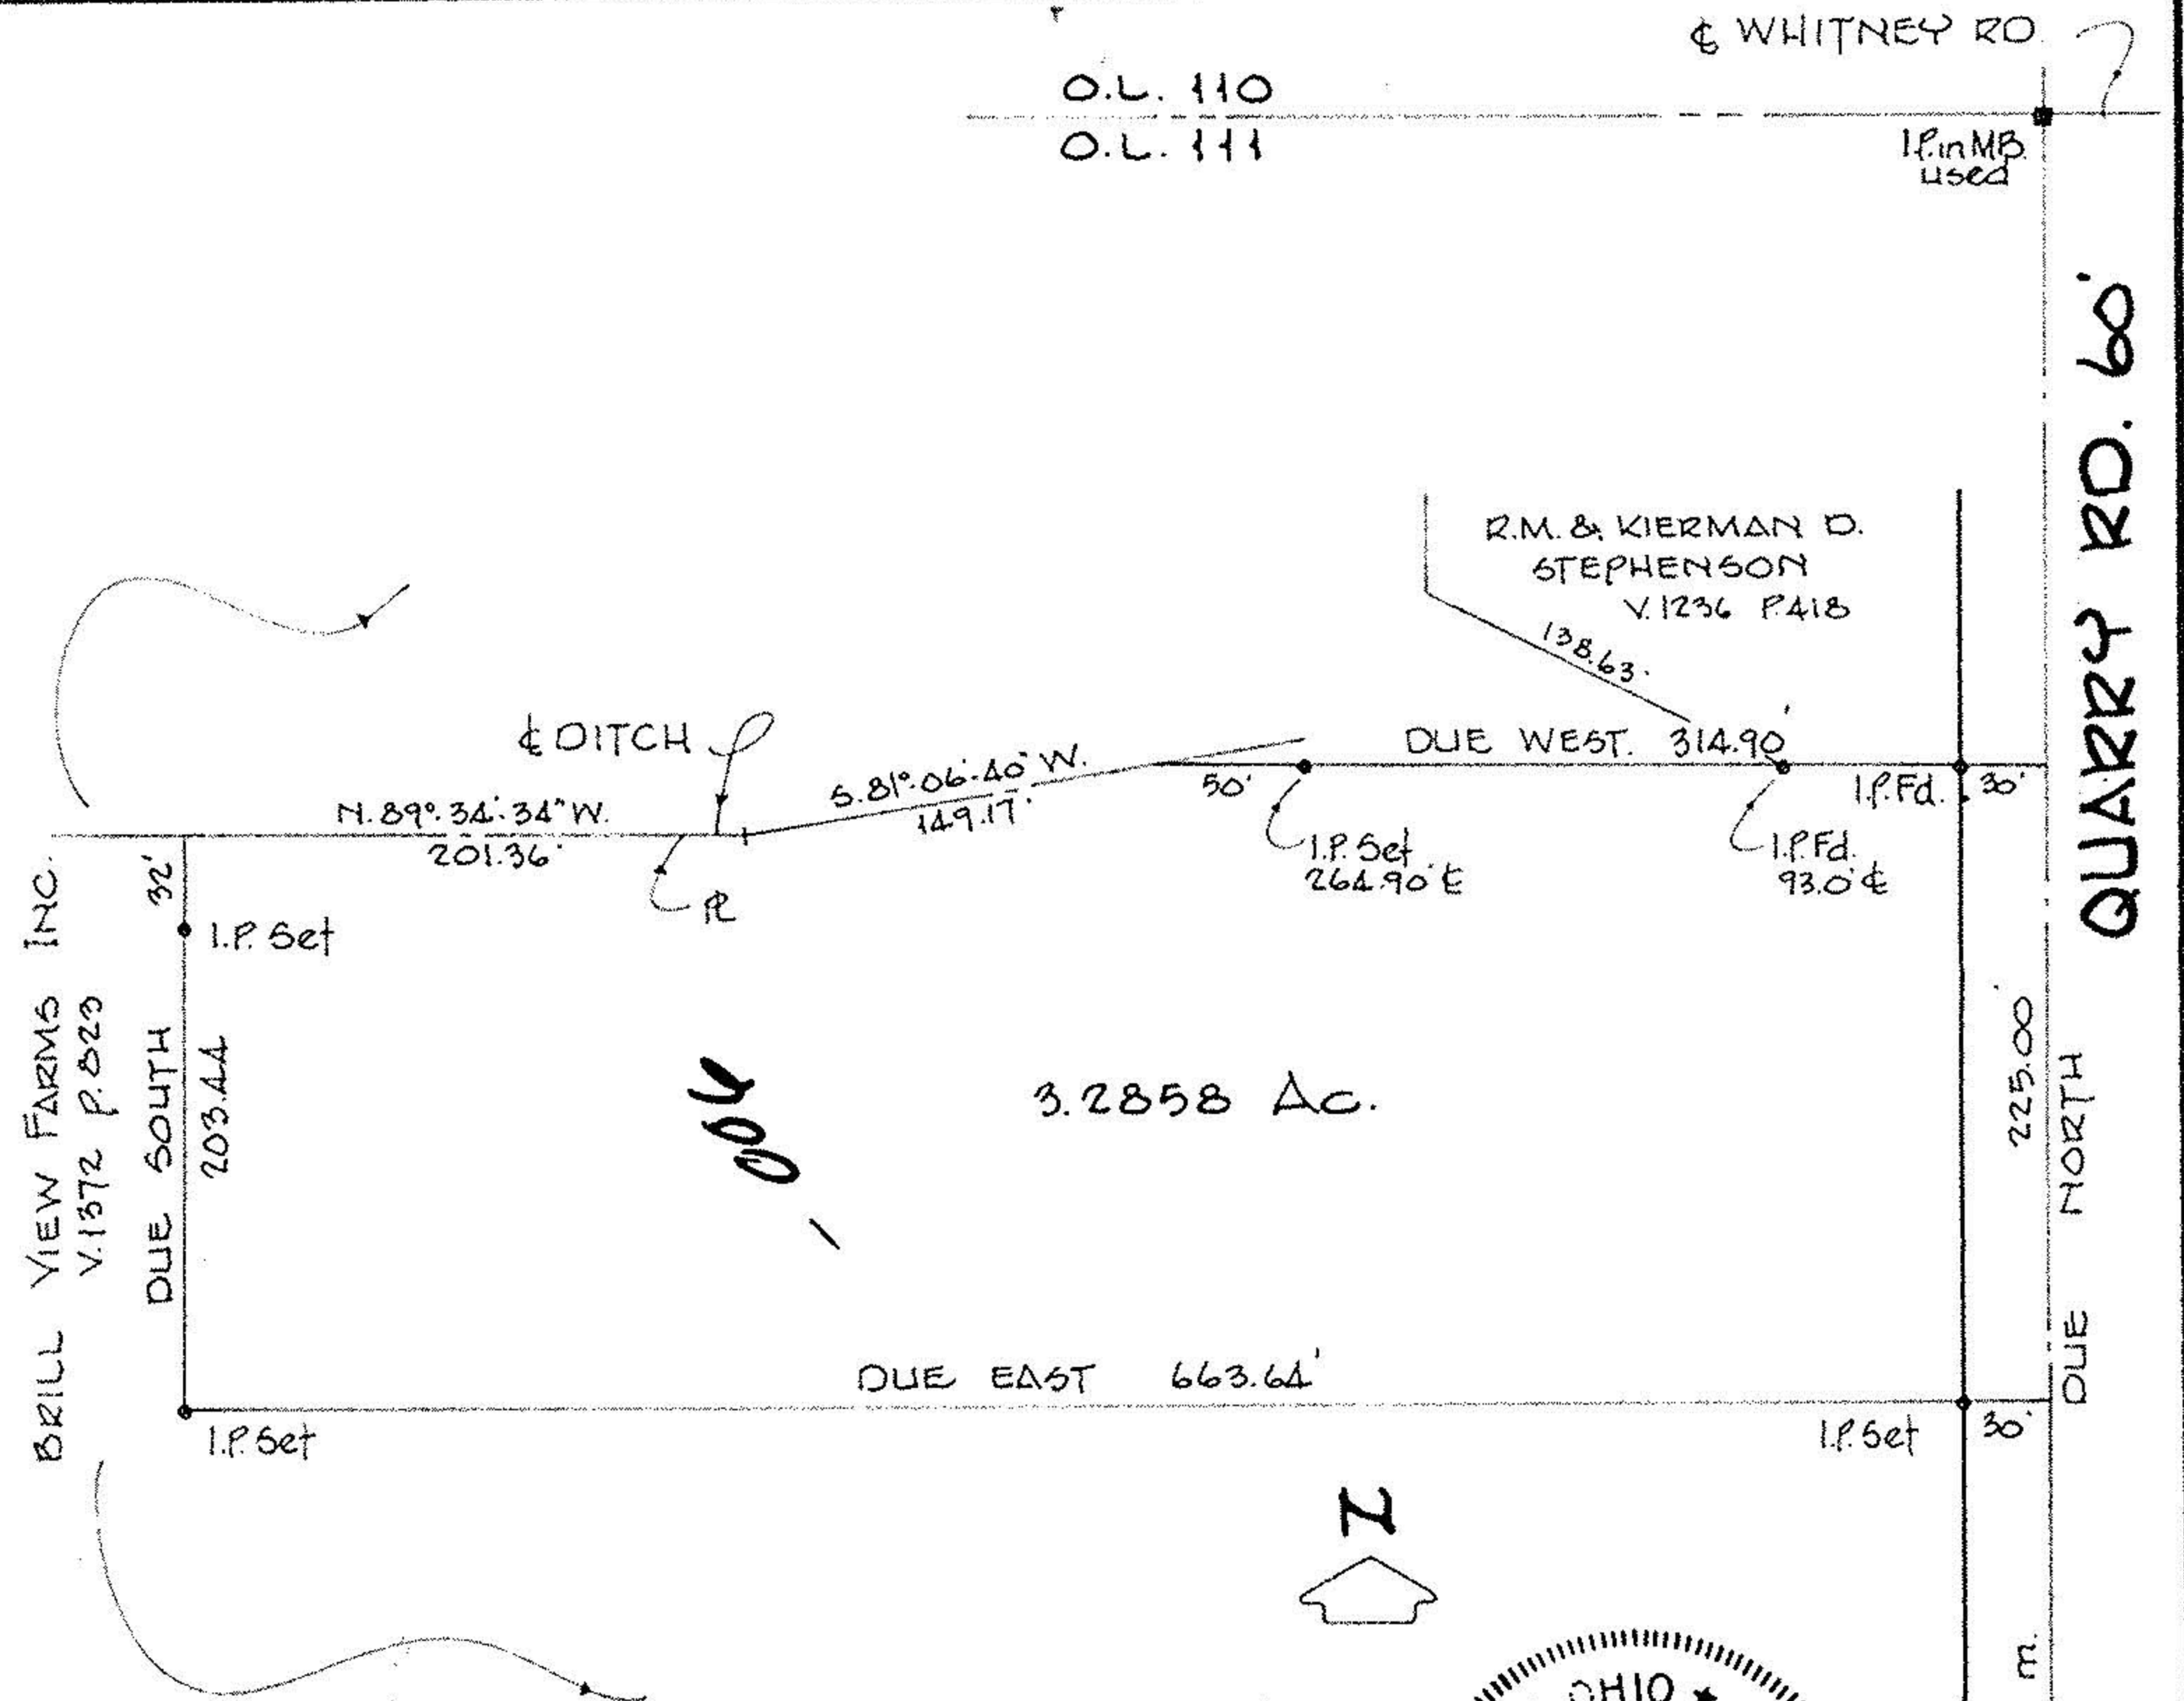

BRILL VIEW FARMS INC.
V.1372 P.823

#19047

APPROVED
LORAIN CO.
MAP DEPT.

DATE 7-24-90

PAGE 14-E

BY CAROLYN
FRANCIS

VOID
AFTER # 19047



O.L. 111
O.L. 130

QUARRY RD. 60'

DUE NORTH

225.00

491.40 m

1 P. in MB used

1 P. in MB used