

WILLIAM B. BARTON
REG. LAND SURVEYOR NO. 4438
188 PARKWOOD AVENUE
AVON LAKE, OHIO 44012
TELEPHONE (216) 933-6662

14-00-134-000

16504

o.l. 134

Pitts Road 60'

Due North-South 926.00'

o.l. 133
o.l. 134

30.01


1390.00'
764.00'

30.04

283.55'

30.01

636.95'

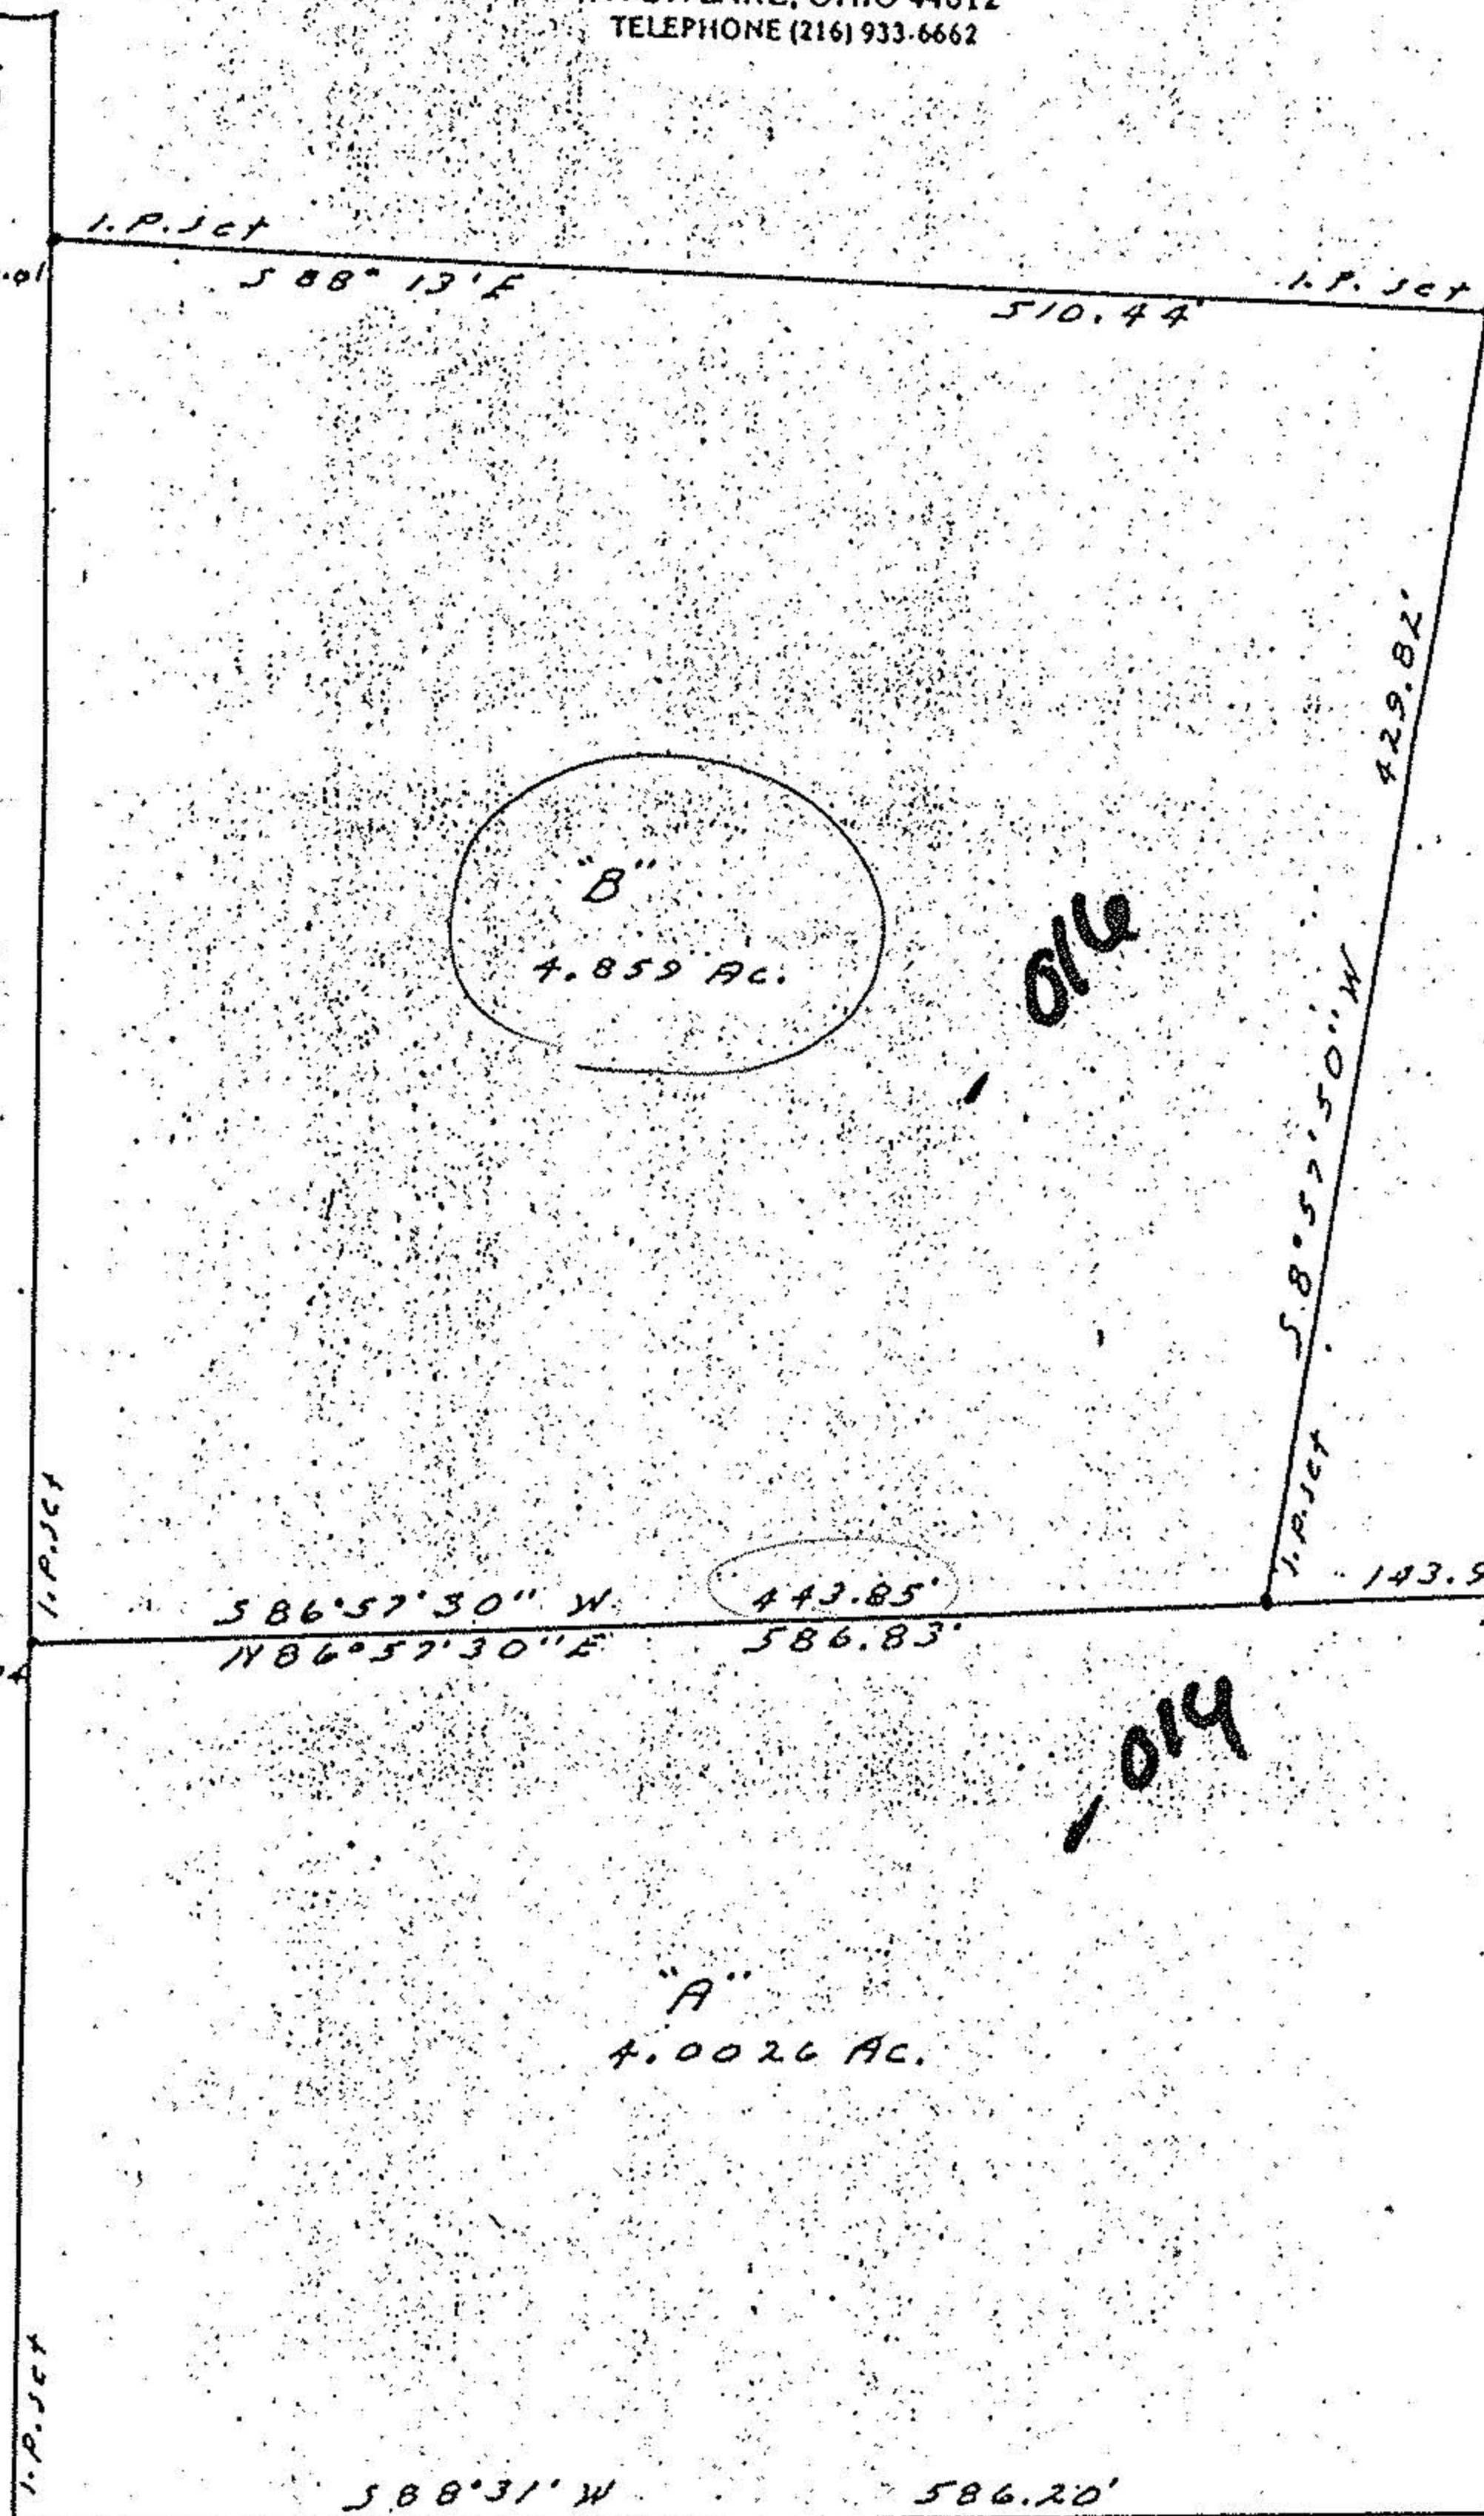

#16364
APPROVED
LORAIN CO.
MAP DEPT.

DATE 9-11-85

PAGE 14-F


BY T. McHair

VOID

SURVEY OF
Part of Original Lot No. 134
Pittsfield Township Lorain Co.
Ohio. Scale 1"=100'. Feb. 21, 1985.

A.R.S. Ed. o.l. 134
o.l. 147

Merriam Rd. 60'

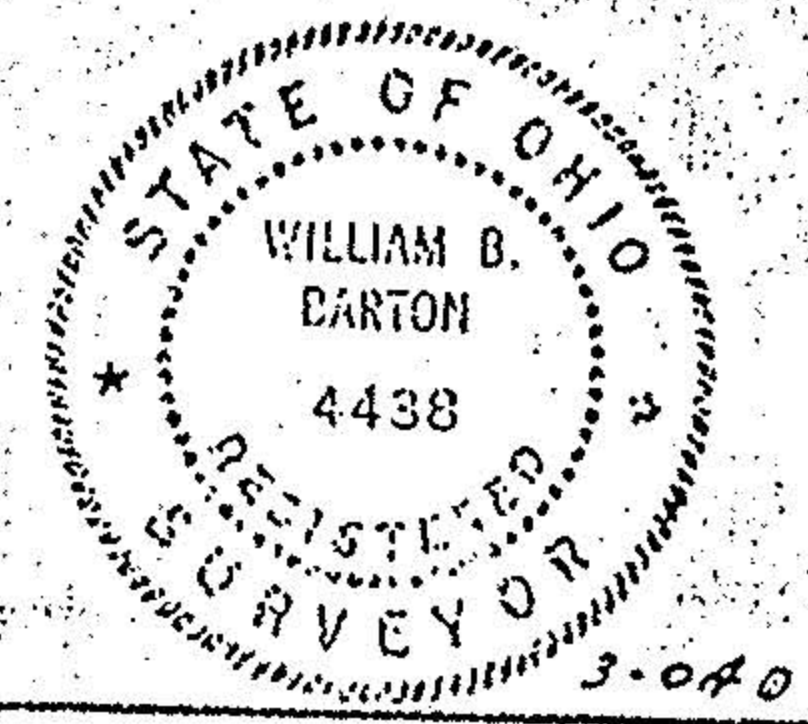

Brill View Farms Inc. D.V. 1348 Pg. 339