


HAROLD L. & LUCILLE E. HAYES

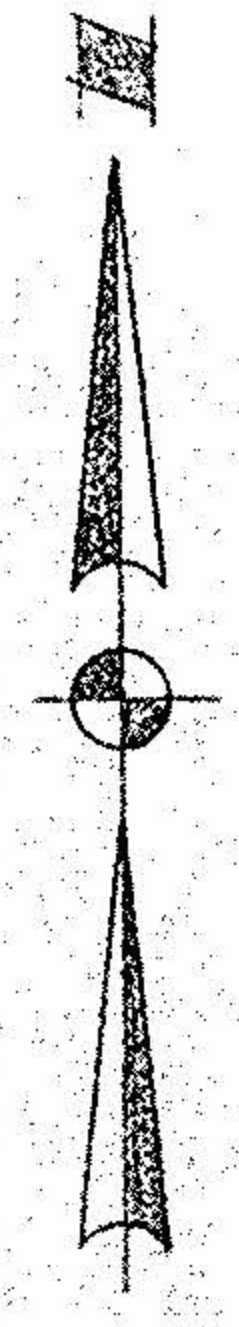

HAROLD L. & LUCILLE E. HAYES

O.L. 152
O.L. 153
I.P. Fd.
I.P. Set

S. 88° 17' 55" E.
646.20'

I.P. Set
S. 55° 37' 35" E.
100.78'

14-00-148-000-006

7.9164 Ac.

14-F

473.09'

747.44'

N. 3° 33' 45" E.
747.44'

I.P. Fd. S. 87° 00' 10" E. 380.92' rec. I.P. Fd. I.P. Fd.
132.68' 218.24'

RALPH A. HAYES
1-8-73 D.V. 1100 PG. 512
2.3586 Ac.

201.69 rec.
S. 3° 57' W.
ROAD

N. 88° 16' W. 735.78'

144.17'
S. 3° 18' 20" W.
I.P. Fd.

274.62'
S. 3° 04' 20" W.
I.P. Fd.

S. 87° 00' 10" E. 337.44' rec. I.P. Fd.

0.7119 Ac.

-010
4.6690 Ac.

14
O.L. 148

274.35'

100.08'
I.P. Fd.

S. 87° 00' 10" E. 282.25' rec. I.P. Fd.

GAIL S. & SANDRA BIDLAKE
D.V. 821 PG. 103
1.01 Ac.

114.38'
S. 37° 19' rec. 83.91'
PITTSFIELD

O.L. 148
O.L. 147

S. 3° 04' 20" W. 277.82'
177.74 m.
174.92' rec.
I.P. Fd.

185.74 rec. I.P. Fd.

O.L. 148
O.L. 153
I.P.

738.05'
N. 87° 59' 30" W.

SURVEY FOR HAROLD L. & LUCILLE E. HAYES
PART OF O.L. 148
COUNTY OF LORAIN
SCALE 1" = 60'
LAUNDON • SIMON • CAHL & ASSOC.
ENGINEERS SURVEYORS
PITTSFIELD TWP.
STATE OF OHIO
JULY, 1974
JOB 74-305

BEARINGS SHOWN USED
TO DESCRIBE ANGLES ONLY

14-F
9771
04 14-F