

14-F

14699

14-00-153-000-015

INTERSECTION OF PITTS RD.
OF THE NORTH LINE OF LOT 153

NORTH LINE
OF LOT 153

PLAT OF SURVEY
FOR
JOE BARTISH



PART OF ORIGINAL LOT 153
PITTSFIELD TOWNSHIP
LORAIN COUNTY OHIO

E. OF PITTS RD.

NORTH

002

70.50 A

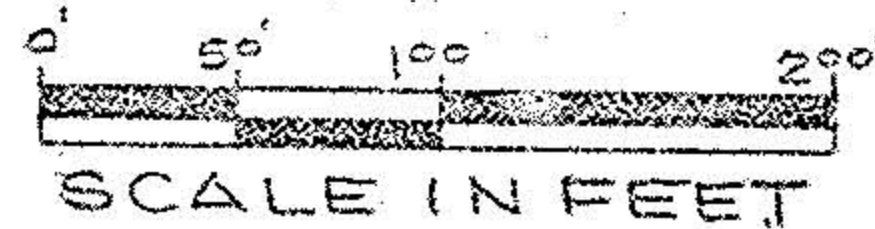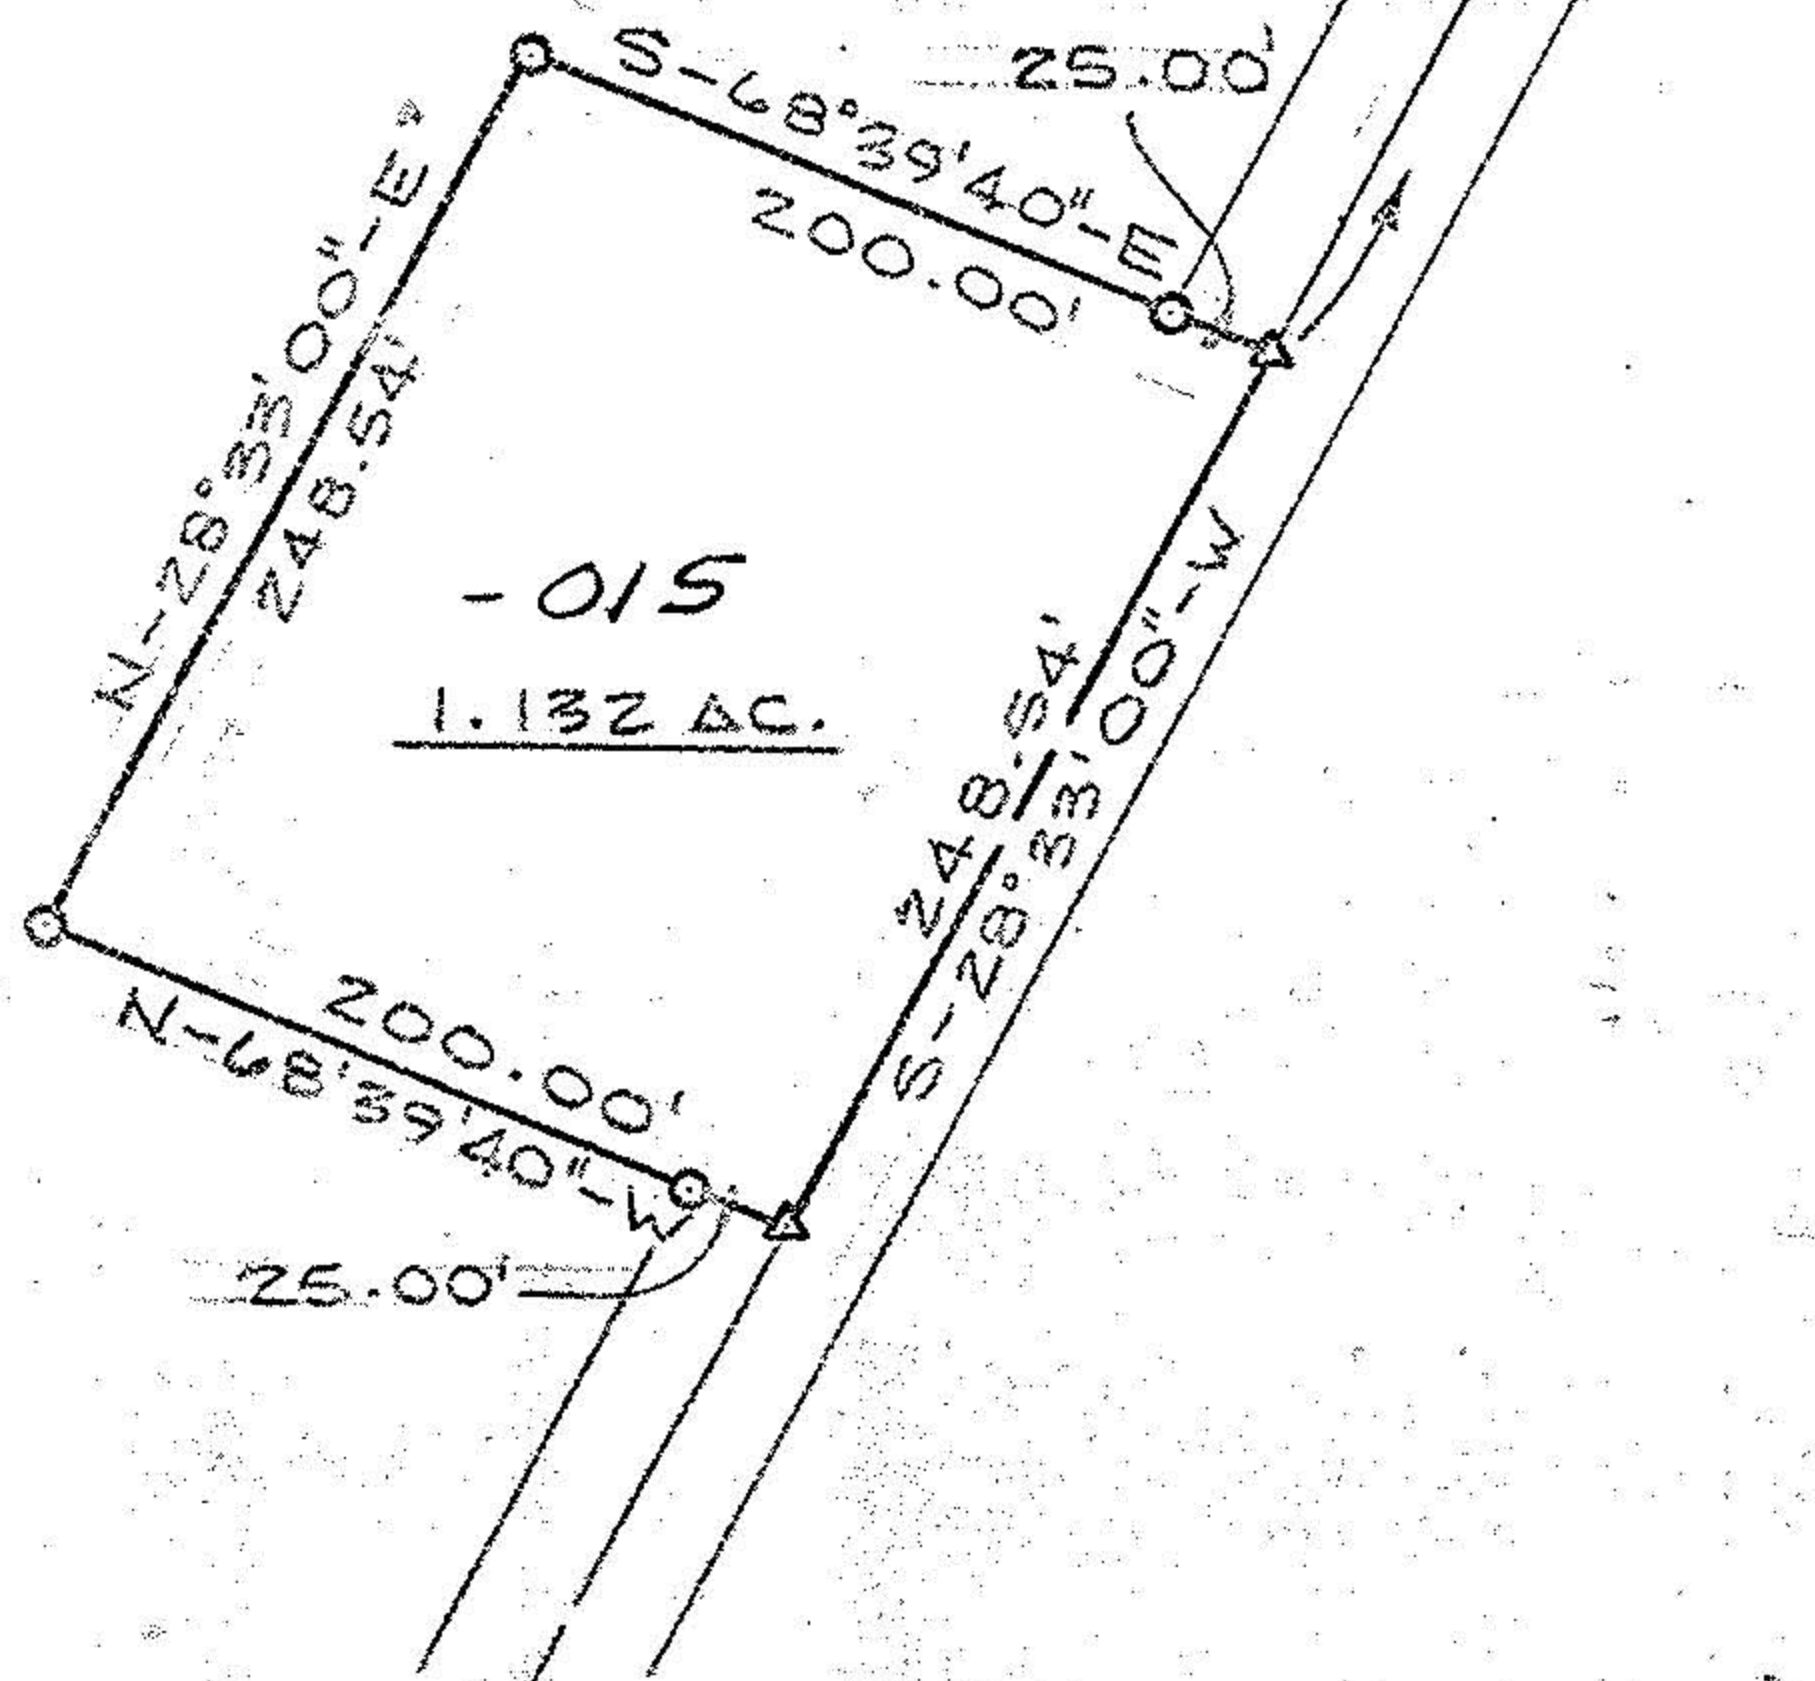

GRINDLE AND BENDER
ARCHITECTURE - ENGINEERING - SURVEYING
P.O. BOX 660, ASHLAND, OHIO

I hereby certify this plat to be a true delineation of a field survey made by the office of Grindle and Bender, and John F. Kerr and that all monuments were found or set as shown.

John F. Kerr
Registered Surveyor No. 6559
John F. Kerr

LEGEND:
O IRON PIN SET
Δ R/R SPIKE SET

