


Map of Part of Lot 21 and 34 Tract 9 Camden Twp. Lorain Co. Ohio
 MAY 2, 1979
 By Arnold F. Koeppe Reg. Surveyor No. 4306
 Map and survey revised June 28, 1988

000-20-60-21-80081-3-1

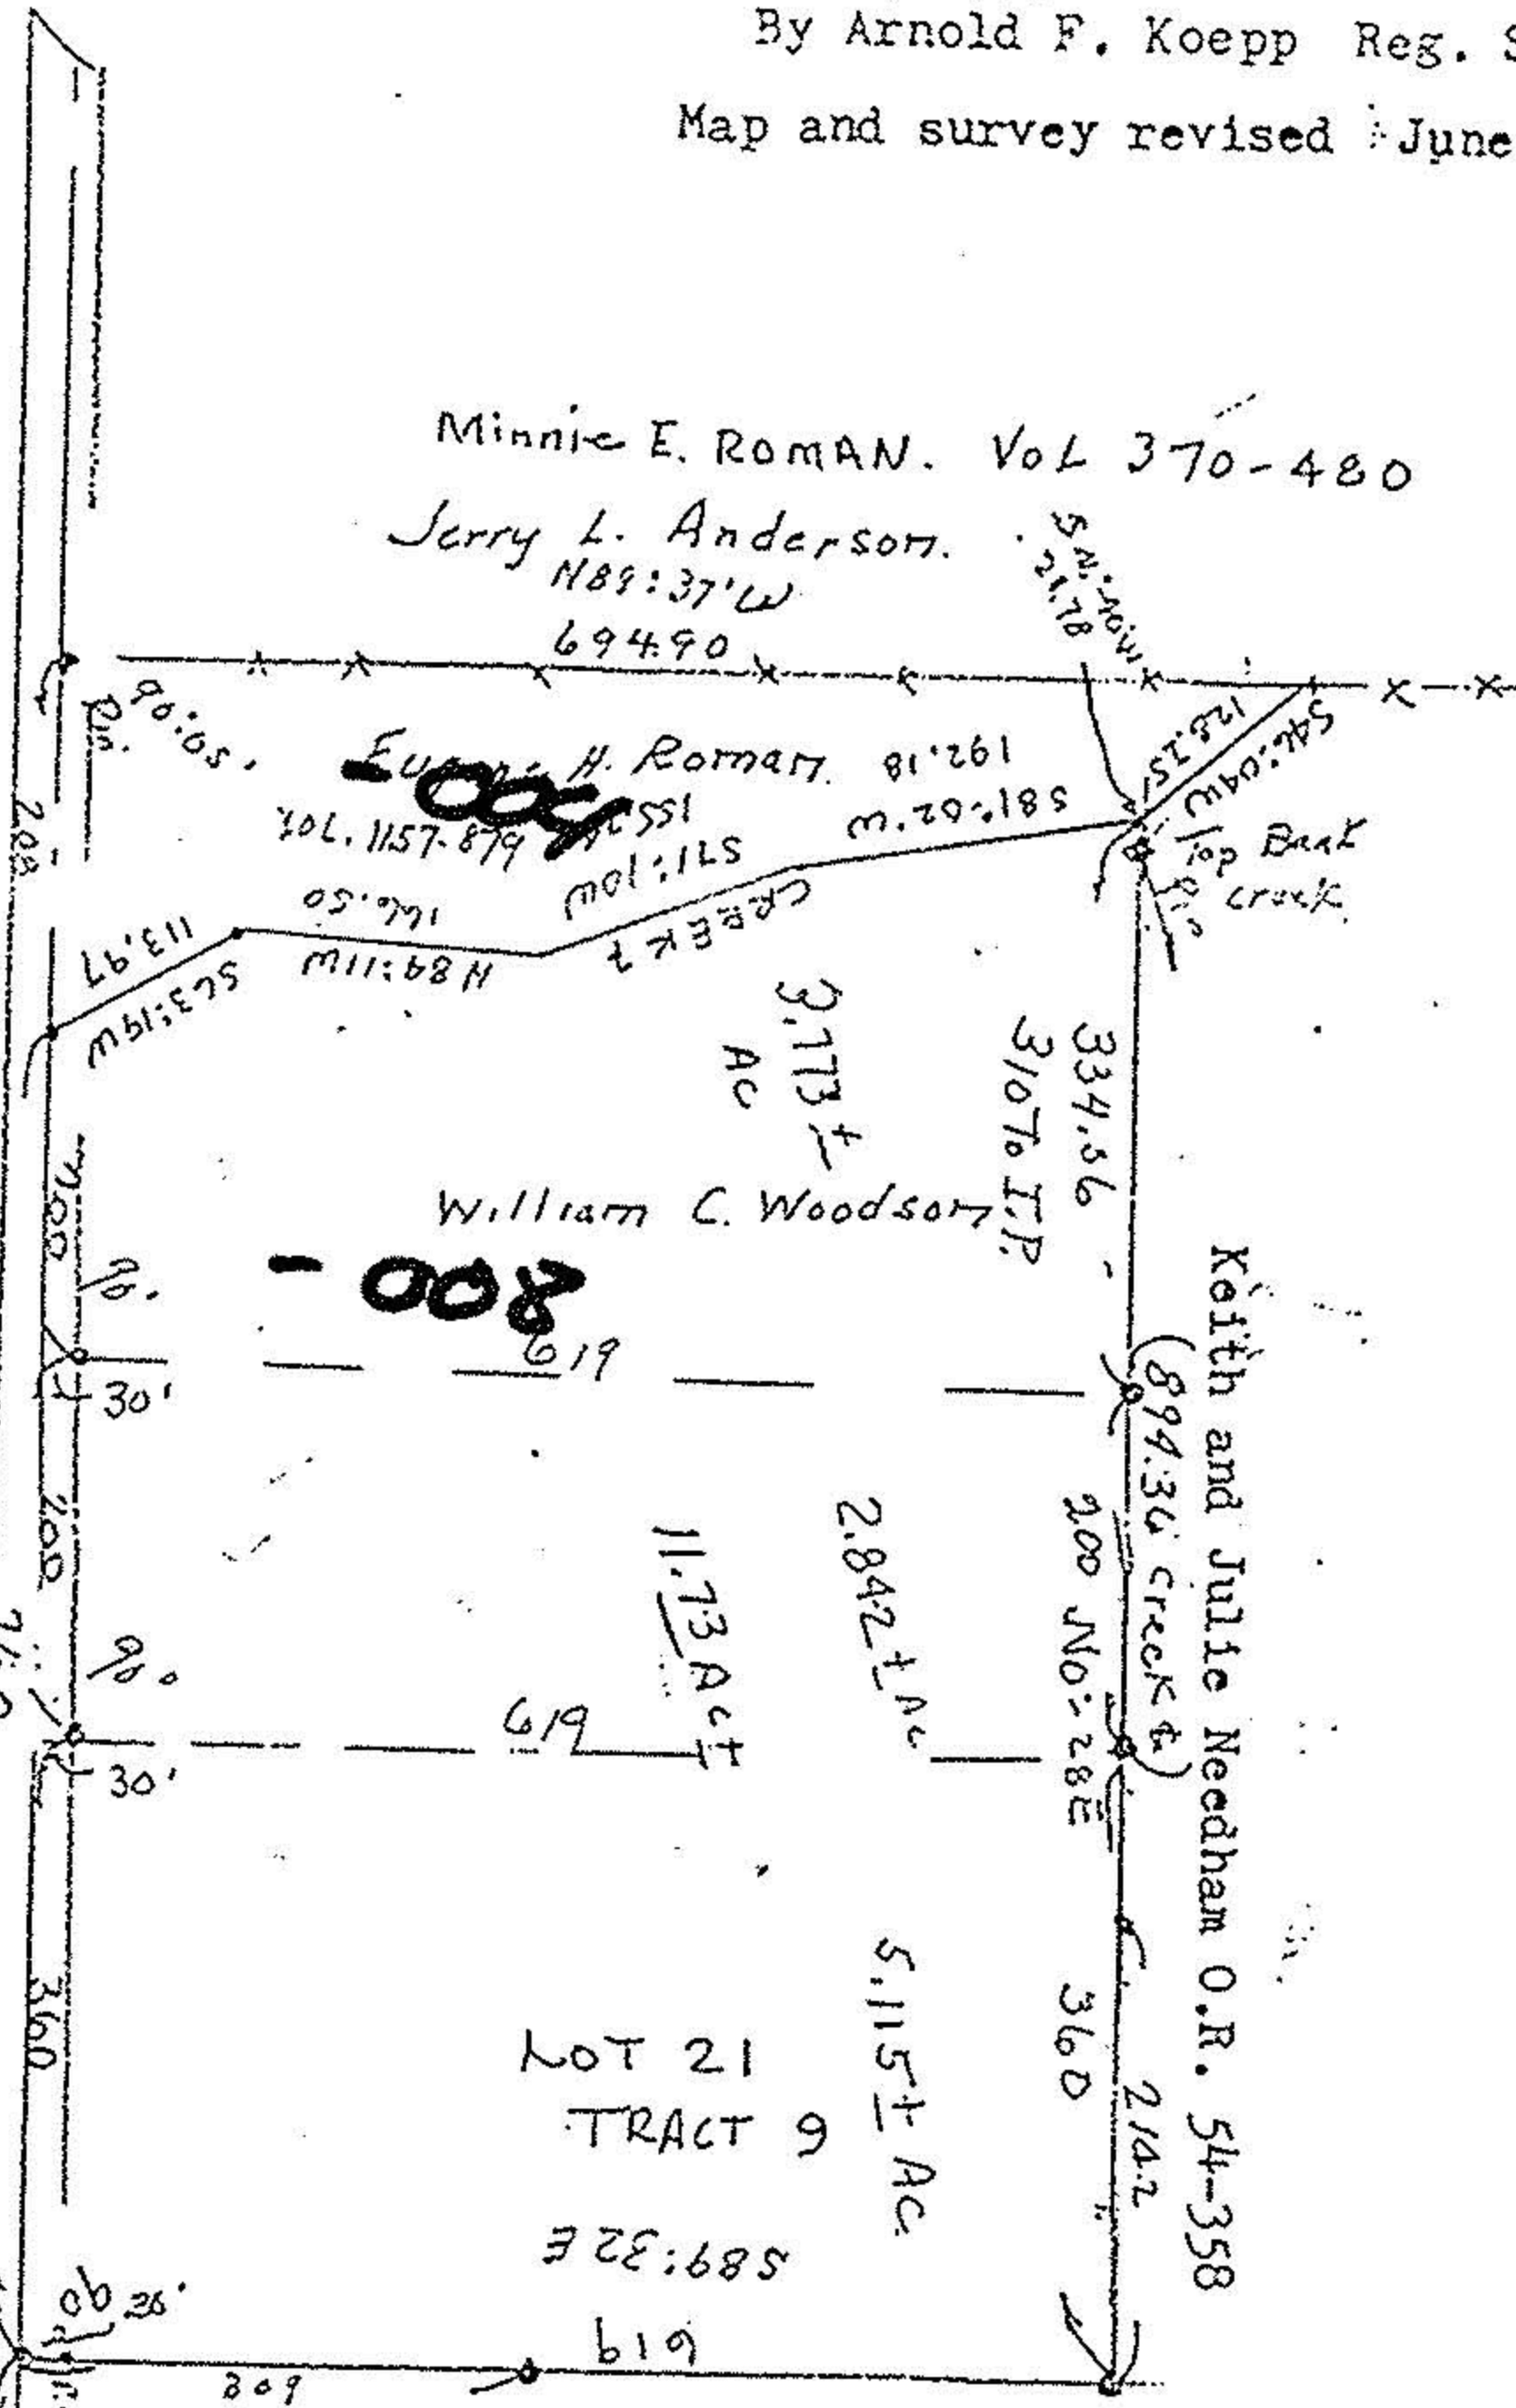

Scale 1" 200'

Keith and Julie Needham O.R. 54 Page 358
 Lot 34 TRACT 9

#18068

APPROVED LORAIN CO. MAP DEPT.	
DATE 8-4-88	
PAGE 13-F	
BY C. FRANCIS	
VOID AFTER #	18068

ARNOLD &
 CHDY HARDWER

1808± TO LOT LINE
 2063±